
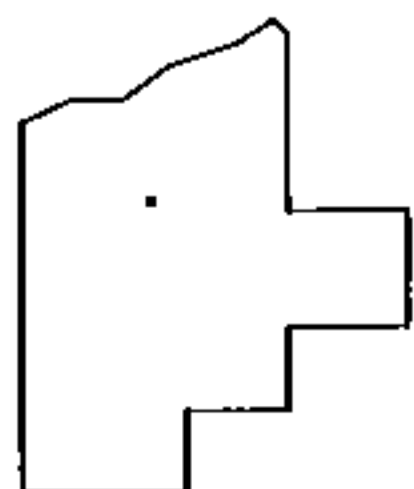
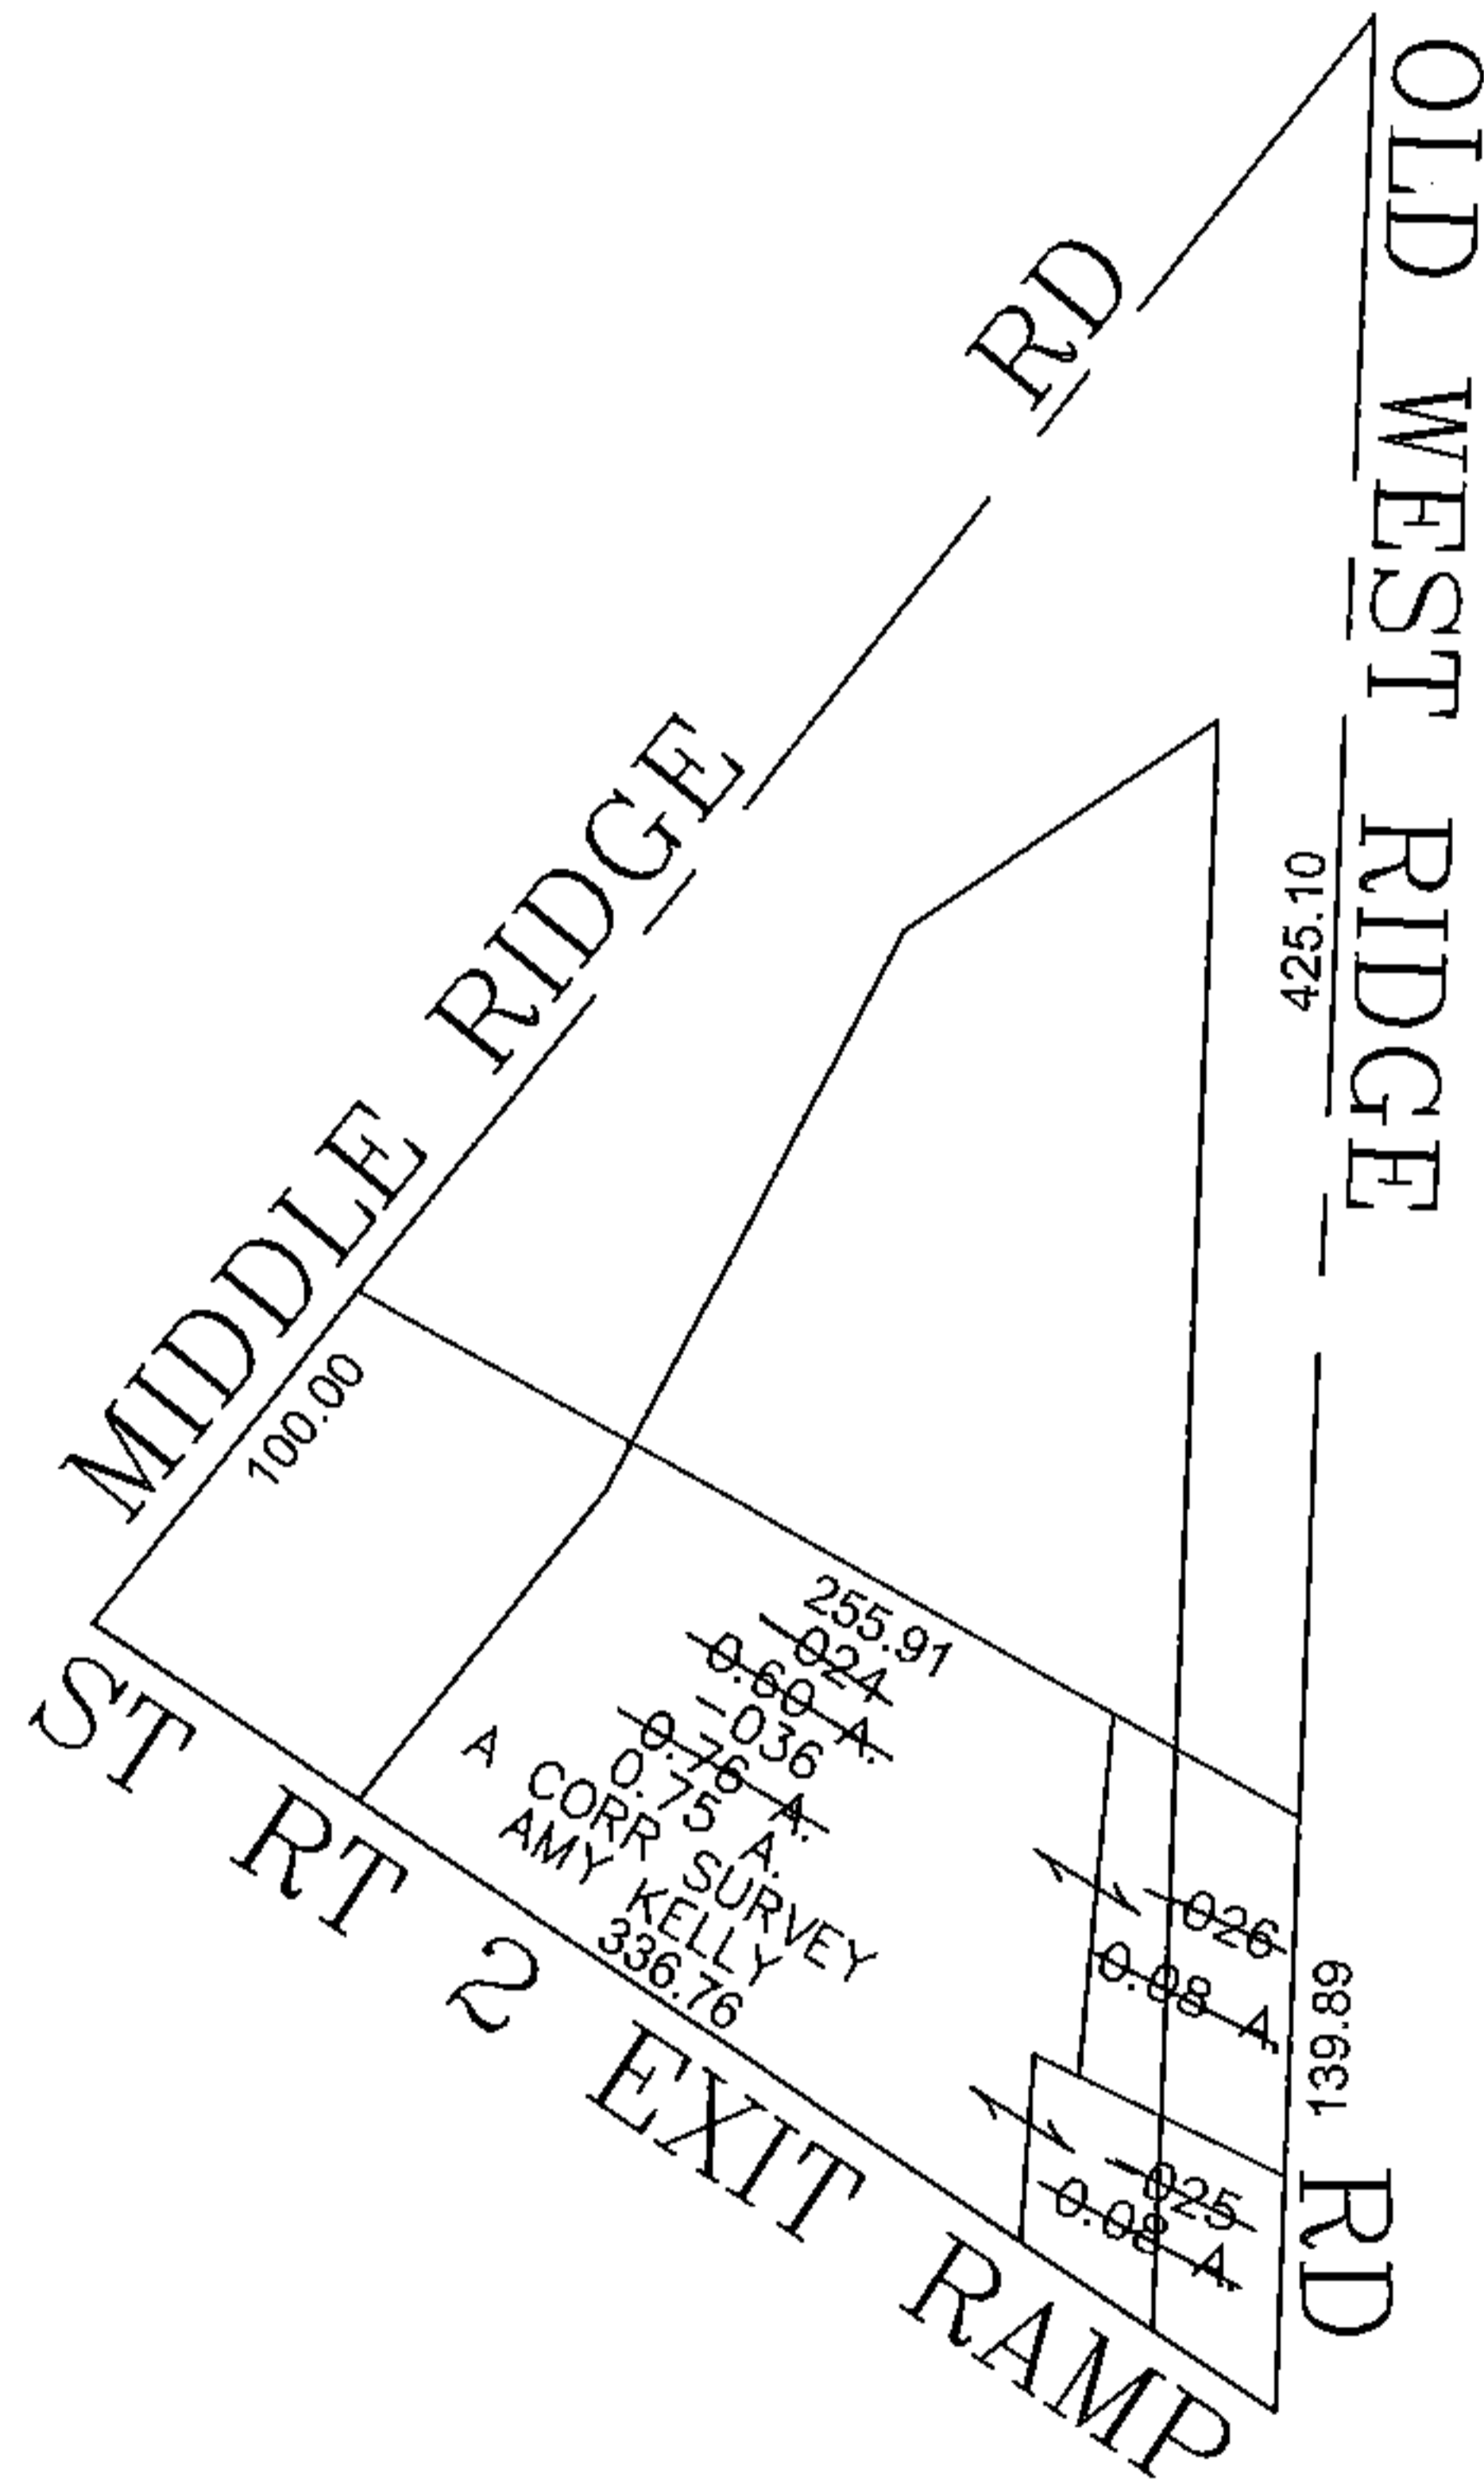


PARENT PARCEL: 05-00-081-000-024, -025, -026

CHILD PARCEL: 05-00-081-000-036

STARTING POINT: CENTERLINE OF MIDDLE RIDGE & OLD WEST RIDGE RD

15-03373

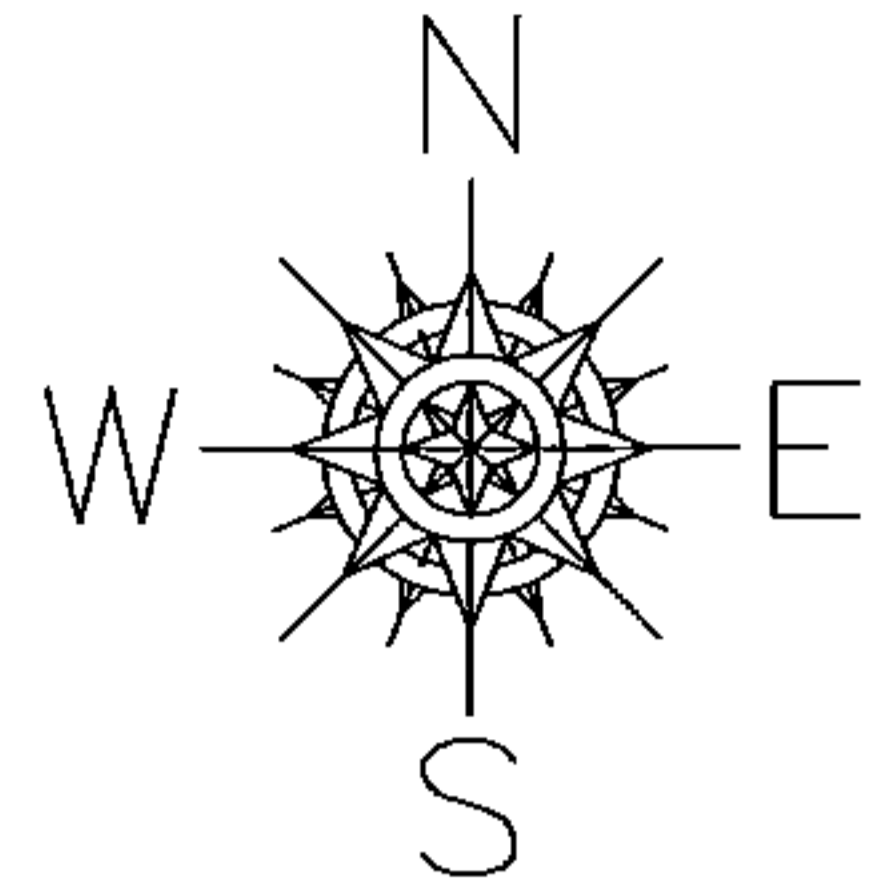

SPLITS/DEEDS PROCESSED

LORAIN COUNTY TAX MAP DEPARTMENT
226 MIDDLE AVE. ELYRIA, OHIO

SURVEYED BY: AMY KELLY

CLOSURE: 0.00 : 10,000

MAP PAGE(S): 05-00-081-A

APPROVED BY: JAH DATE: 6/1/2015

SCALE: 1" = 100 PRIOR INSTRUMENT: 20080266163