

PARENT PARCEL: ADD TO DUPLICATE  
 CHILD PARCEL: 02-02-021-109-066 & -067  
 STARTING POINT: PRE VACATION ORD. # 56-07 & # 31-87

16-03375-A

ADD TO DUPLICATE

02-02-021-109-066

0.50 A.




PER VAC. ORD. # 56-07

&

02-02-021-109-067

0.14 A.

PER VAC. ORD. # 31-87

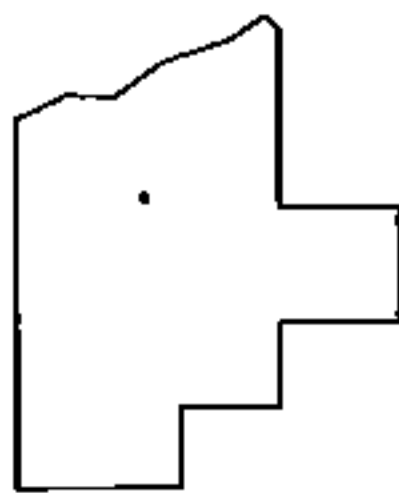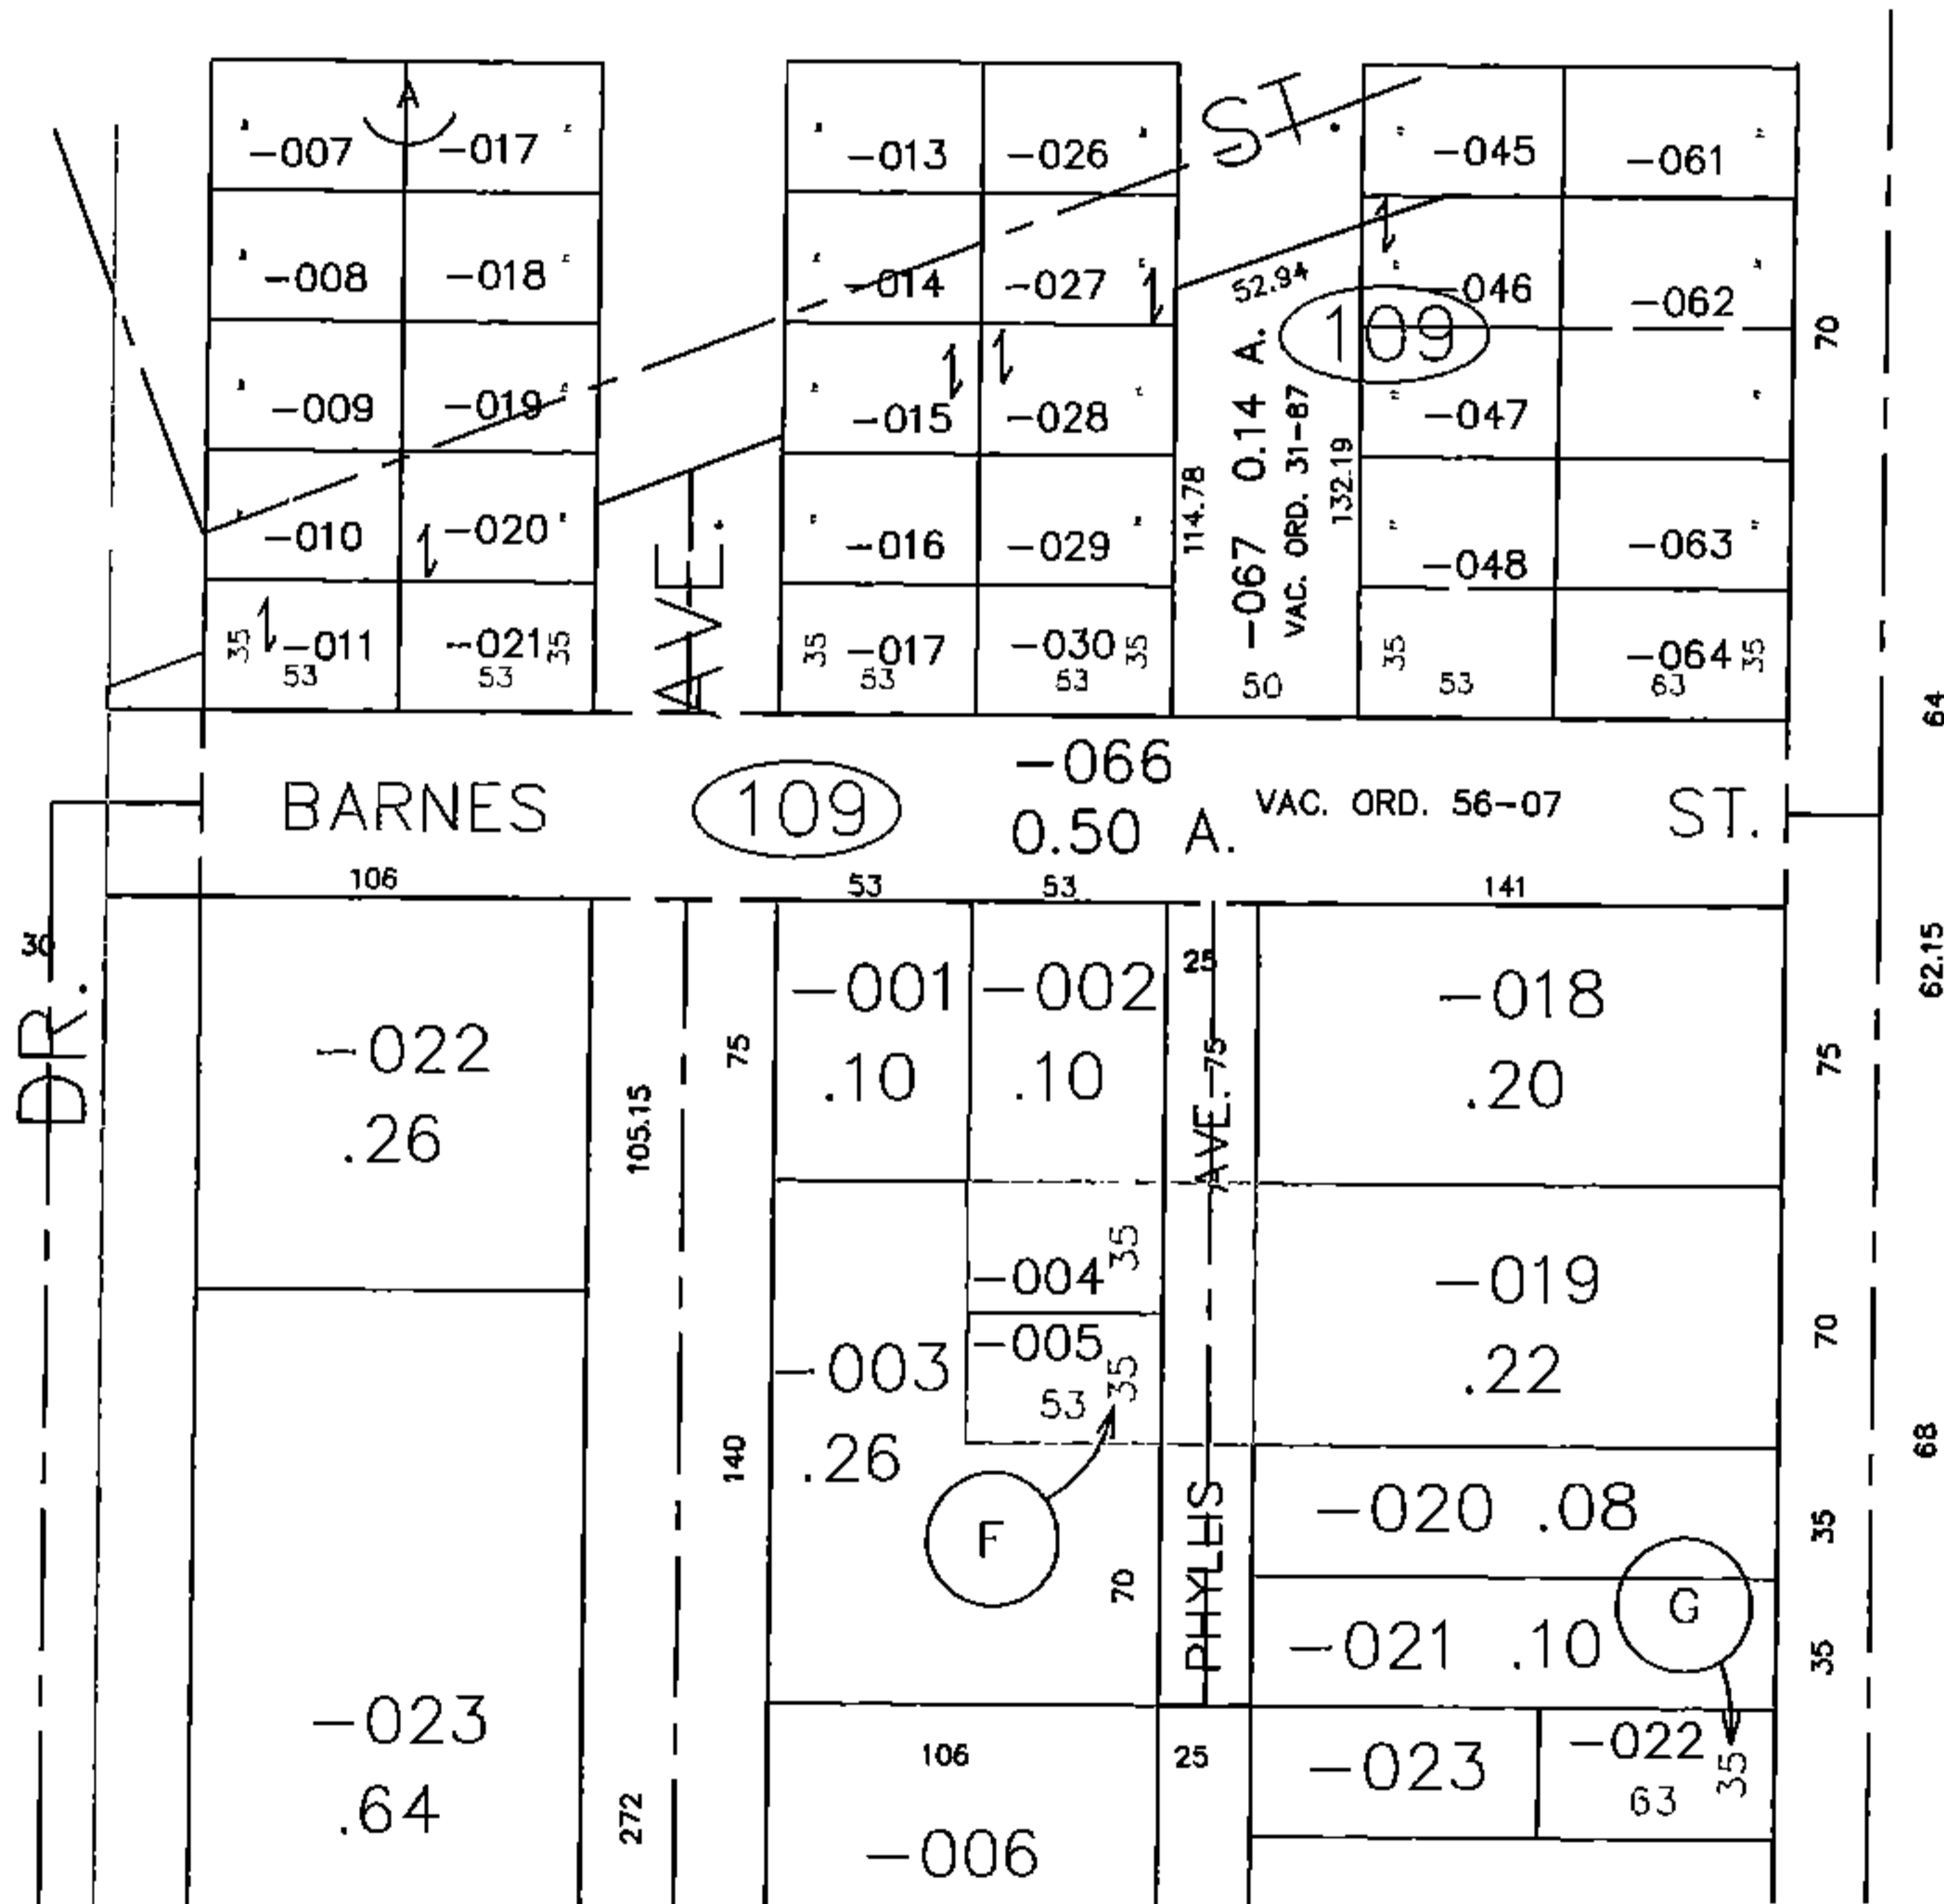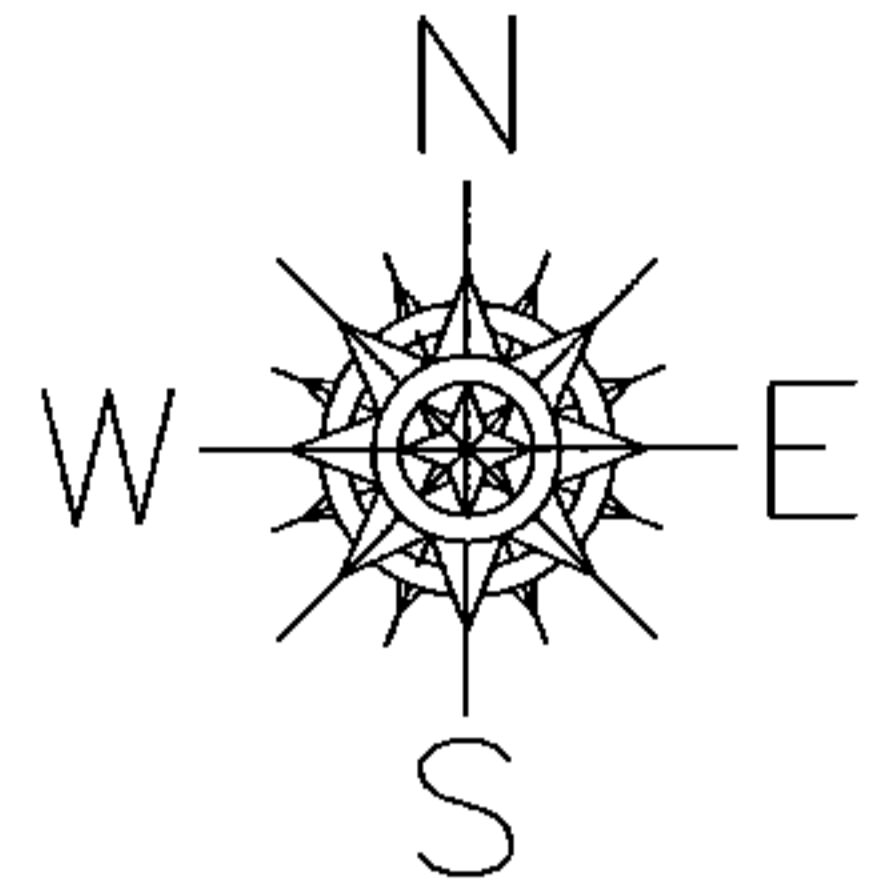

SPLITS/DEEDS PROCESSED

LORAIN COUNTY TAX MAP DEPARTMENT  
 226 MIDDLE AVE. ELYRIA, OHIO

SURVEYED BY: NA  
 CLOSURE: NA  
 MAP PAGE(S): 02-02-021  
 APPROVED BY: TJS DATE: 2/1/16  
 SCALE: 1" = 100' PRIOR INSTRUMENT: DV XXXX/XXX