
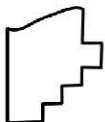


PARENT PARCEL: 01-00-031-000-049 & -050

CHILD PARCEL: 01-00-031-000-064

STARTING POINT: CL OF COOPER FOSTER PARK RD. & CL OF VERMILION RD.

16-03377-C

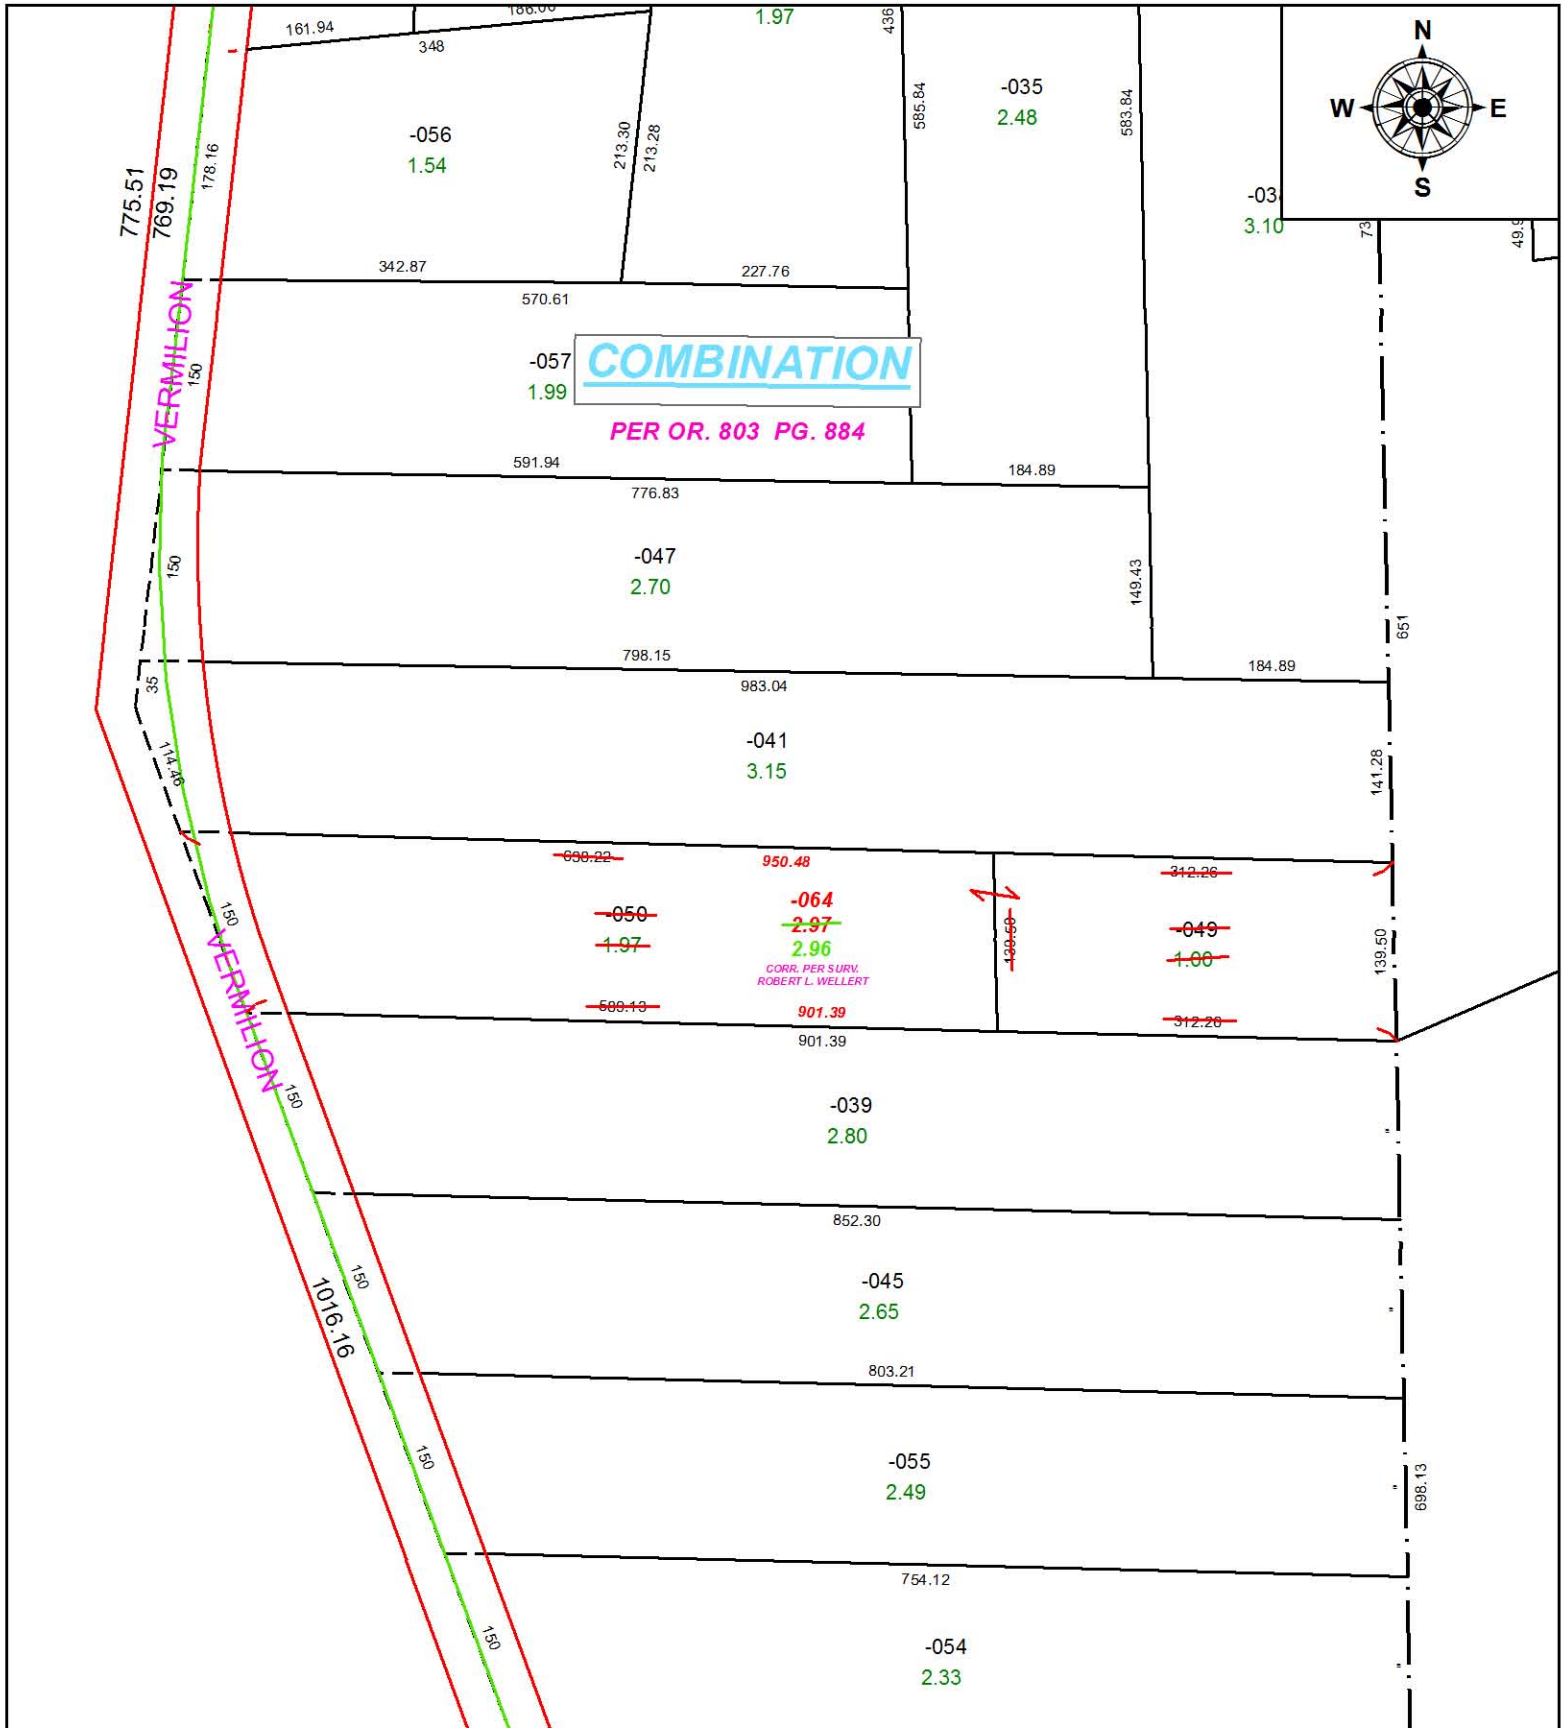

SPLITS/DEEDS PROCESSED
 LORAIN COUNTY TAX MAP DEPARTMENT
 226 MIDDLE AVE. ELYRIA, OH

SURVEYED BY: ROBERT L. WELLET

CLOSURE: 1:77290

MAP PAGE(S): 01-00-031

APPROVED BY: TJS DATE: 2/3/16

SCALE: 1 in = 150 ft PRIOR INSTRUMENT: DV XXXX/XXXX