
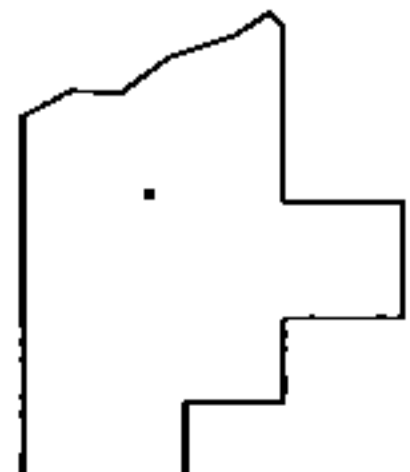
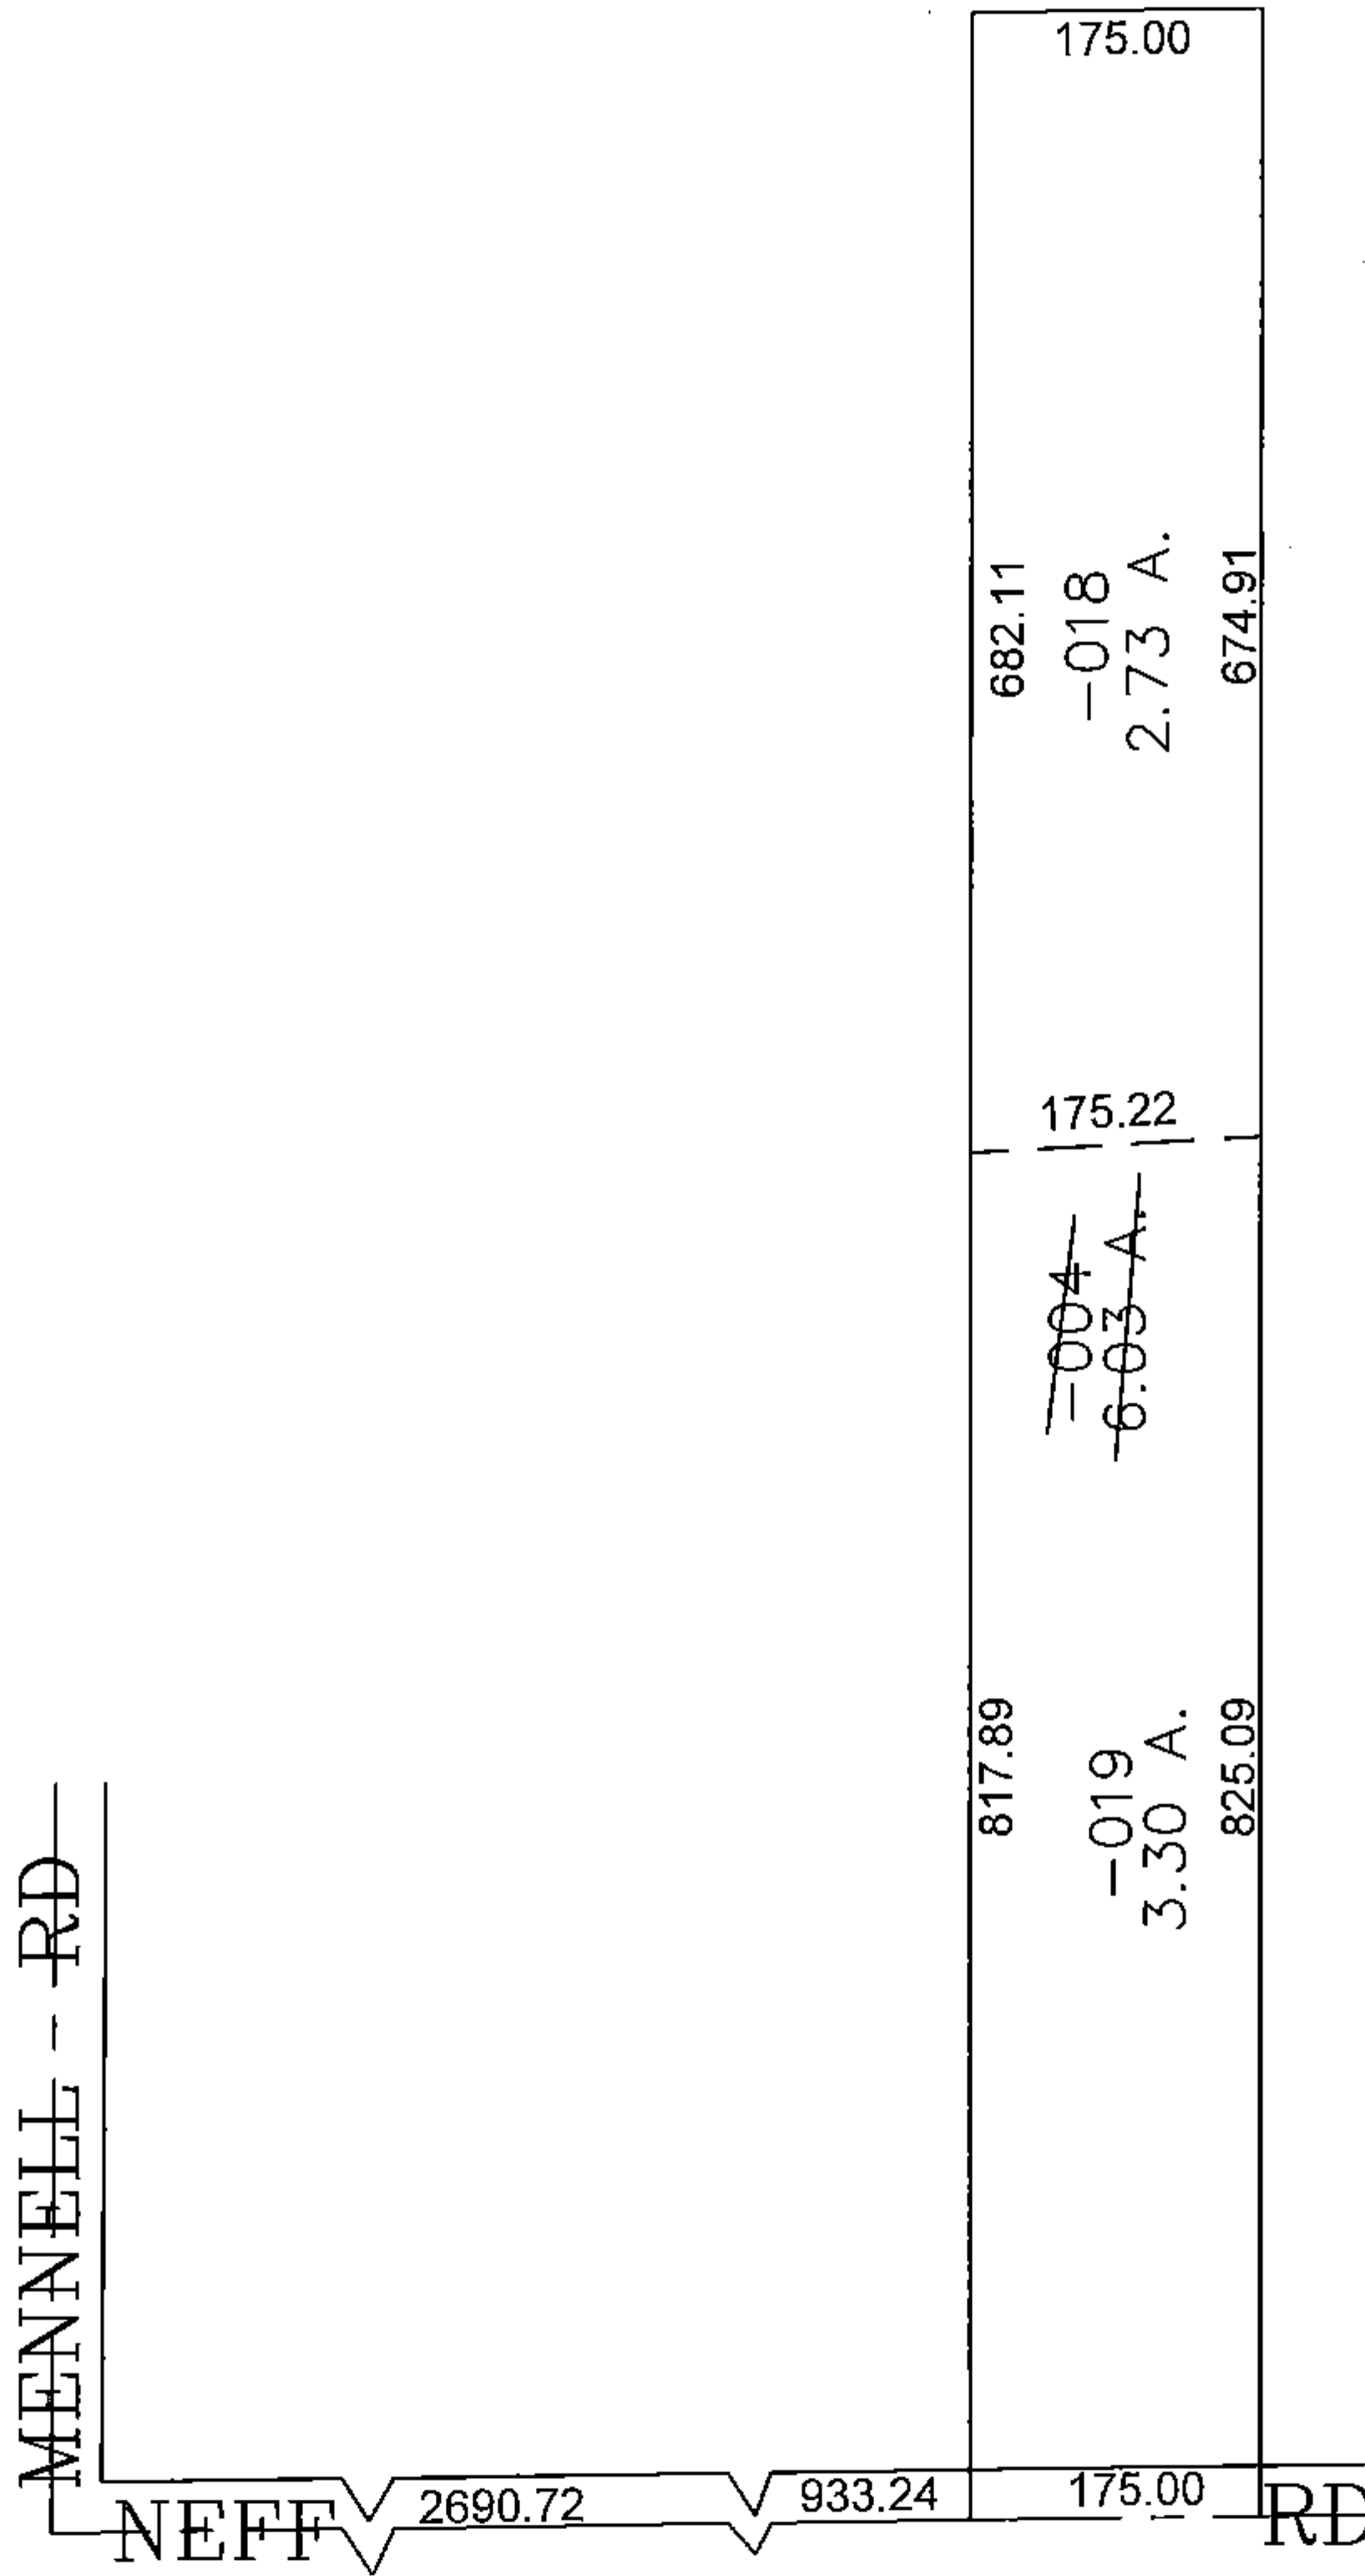


PARENT PARCEL: 16-00-084-000-004

CHILD PARCEL: 16-00-084-000-018, -019

STARTING POINT: CENTERLINE OF MENNELL RD & NEFF RD

15-03377

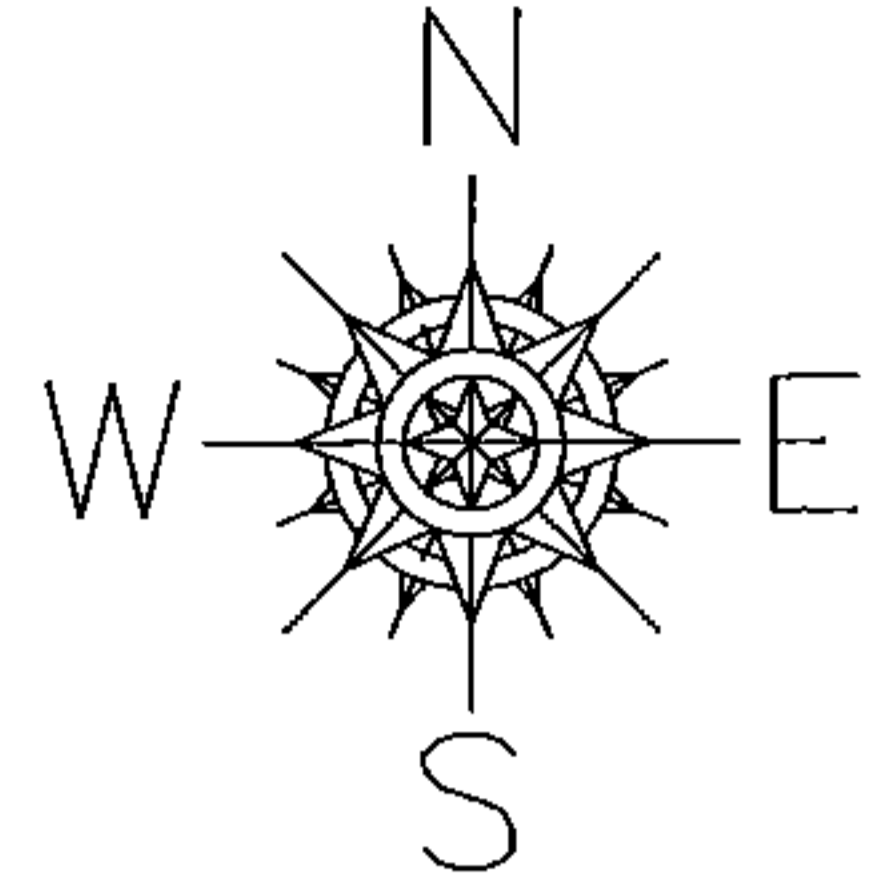

**SPLITS/DEEDS PROCESSED**  
 LORAIN COUNTY TAX MAP DEPARTMENT  
 226 MIDDLE AVE. ELYRIA, OHIO

SURVEYED BY: DALE HAYWOOD  
 CLOSURE: 0.00 : 10.000  
 MAP PAGE(S): 16-00-084-A  
 APPROVED BY: JAH DATE: 6/15/15  
 SCALE: 1" = 200 PRIOR INSTRUMENT: 20110384063