

PARENT PARCEL: 02-01-006-111-036




CHILD PARCEL: XX-XX-XXX-XXX-XXX

STARTING POINT: S.E. CORNER OF S/L 252 OF DURAND'S PLAT OF CHARLESTON VOL. J PG. 446

16-03378-C

**MAP CORR. ONLY**

**SURVEY BEFORE NEXT TRANSFER  
DOESN'T CLOSE**

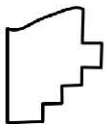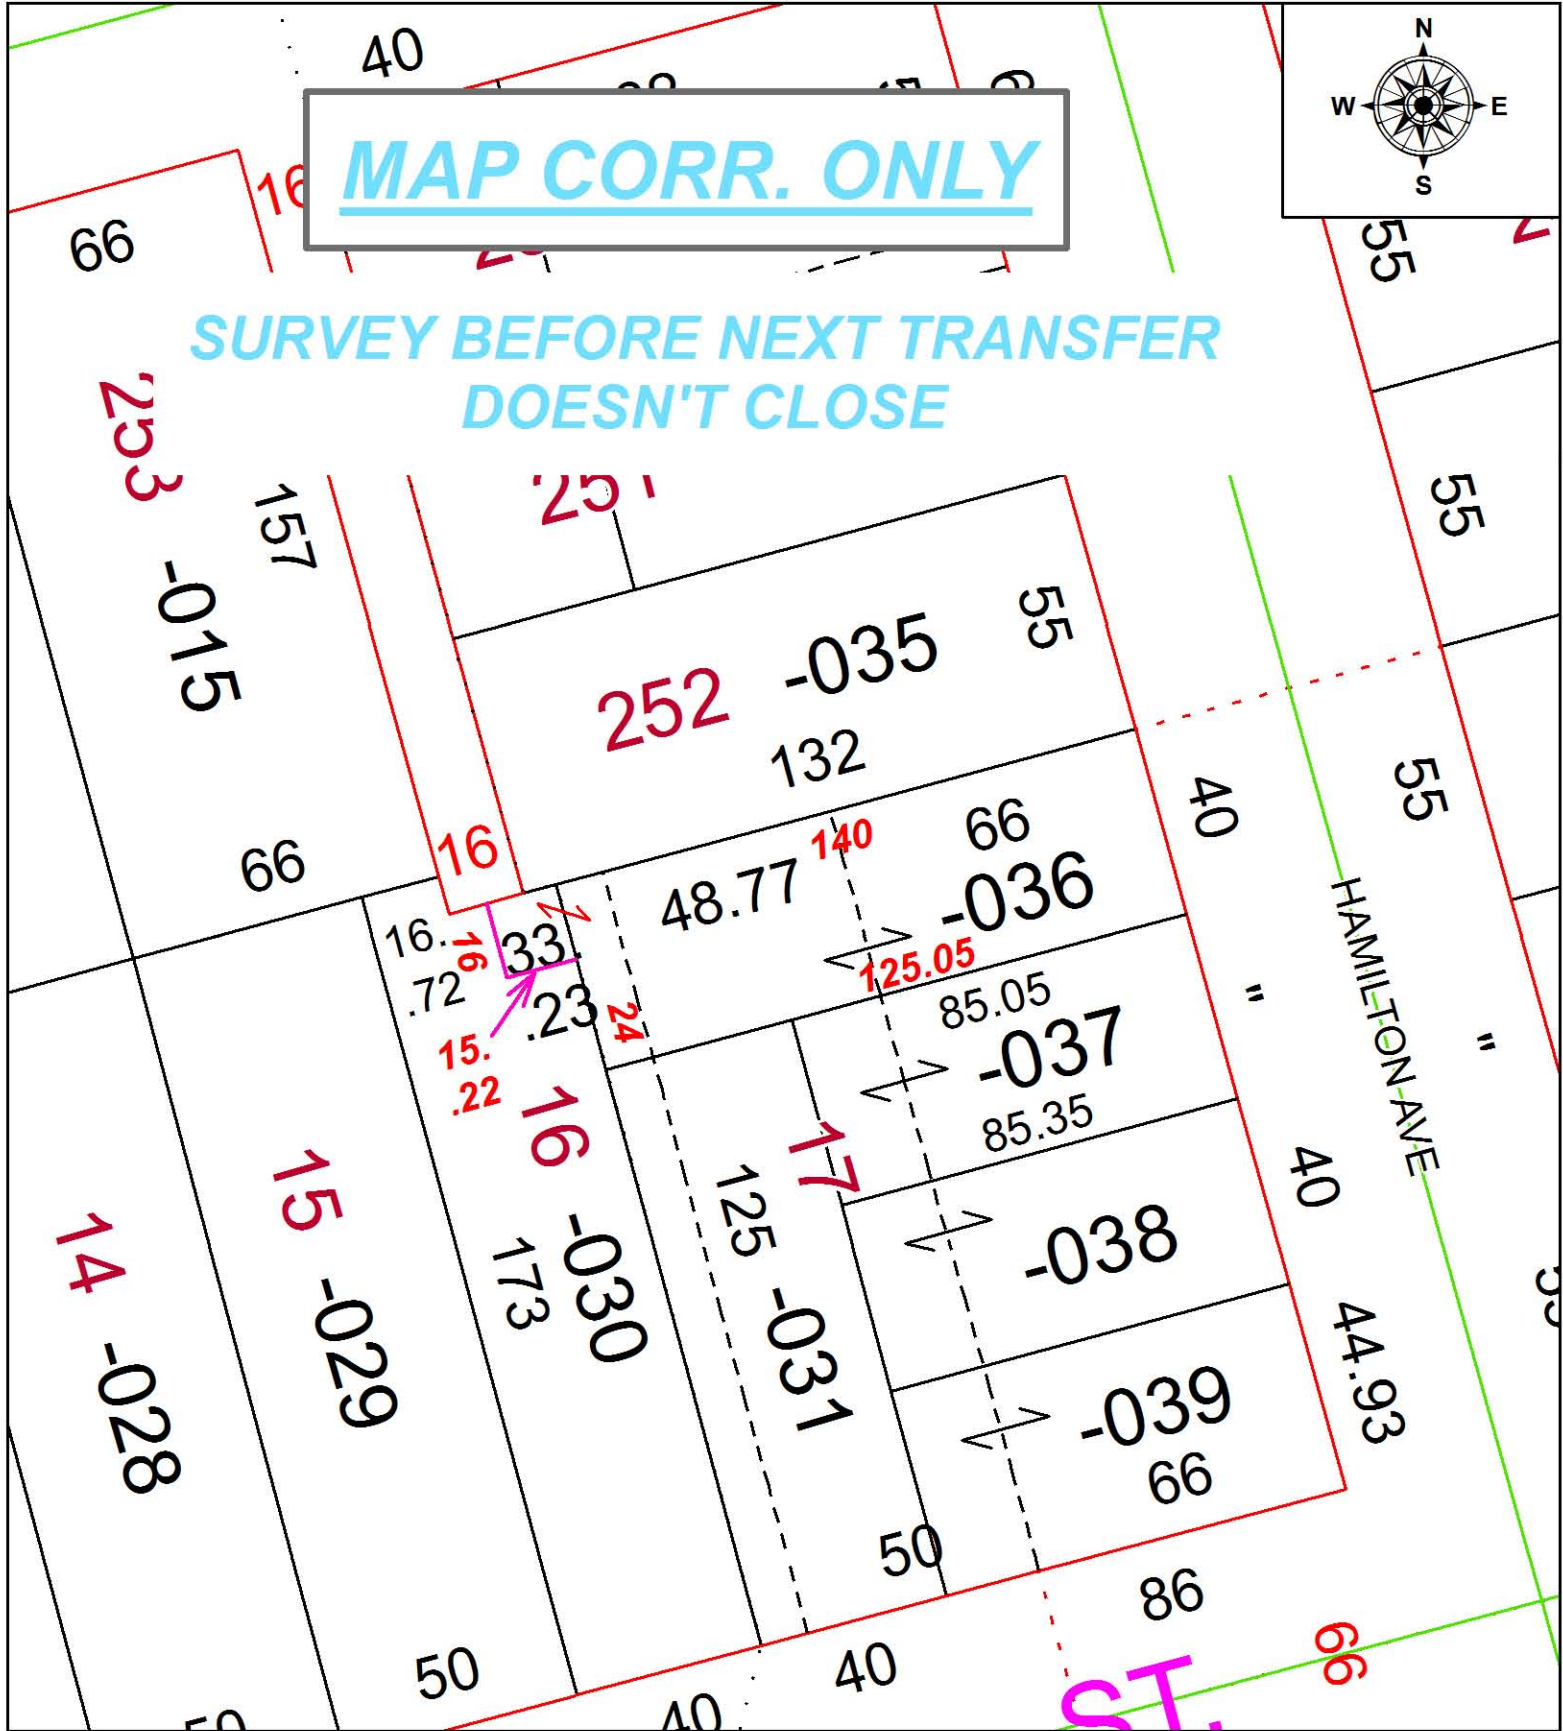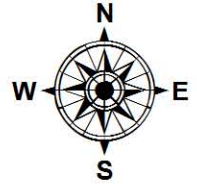

**SPLITS/DEEDS PROCESSED**

LORAIN COUNTY TAX MAP DEPARTMENT  
226 MIDDLE AVE. ELYRIA, OH

SURVEYED BY: NA

CLOSURE: DOESN'T CLOSE

MAP PAGE(S): 02-01-006

APPROVED BY: TJS DATE: 2/2/16

SCALE: 1 in = 40 ft

PRIOR INSTRUMENT: DV XXXX/XXXX