
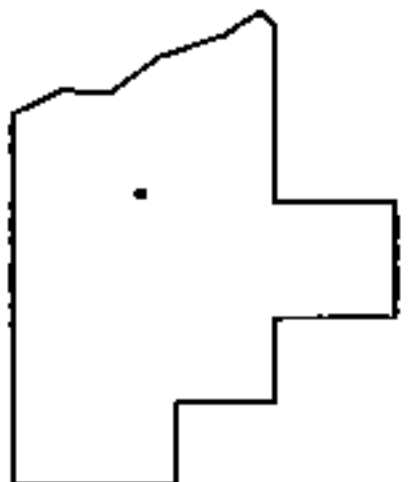
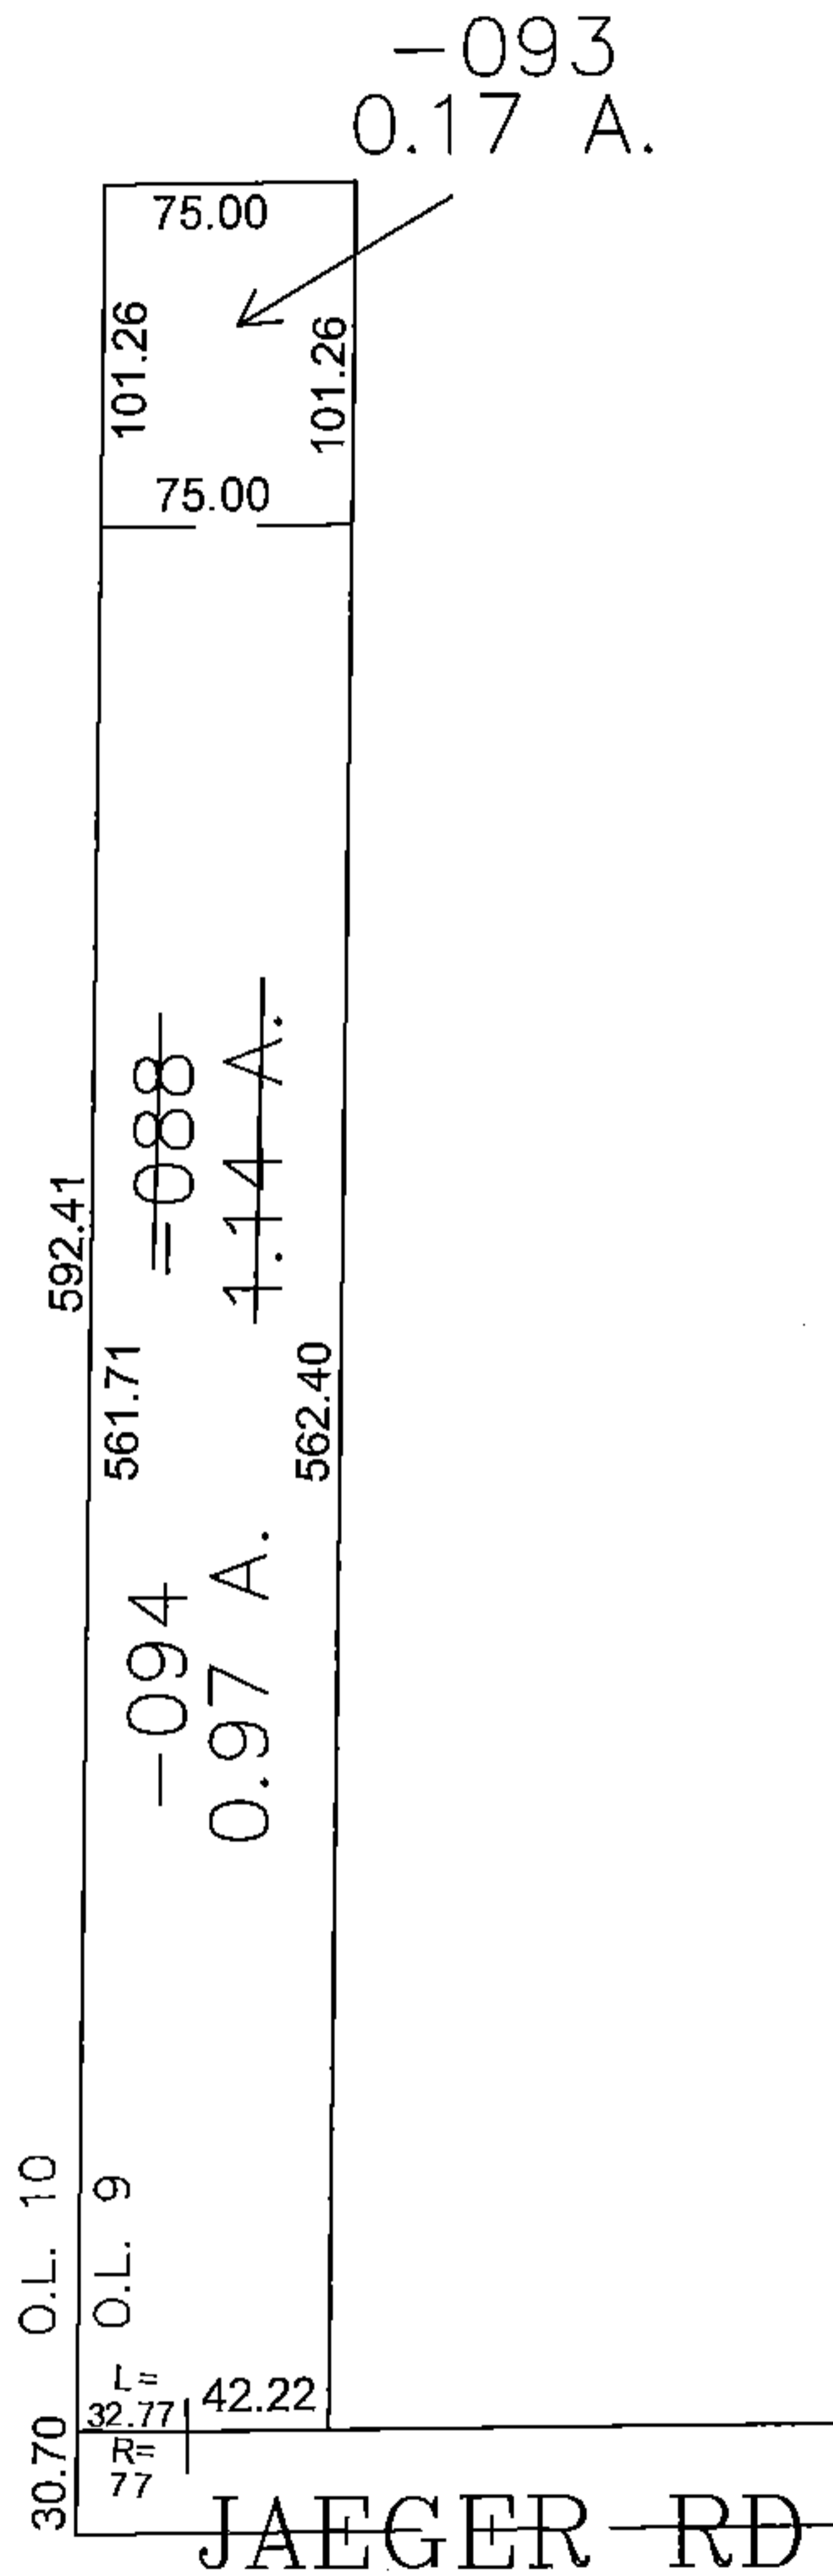


PARENT PARCEL: 02-02-009-101-088

CHILD PARCEL: 02-02-009-101-093, -094

STARTING POINT: CENTERLINE OF JAEGER RD & O.L. 9

15-03378

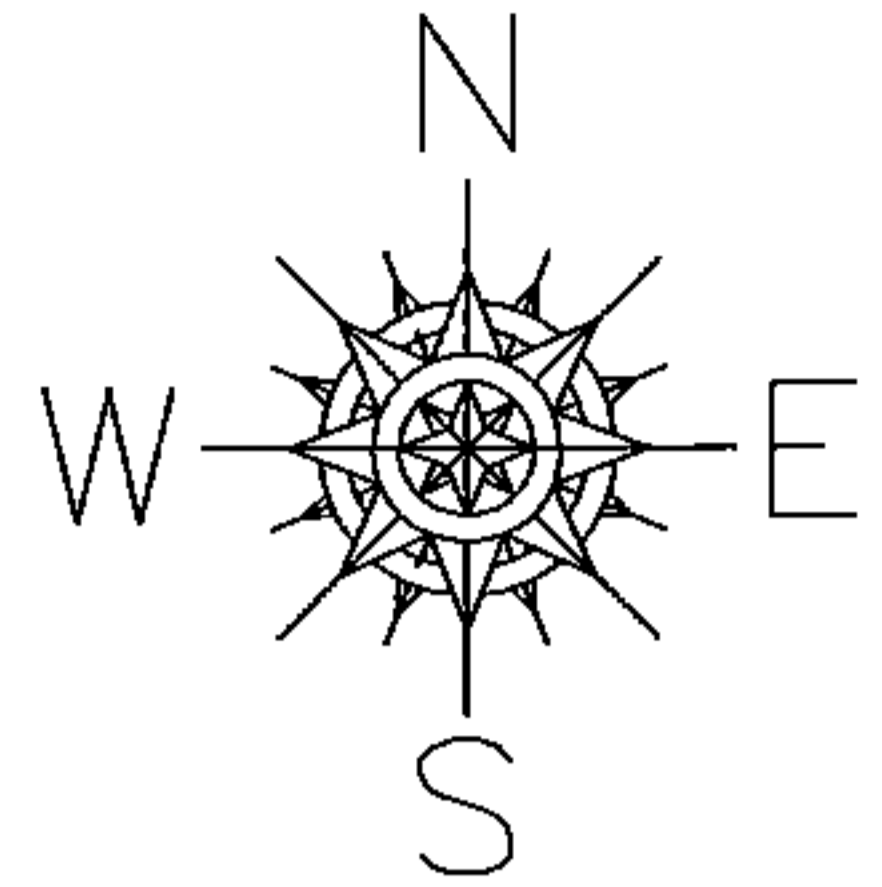

SPLITS/DEEDS PROCESSED

LORAIN COUNTY TAX MAP DEPARTMENT
226 MIDDLE AVE. ELYRIA, OHIO

SURVEYED BY: PATRICK MCGANNON

CLOSURE: 0.00 : 10.000

MAP PAGE(S): 02-02-009

APPROVED BY: JAH DATE: 6/17/2015

SCALE: 1" = 100 PRIOR INSTRUMENT: 20140526948