
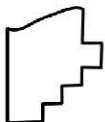


PARENT PARCEL: 13-10-032-000-002

CHILD PARCEL: XX-XX-XXX-XXX-XXX

STARTING POINT: WEST LINE OF O.L. 32, TRACT 10, AT THE S.W. CORNER
OF C.M.L. REALTY CO. DV. 238 PG. 46

16-03379-C

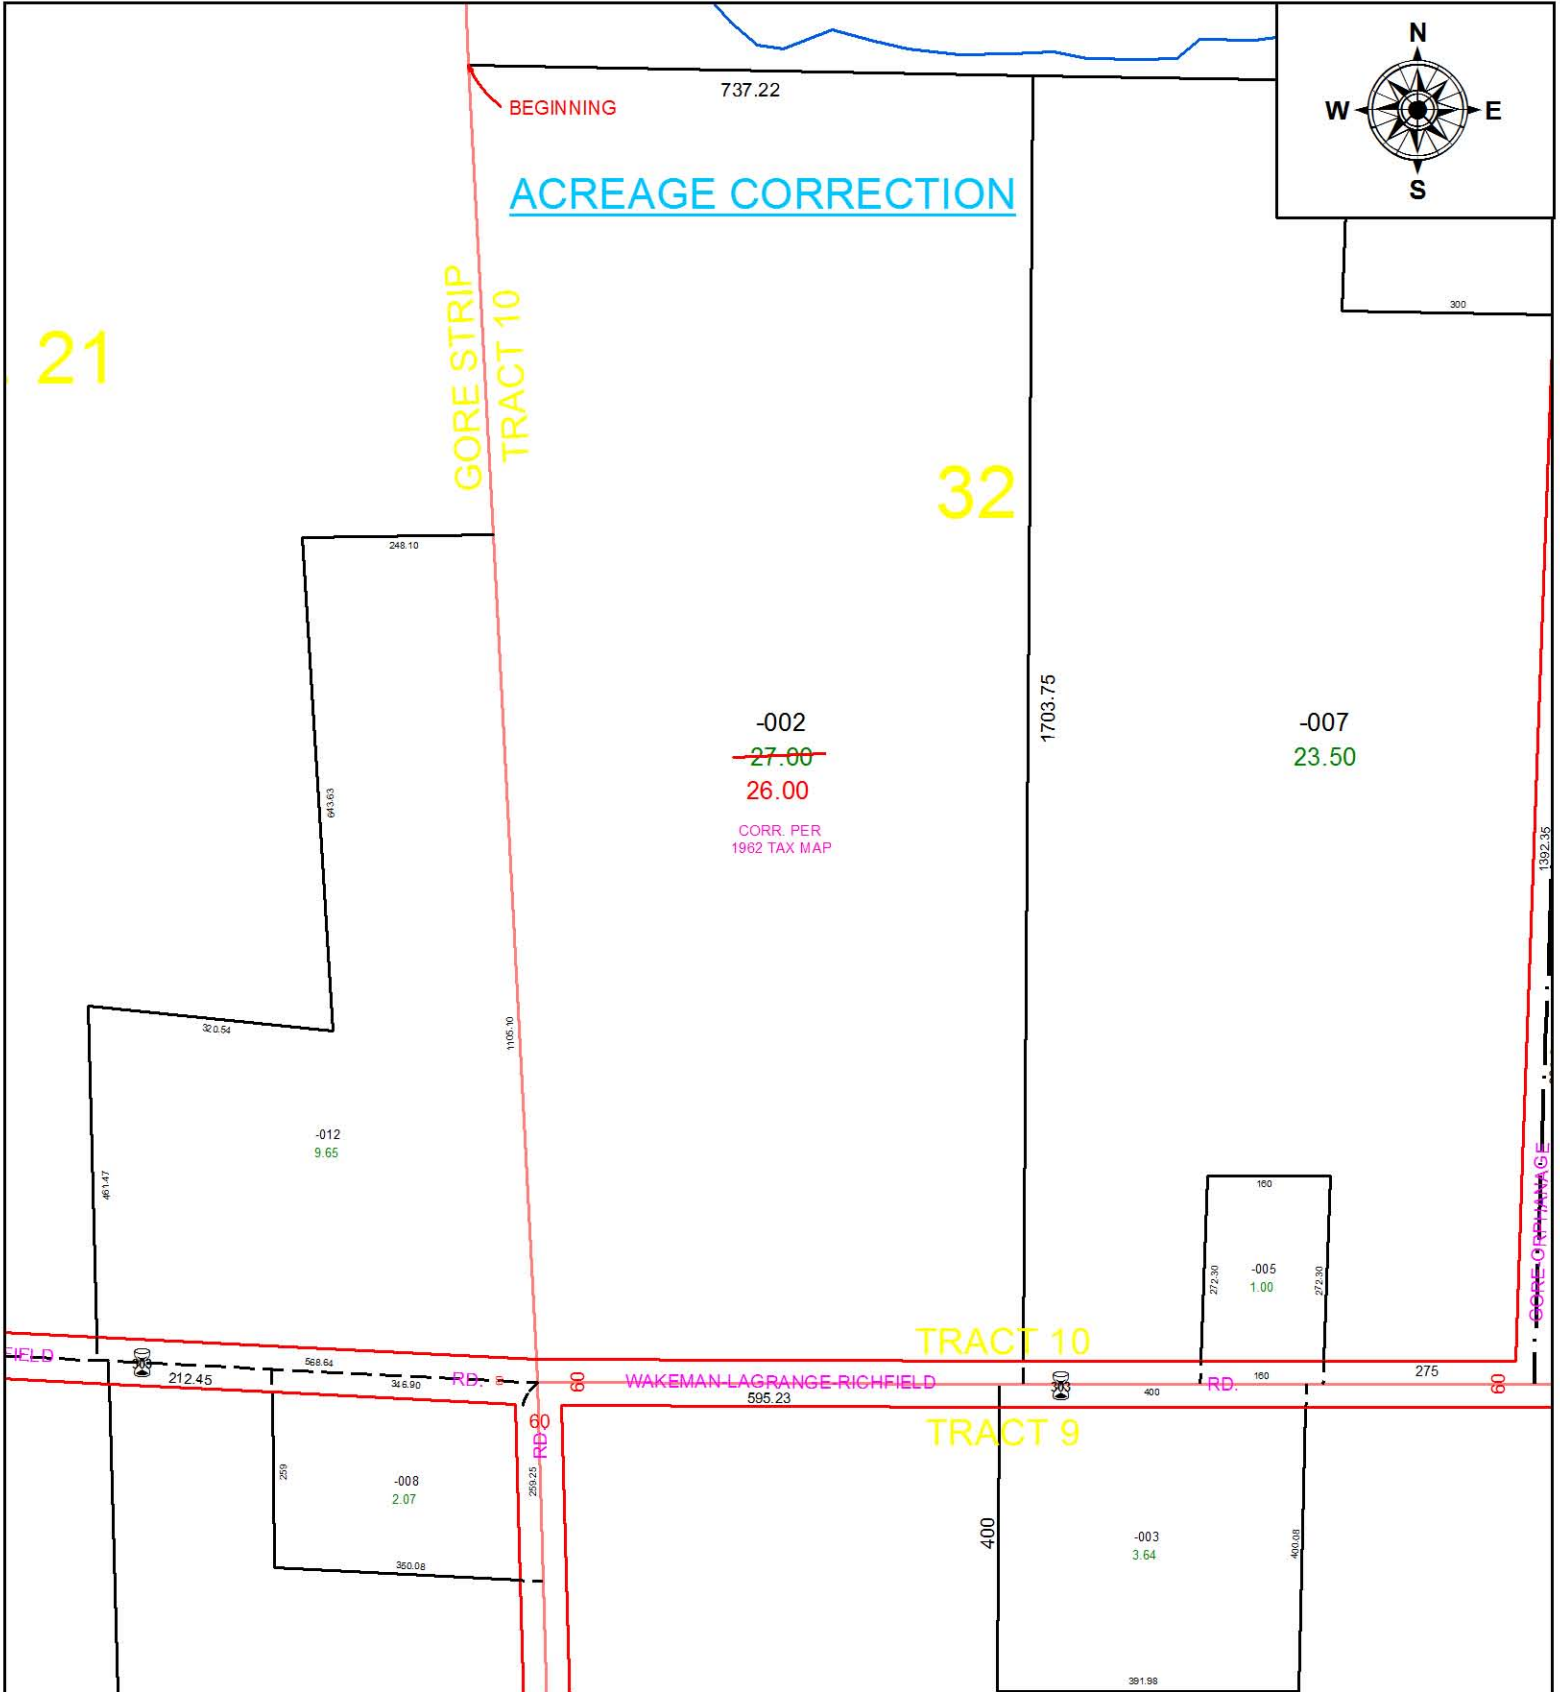

SPLITS/DEEDS PROCESSED
LORAIN COUNTY TAX MAP DEPARTMENT
226 MIDDLE AVE. ELYRIA, OH

SURVEYED BY:	NA
CLOSURE:	NA
MAP PAGE(S):	13-10-032
APPROVED BY:	TJS DATE: 2/8/16
SCALE:	1 in = 250 ft
PRIOR INSTRUMENT:	DV 3185/687