

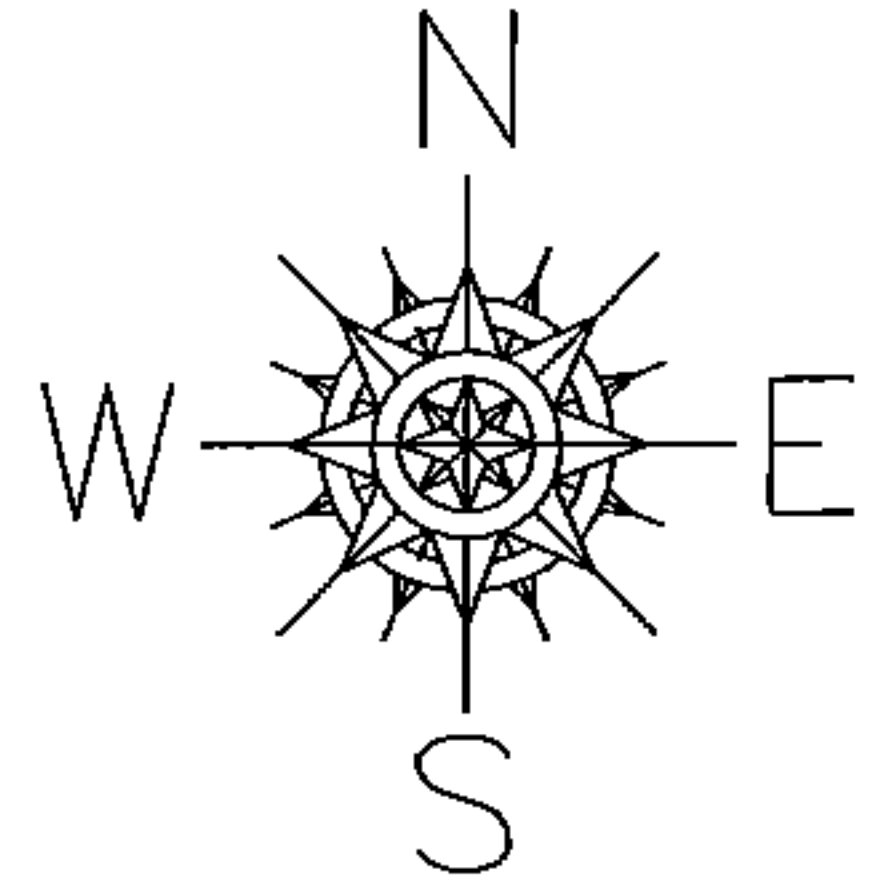


PARENT PARCEL: 20-06-034-000-009, -005
CHILD PARCEL: 20-06-034-000-011 THRU -013
STARTING POINT: CENTERLINE OF QUARRY RD & NORTHEAST CORNER OF O.L. 34

15-03380

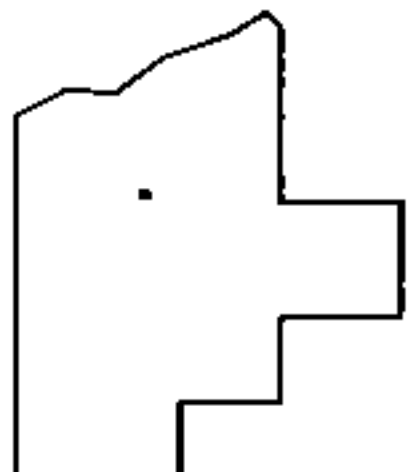

BRIGHTON TWP TR 6 LOT 33
ROCHESTER TWP TR 6 LOT 34

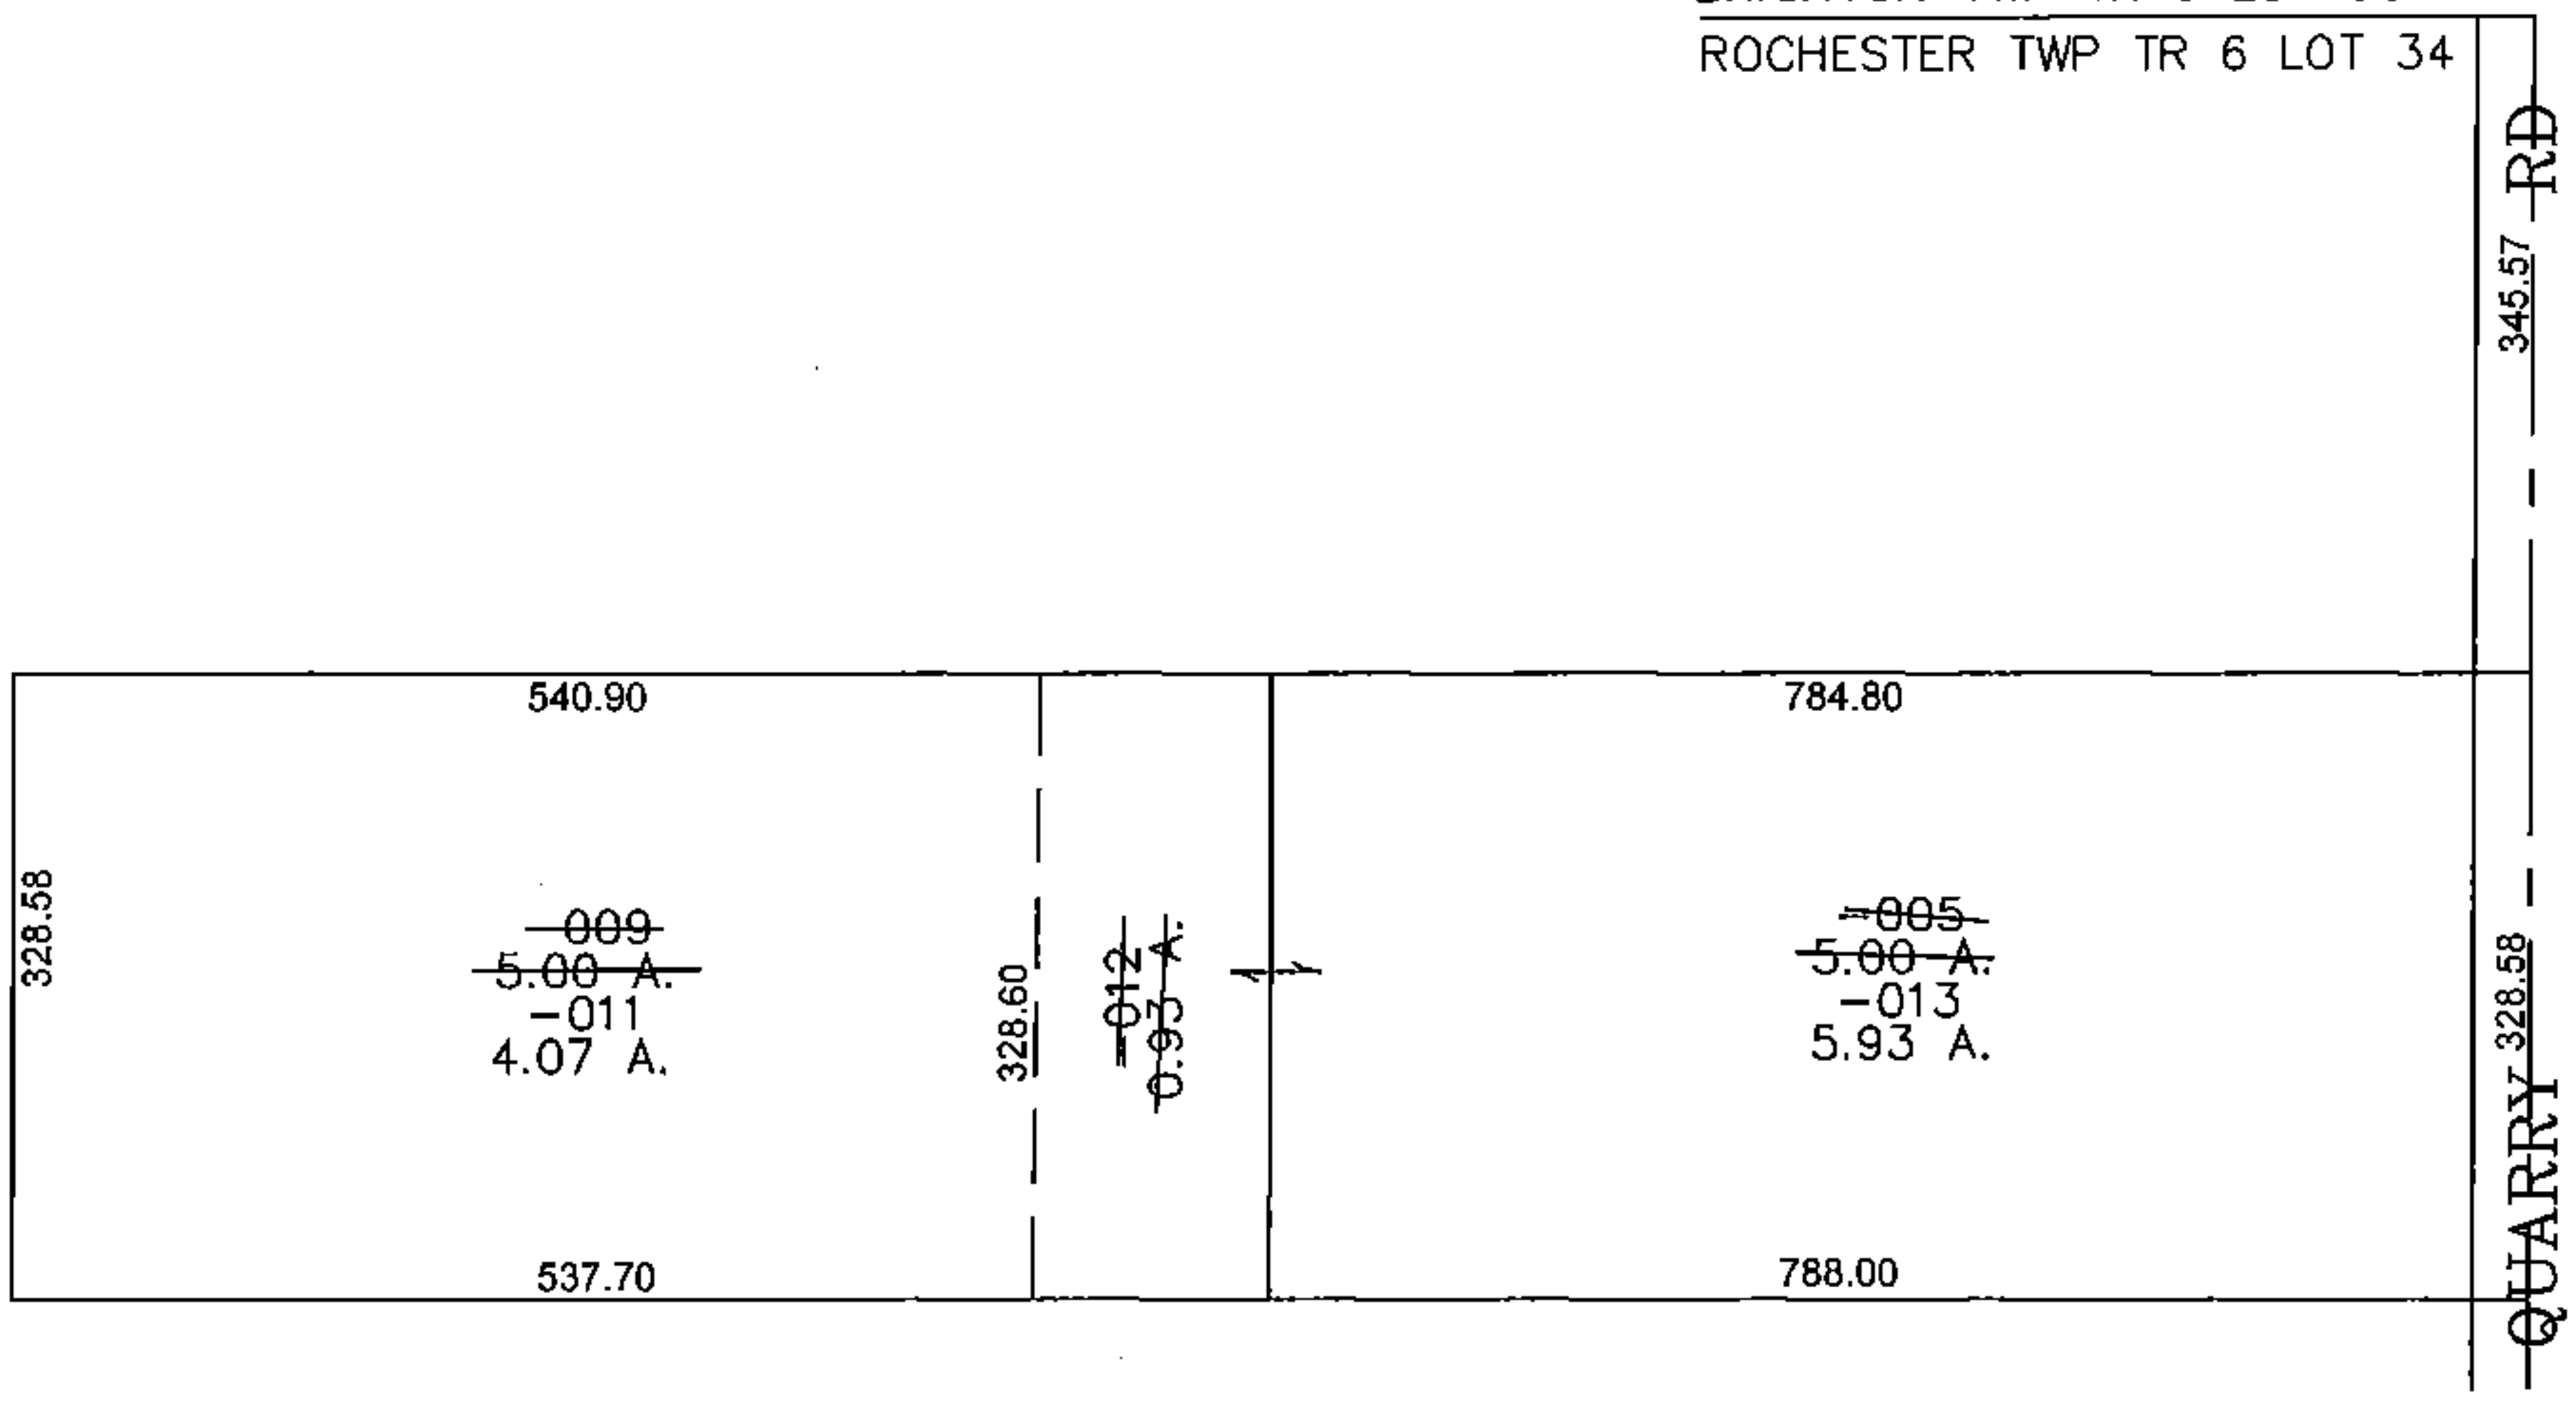

SPLITS/DEEDS PROCESSED
LORAIN COUNTY TAX MAP DEPARTMENT
226 MIDDLE AVE. ELYRIA, OHIO

SURVEYED BY: TREVOR BIXLER
CLOSURE: 0.00 : 10.000
MAP PAGE(S): 20-A
APPROVED BY: JAH DATE: 6/17/2015
SCALE: 1" = 200 PRIOR INSTRUMENT: 20150536863