
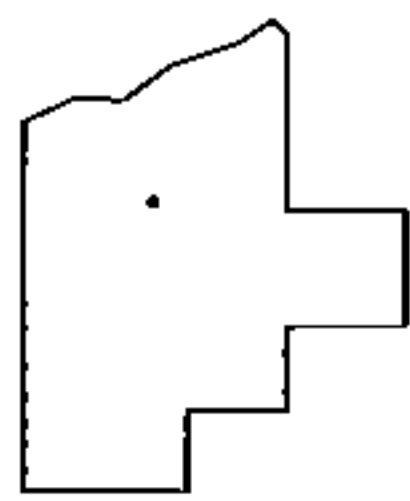
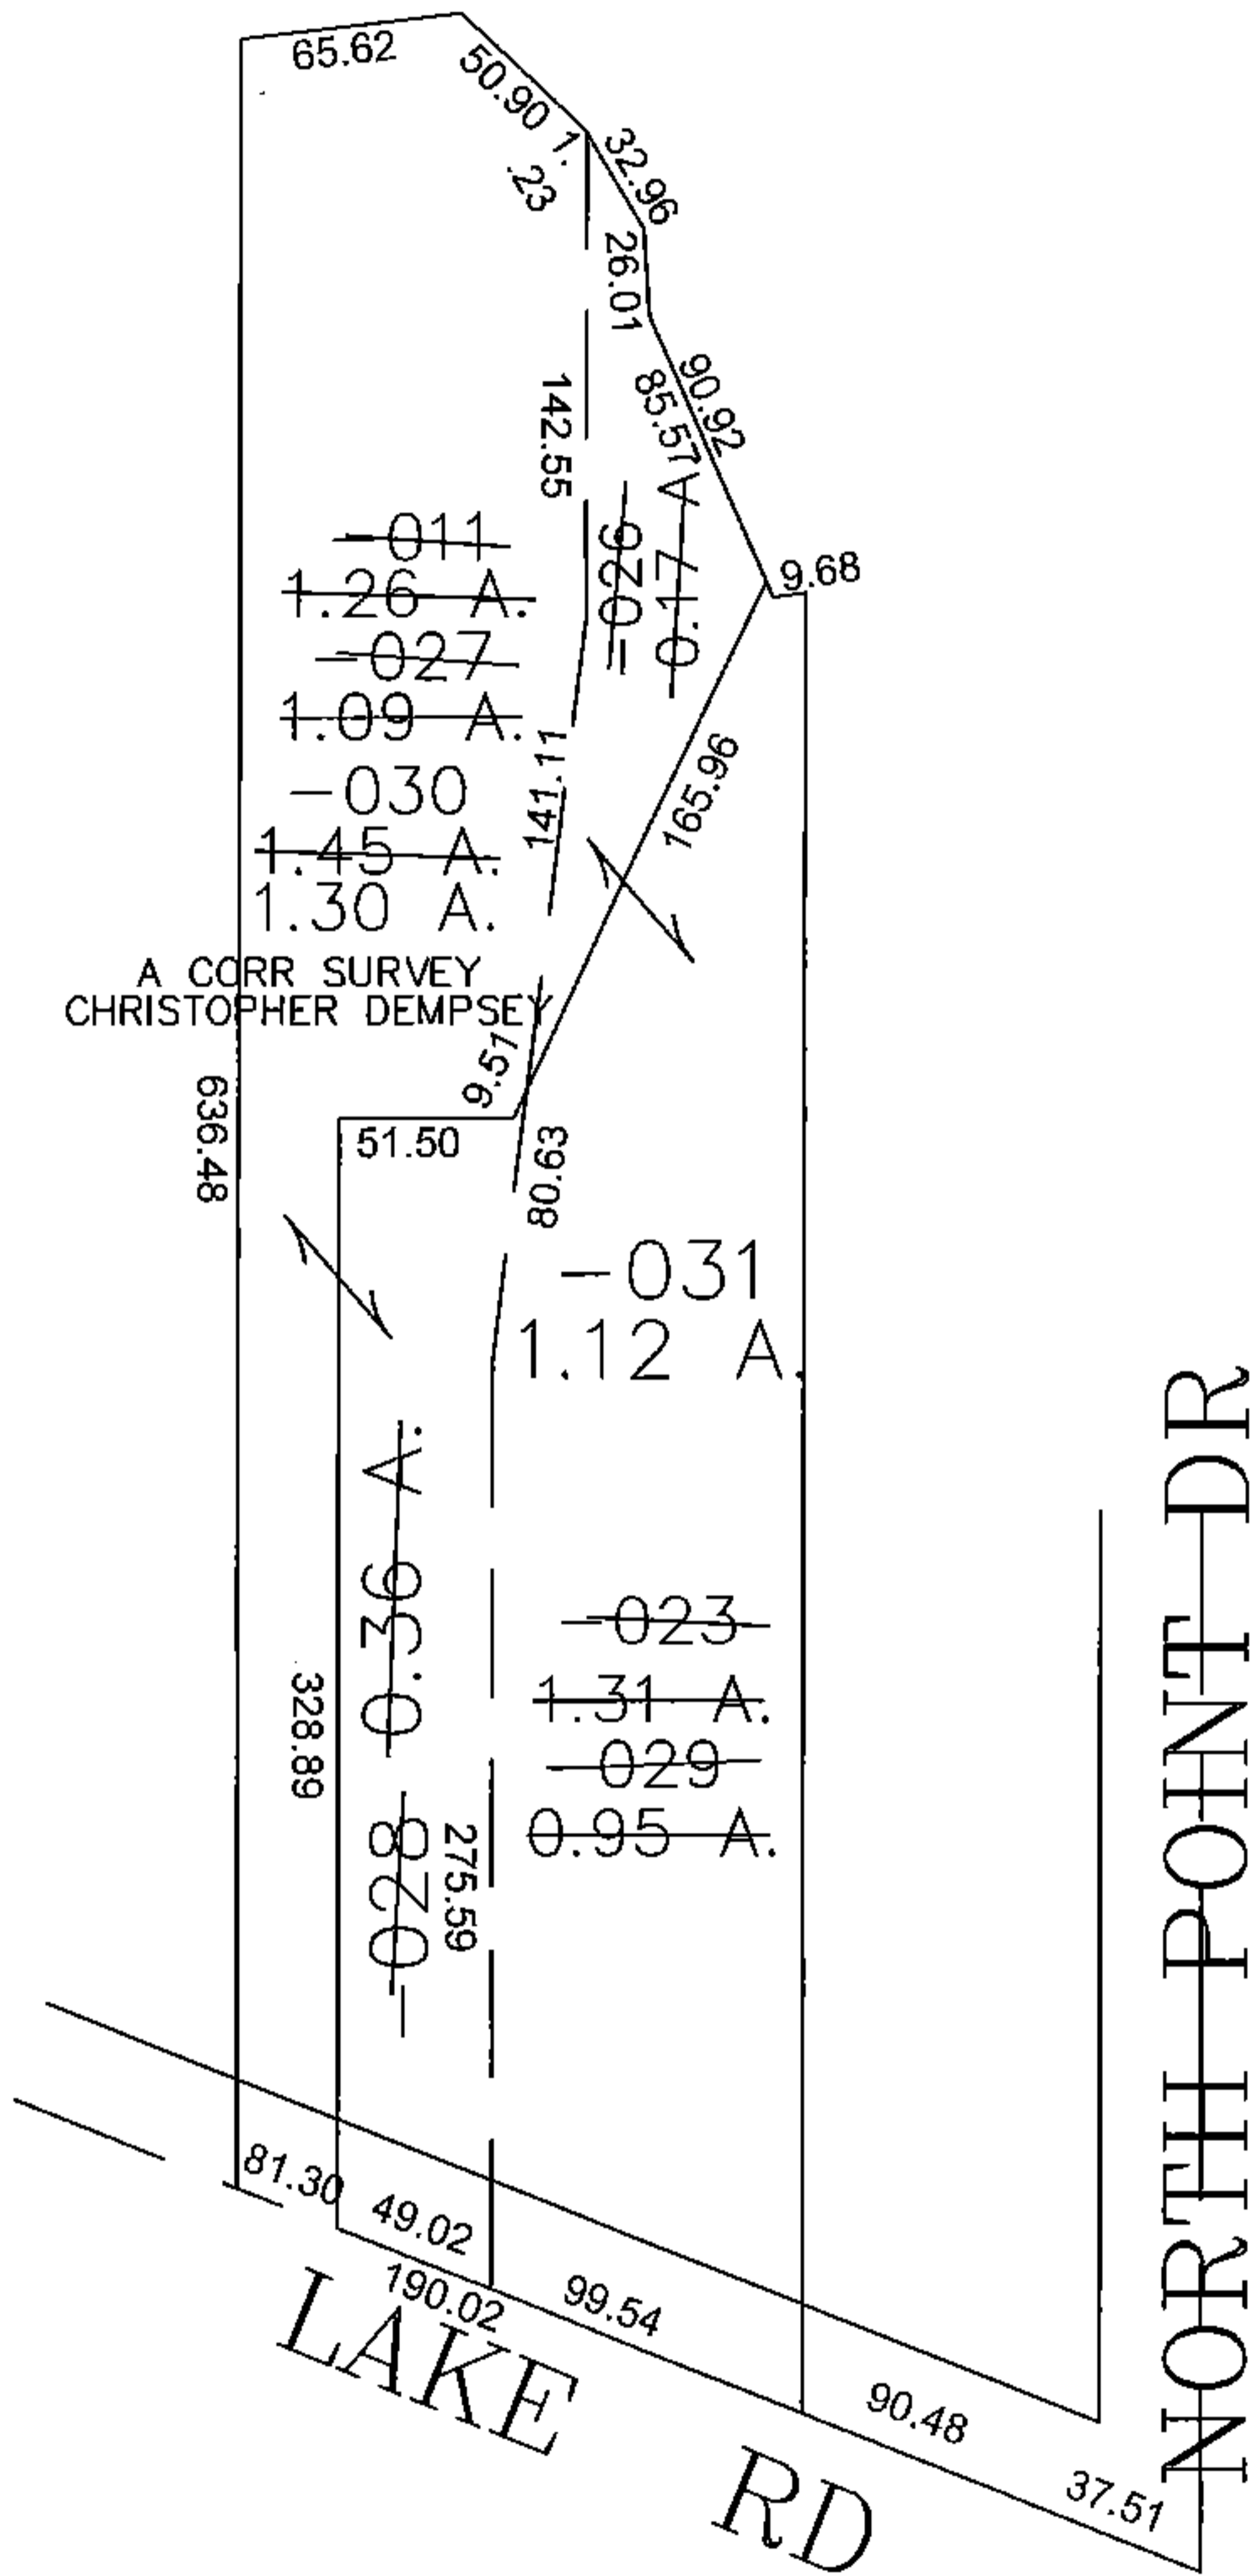


PARENT PARCEL: 04-00-019-104-011, -023  
 CHILD PARCEL: 04-00-019-104-026 THRU -031  
 STARTING POINT: CENTERLINE OF LAKE RD & NORTH POINT DR

15-03382

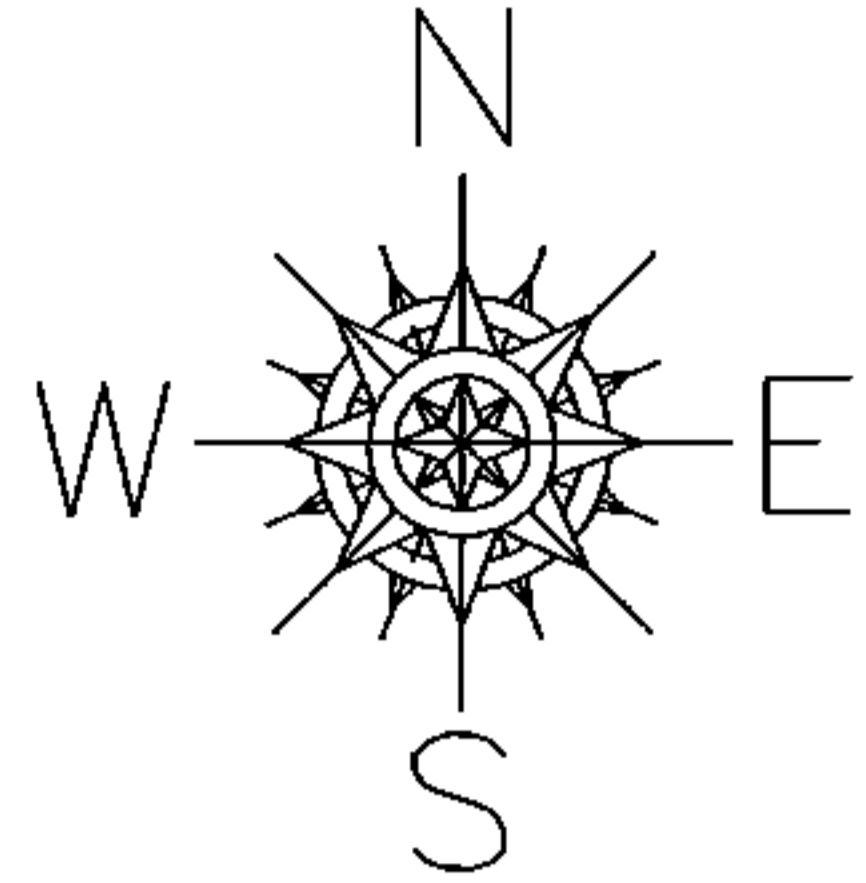

SPLITS/DEEDS PROCESSED

LORAIN COUNTY TAX MAP DEPARTMENT  
 226 MIDDLE AVE. ELYRIA, OHIO

SURVEYED BY: CHRISTOPHER DEMPSEY  
 CLOSURE: 0.00 : 10.000  
 MAP PAGE(S): 04-00-019-A  
 APPROVED BY: JAH DATE: 6/19/2015  
 SCALE: 1" = 100 PRIOR INSTRUMENT: 20080266859