
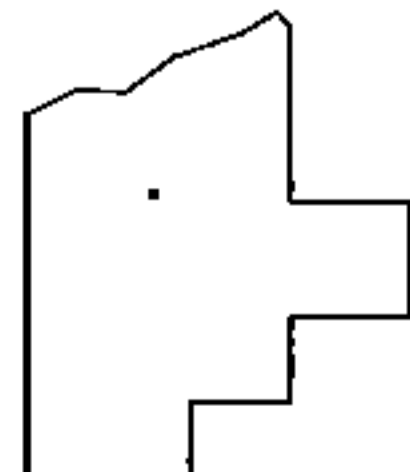
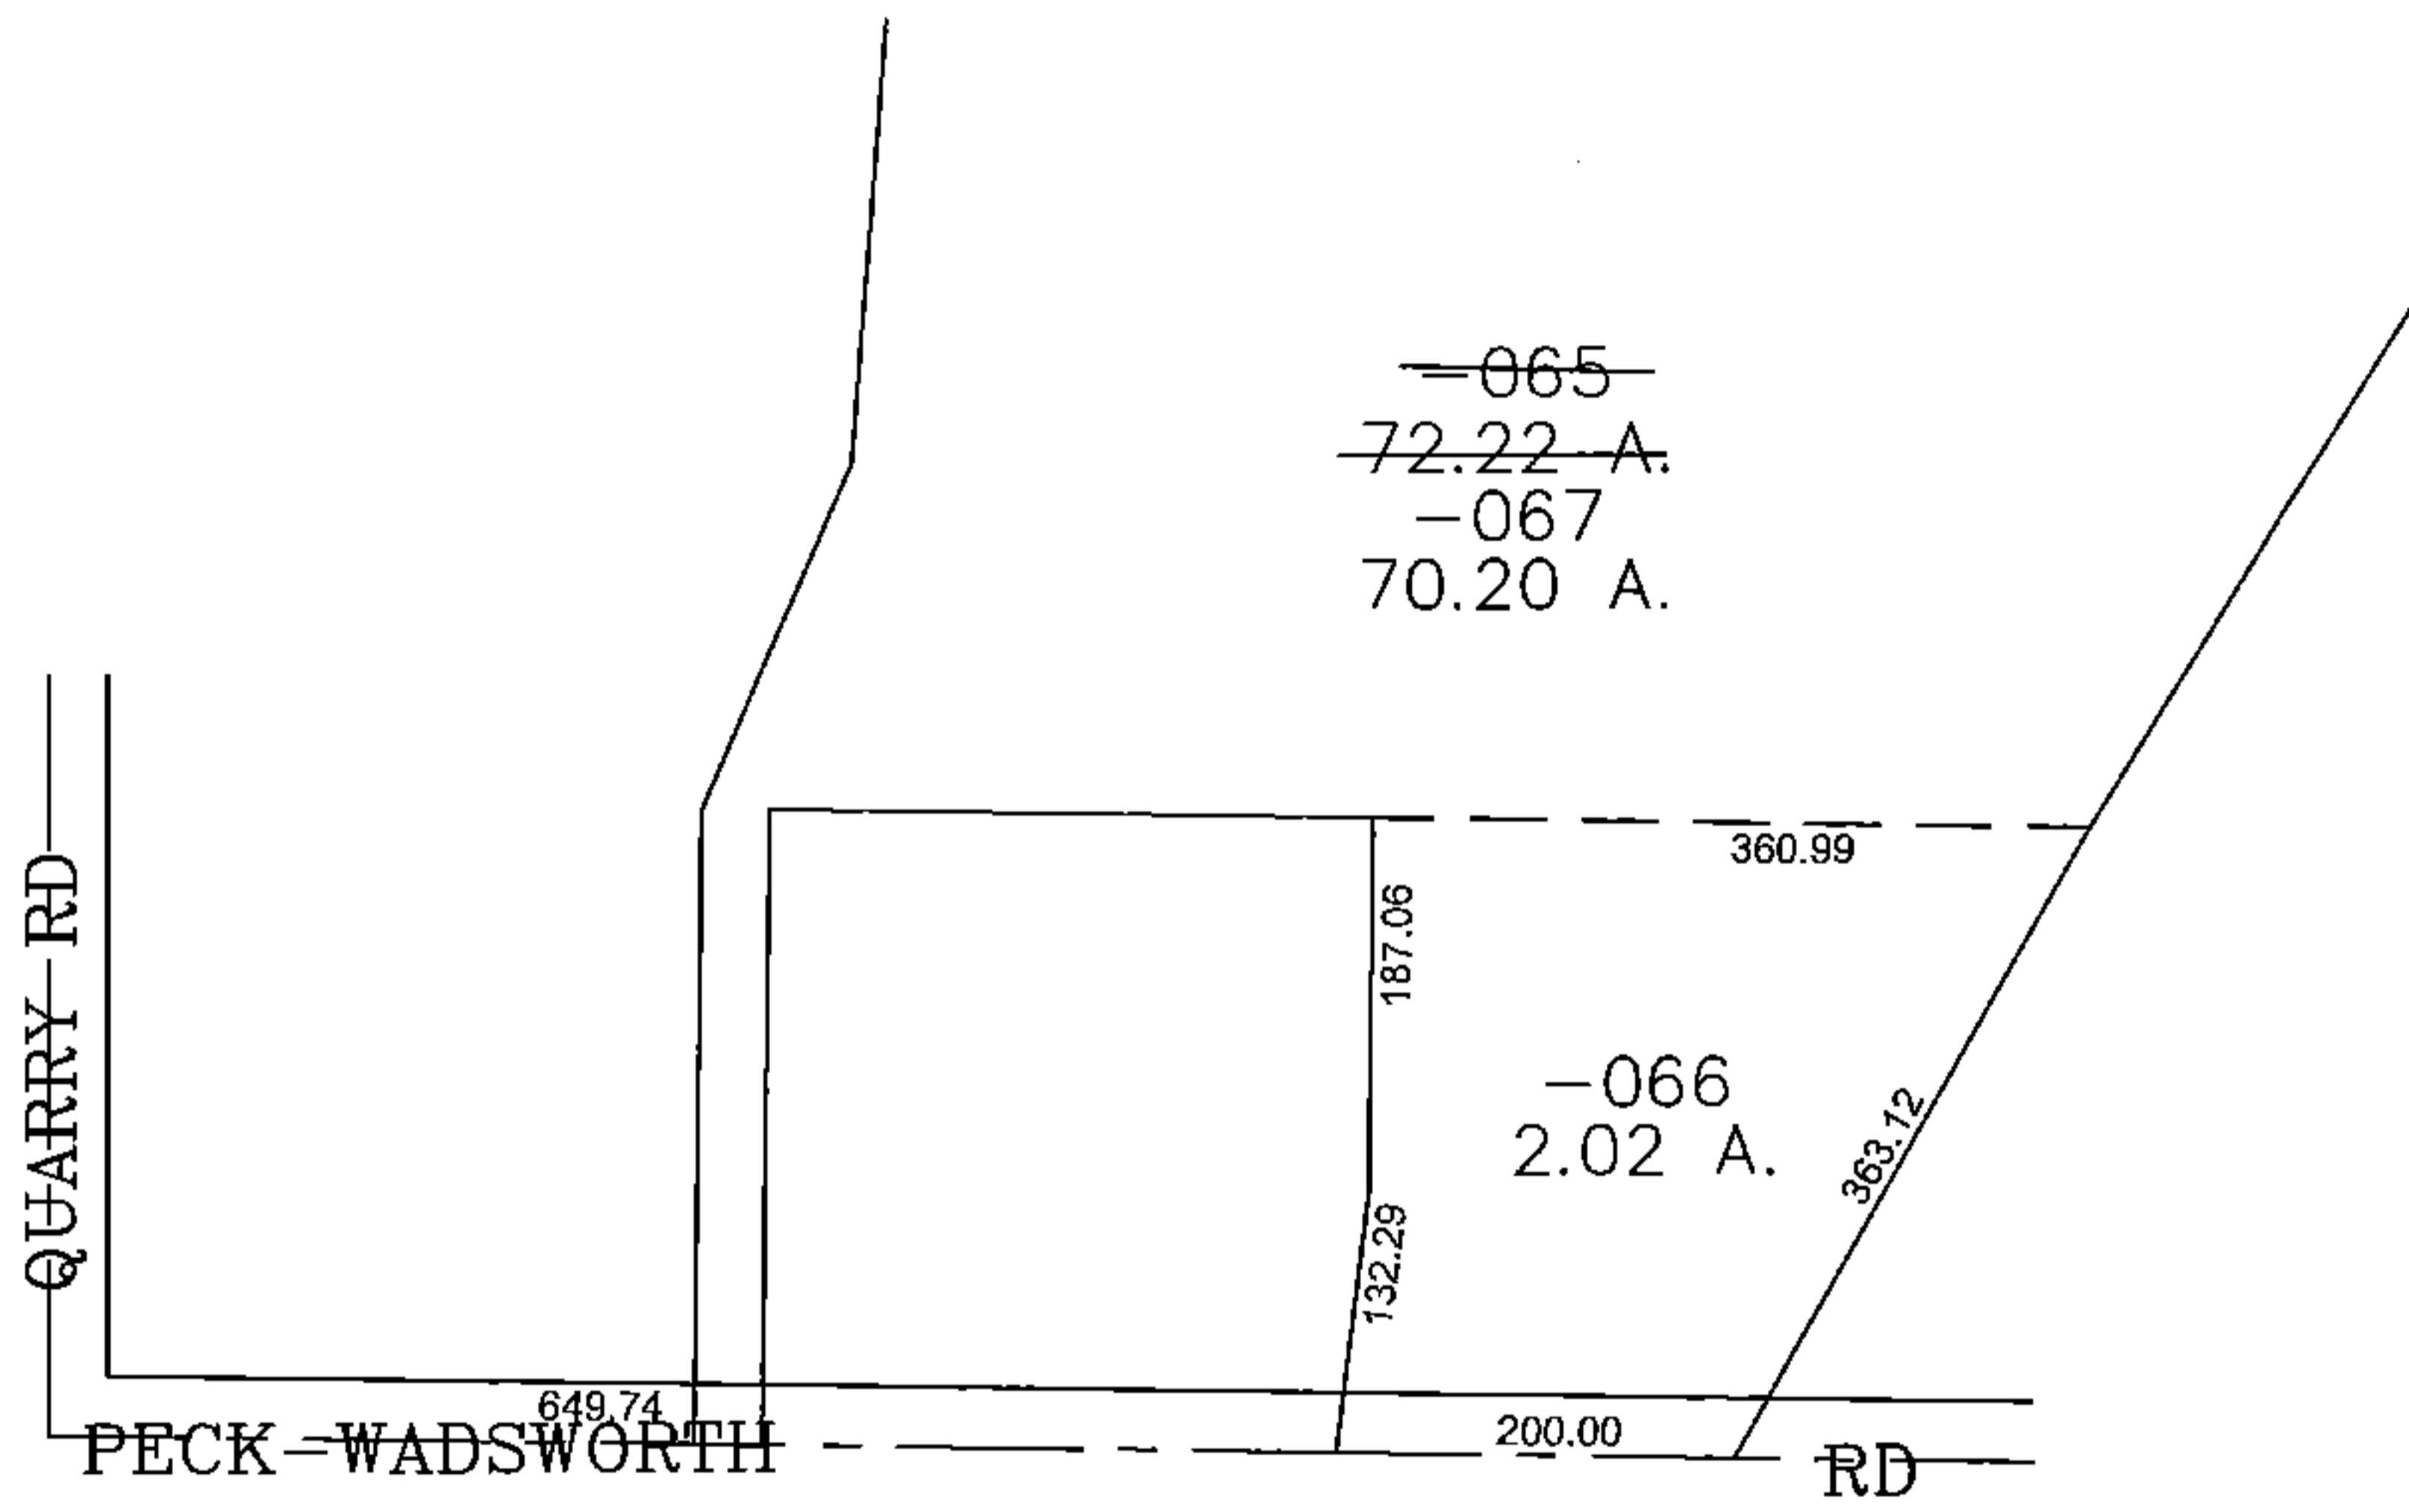


PARENT PARCEL: 18-00-043-000-065

CHILD PARCEL: 18-00-043-000-066, -067

STARTING POINT: CENTERLINE OF PECK-WADSWORTH RD & QUARRY RD

15-03383

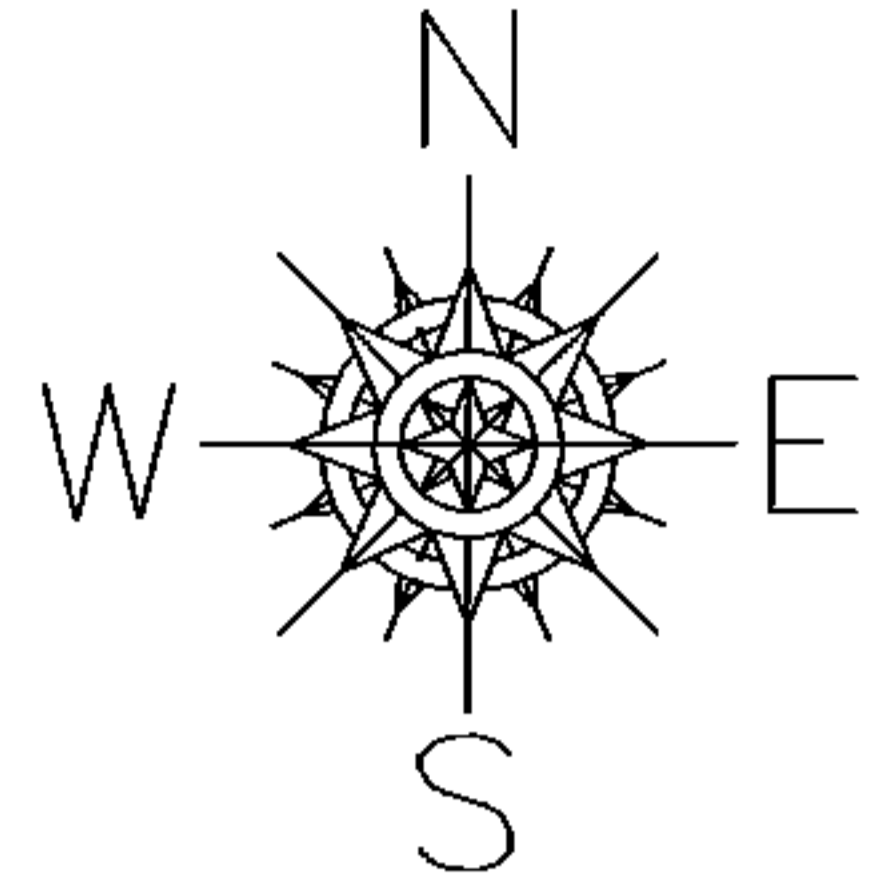

SPLITS/DEEDS PROCESSED
 LORAIN COUNTY TAX MAP DEPARTMENT
 226 MIDDLE AVE. ELYRIA, OHIO

SURVEYED BY: THOMAS SNEZEK
 CLOSURE: 0.00 : 10,000
 MAP PAGE(S): 18-00-043
 APPROVED BY: JAH DATE: 6/29/2015
 SCALE: 1" = 200' PRIOR INSTRUMENT: 20140522031