
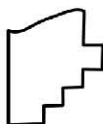
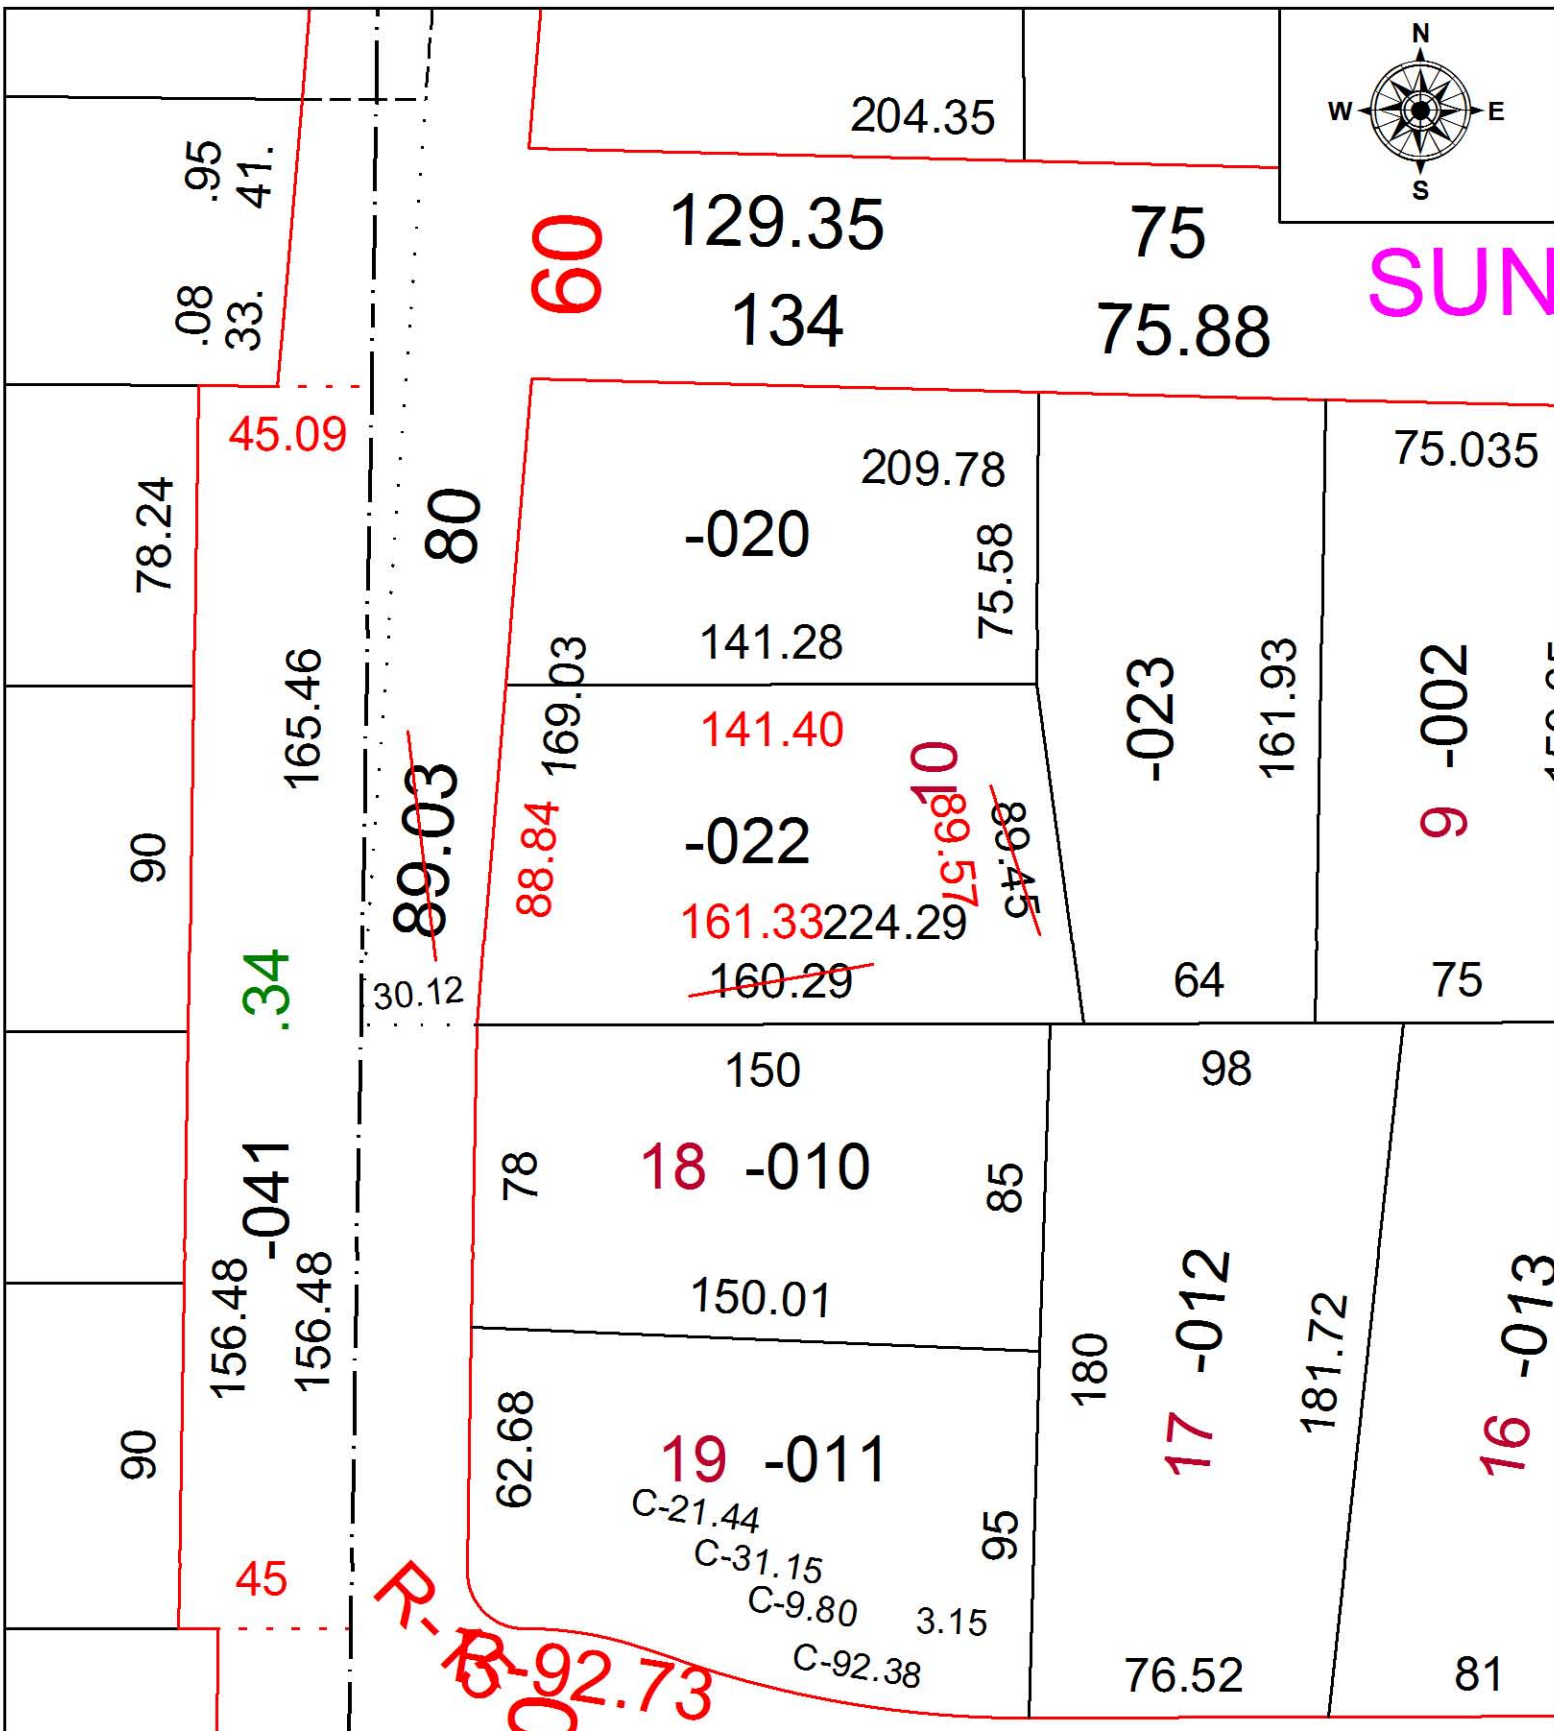


PARENT PARCEL: 05-00-022-105-022

CHILD PARCEL: XX-XX-XXX-XXX-XXX

STARTING POINT: INTERSECTION OF C/L OF SUNRISE DR. AND C/L OF KOLBE RD.

16-03384-D

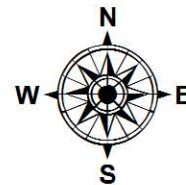

SPLITS/DEEDS PROCESSED
 LORAIN COUNTY TAX MAP DEPARTMENT
 226 MIDDLE AVE. ELYRIA, OH

SURVEYED BY: SCOTT J. CASEY
 CLOSURE: 1: 61,460
 MAP PAGE(S): 5-00-022-A
 APPROVED BY: RRM DATE: 2-12-16
 SCALE: 1" = 50 PRIOR INSTRUMENT: 20160573070