
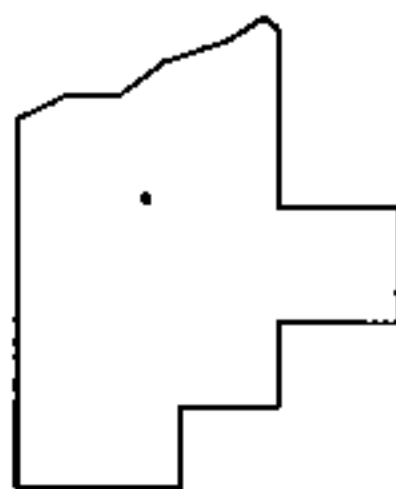
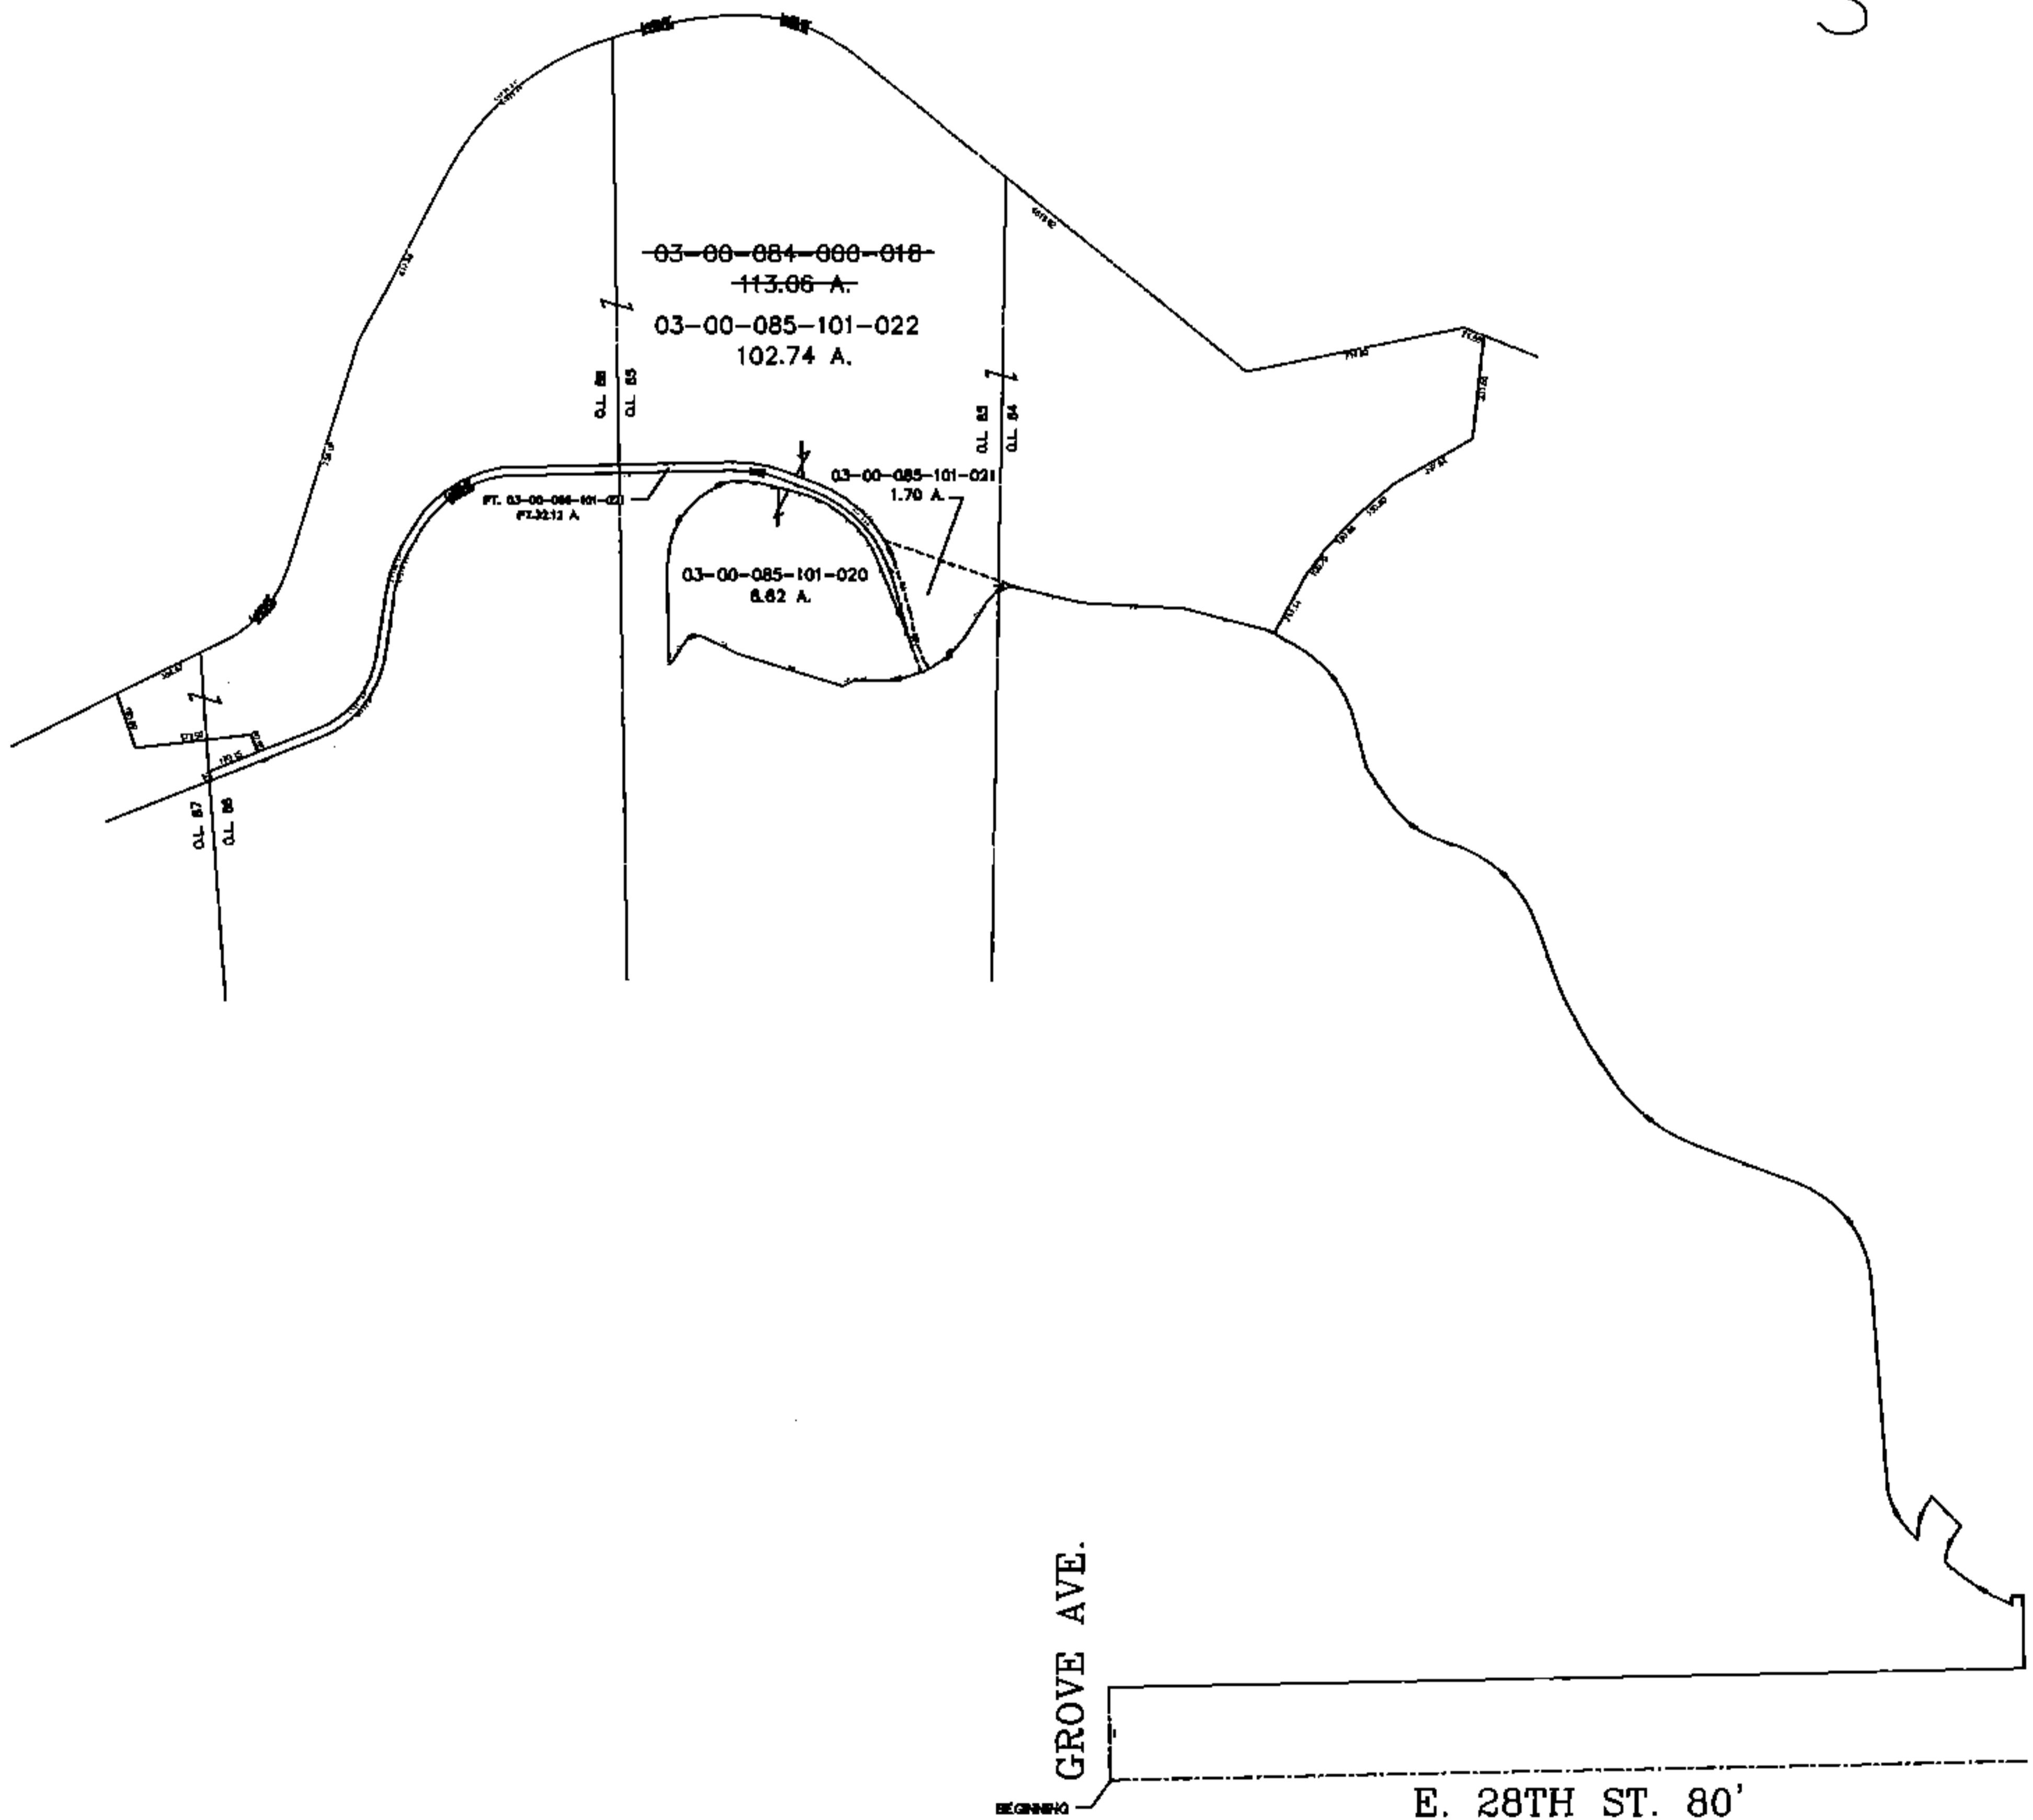


PARENT PARCEL: 03-00-084-000-018

CHILD PARCEL: 03-00-084-000-020 THRU -022

STARTING POINT: CENTERLINE OF GROVE AVE. & EAST 28TH ST.

15-03385

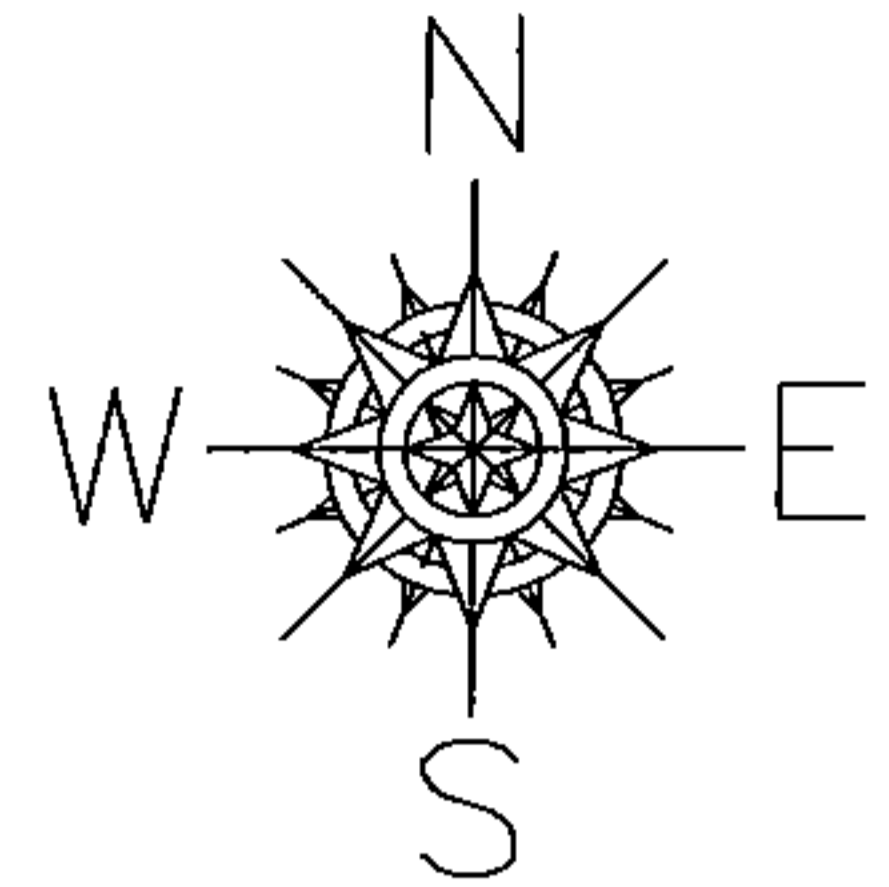

SPLITS/DEEDS PROCESSED

LORAIN COUNTY TAX MAP DEPARTMENT
226 MIDDLE AVE. ELYRIA, OHIO

SURVEYED BY: MICHAEL STRAUB & DOUG HASSEL
CLOSURE: 0.00 : 10.000
MAP PAGE(S): 3-E, 3-F
APPROVED BY: JAH DATE: 3-11-02
SCALE: 1" = 900 PRIOR INSTRUMENT: 20020850503