


PARENT PARCEL: 04-00-025-000-034

CHILD PARCEL: XX-XX-XXX-XXX-XXX

16-03386-X

STARTING POINT: INTERSECTION OF C/L OF WILLIAMS CT. AND NORTH LINE OF SECTION 25

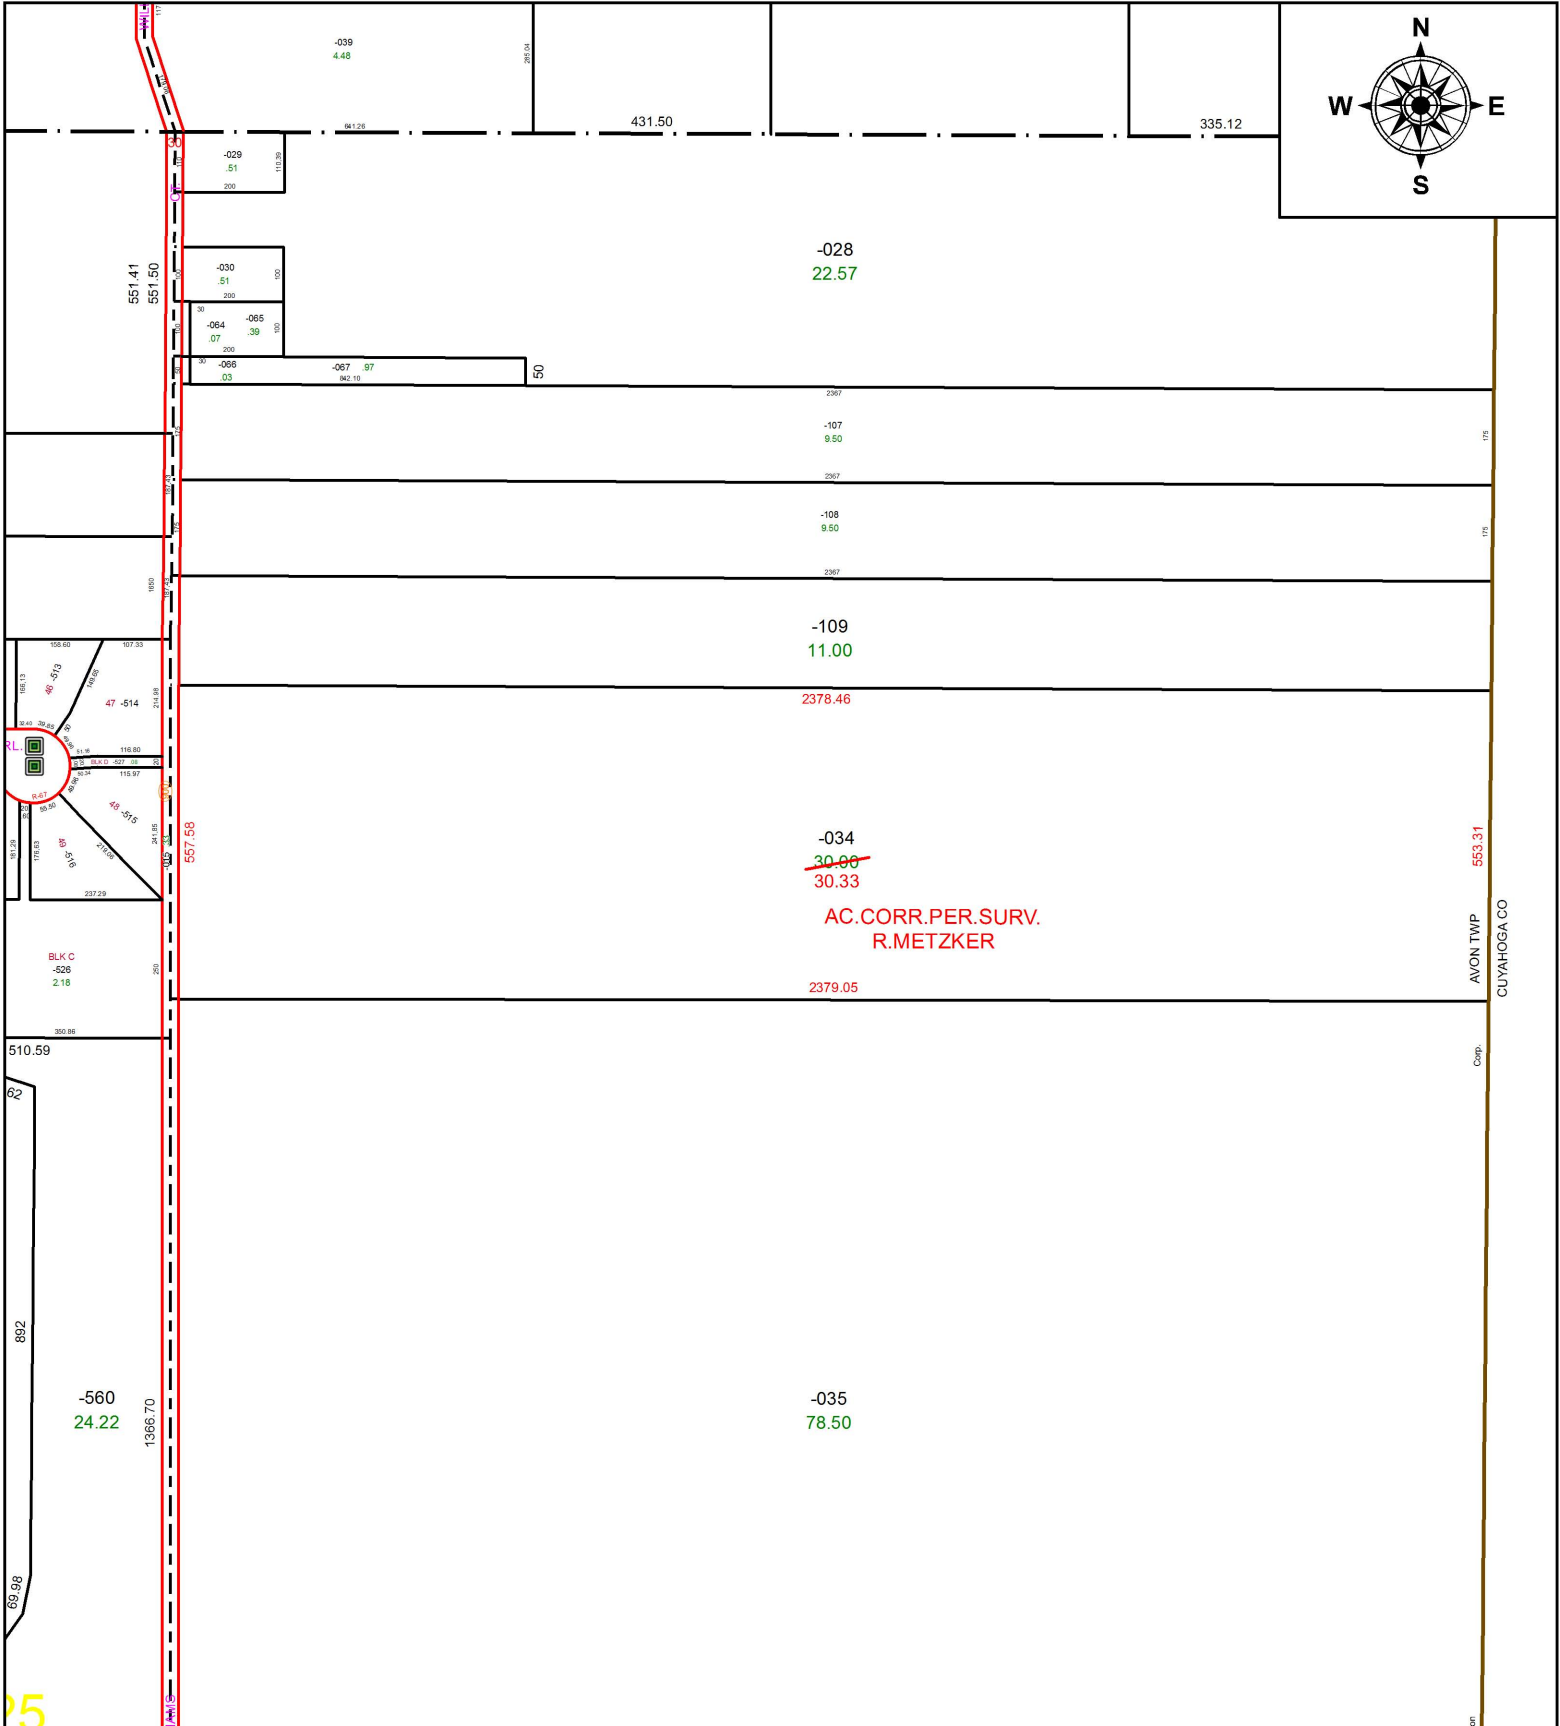

25



SPLITS/DEEDS PROCESSED
 LORAIN COUNTY TAX MAP DEPARTMENT
 226 MIDDLE AVE. ELYRIA, OH

SURVEYED BY: RICHARD METZKER

CLOSURE: 1: 809,160

MAP PAGE(S): 4-00-025

APPROVED BY: RRM DATE: 2-22-16

SCALE: 1" = 350 PRIOR INSTRUMENT: 20090309443