
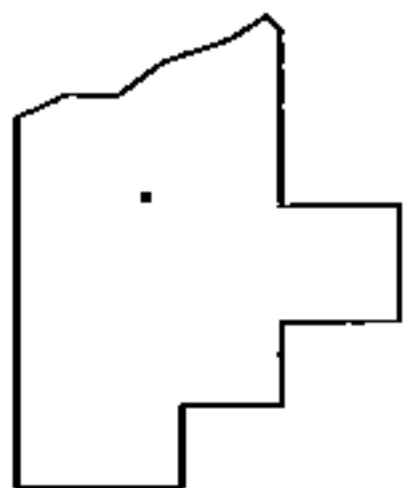
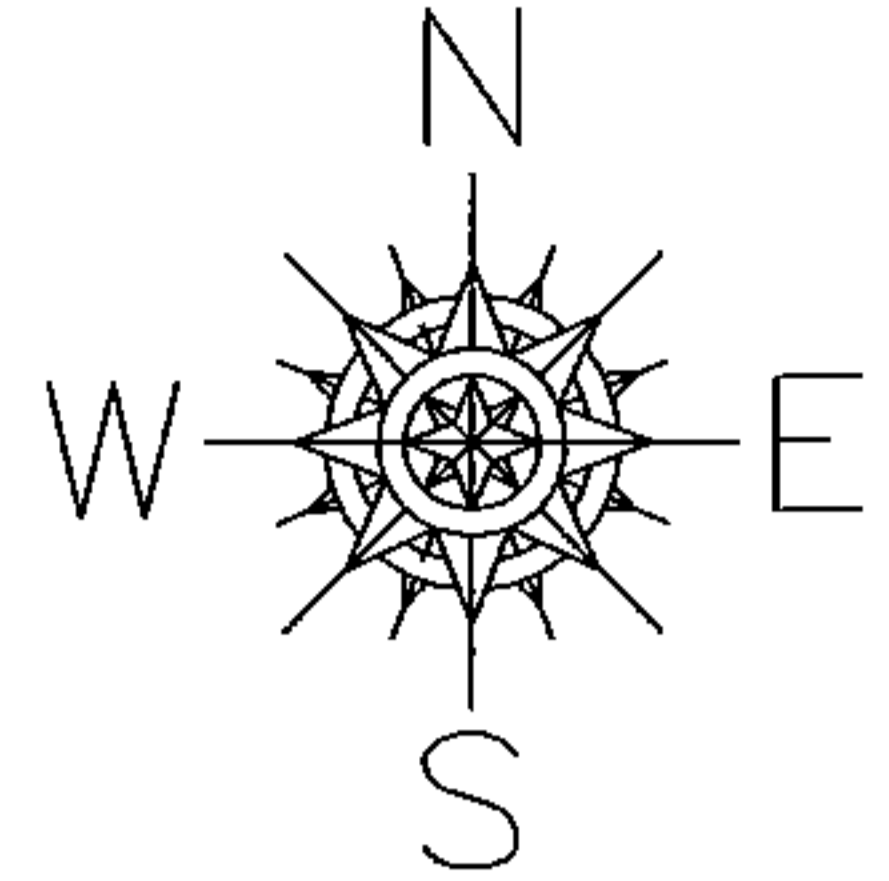


PARENT PARCEL: 07-00-003-102-084

CHILD PARCEL: 07-00-003-102-093, -094

STARTING POINT: XXXXXX

15-03389

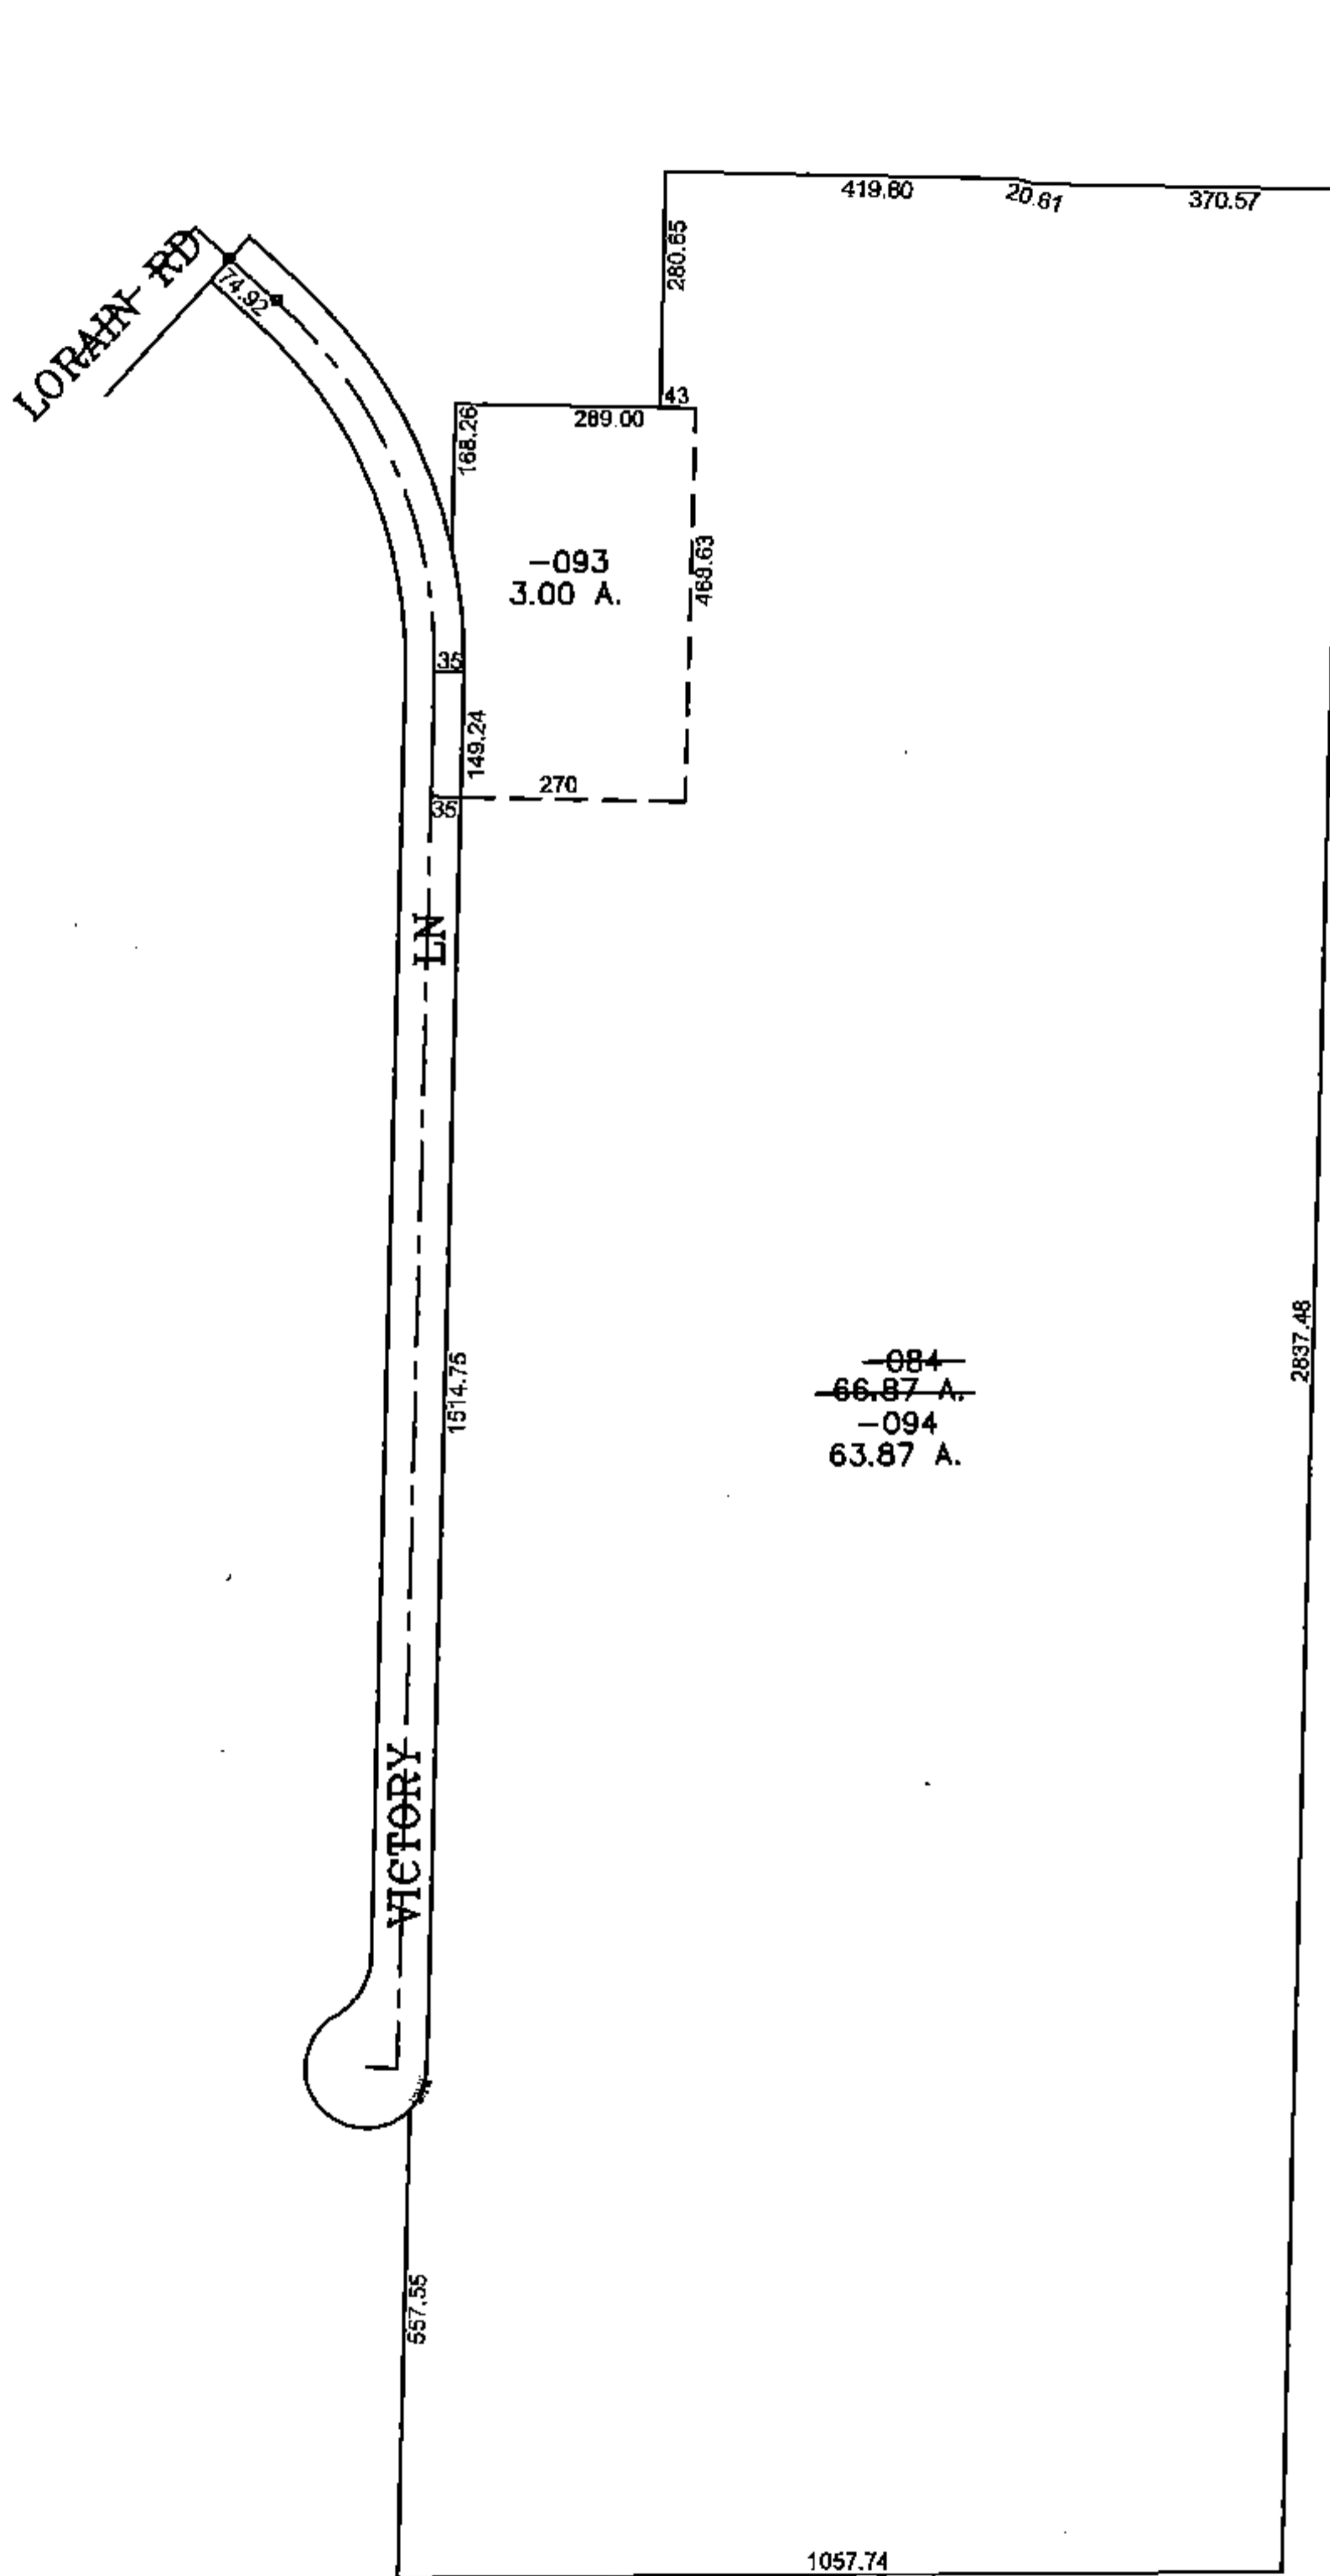

**SPLITS/DEEDS PROCESSED**

LORAIN COUNTY TAX MAP DEPARTMENT  
226 MIDDLE AVE. ELYRIA, OHIO

SURVEYED BY: HOWARD SELEE

CLOSURE: 0.00 : 10,000

MAP PAGE(S): 07-00-003

APPROVED BY: JAH DATE: 7/15/2015

SCALE: 1"= 400 PRIOR INST.: 20060120752