
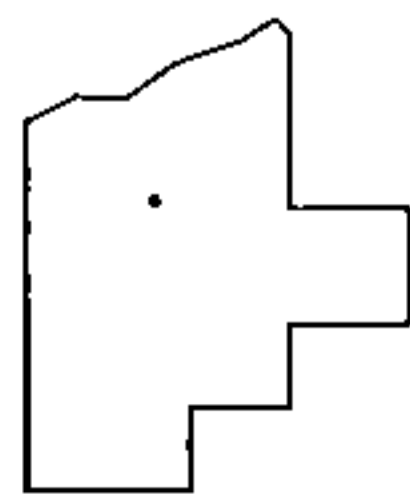
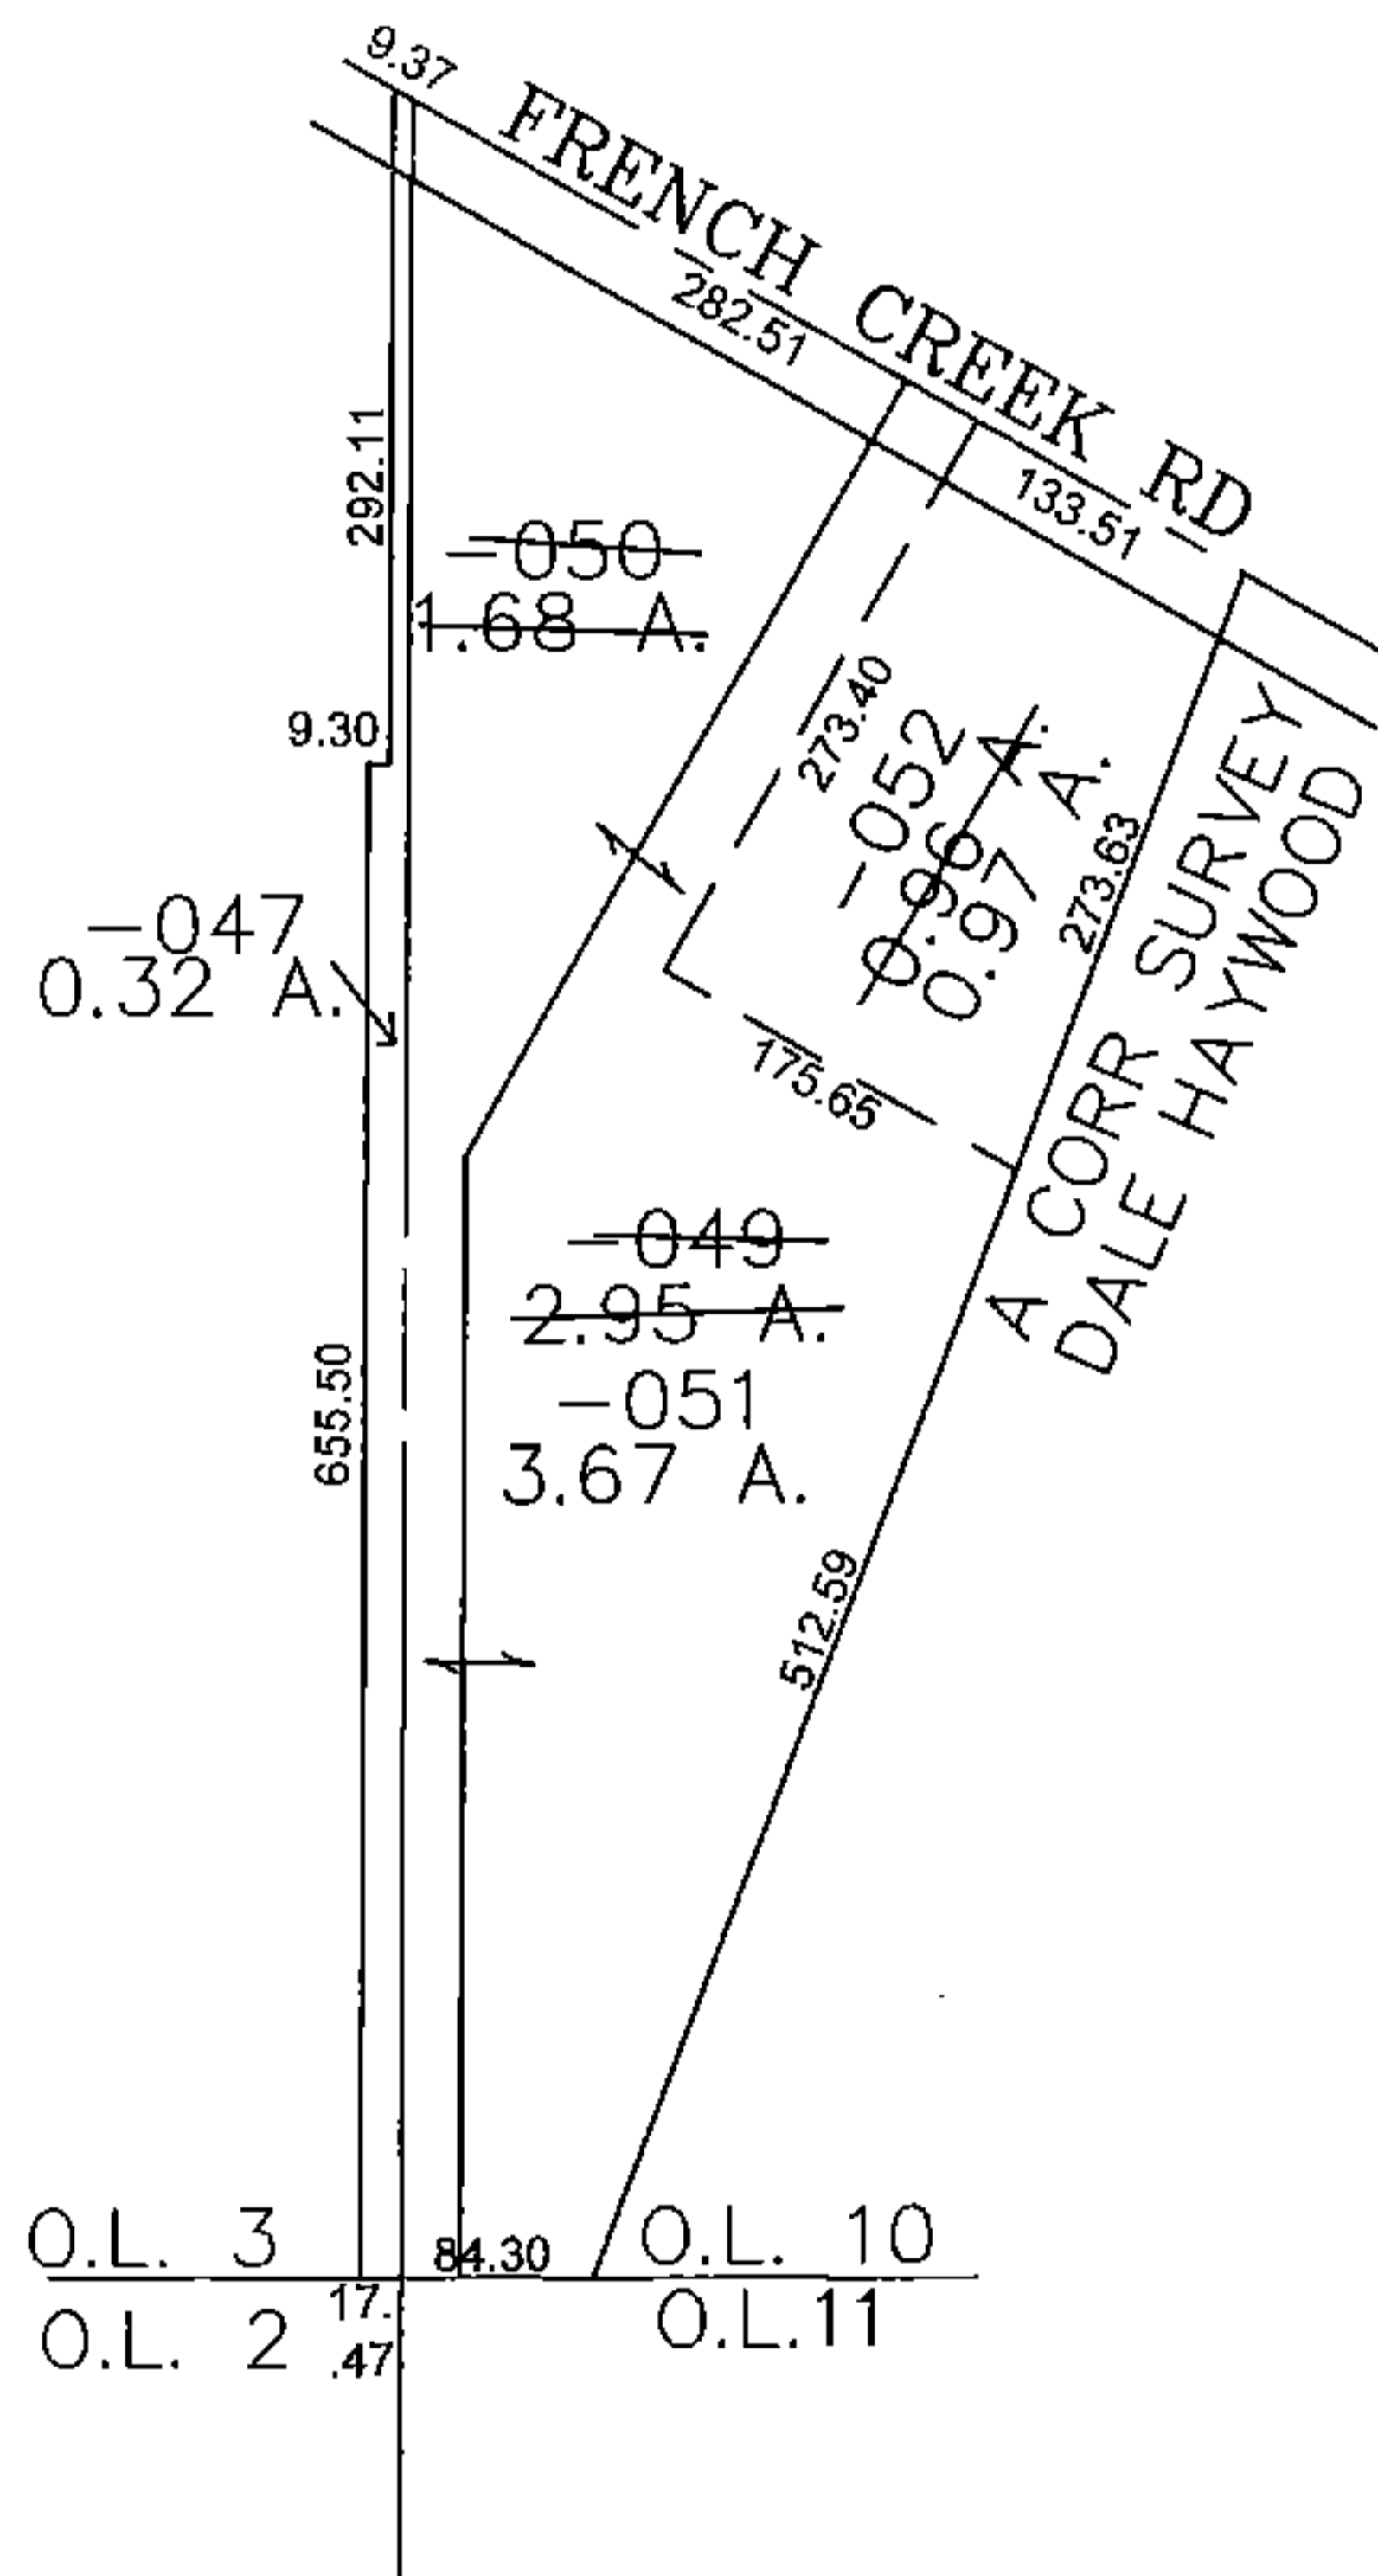


PARENT PARCEL: 04-00-010-114-050, -049 04-00-003-103-047 (ST)

CHILD PARCEL: 04-00-010-114-051, -052

STARTING POINT: CENTERLINE OF FRENCH CREEK RD & O.L. 10

15-03390

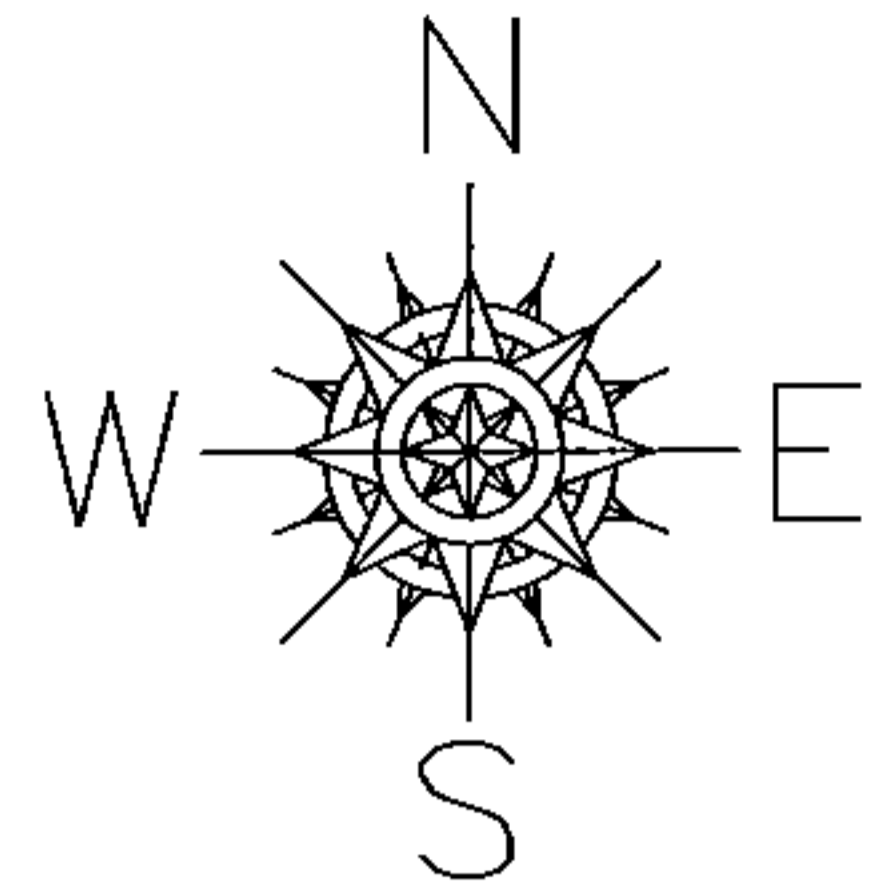

SPLITS/DEEDS PROCESSED
 LORAIN COUNTY TAX MAP DEPARTMENT
 226 MIDDLE AVE. ELYRIA, OHIO

SURVEYED BY: DALE HAYWOOD
 CLOSURE: 0.00 : 10,000
 MAP PAGE(S): 04-00-010-E
 APPROVED BY: JAH DATE: 7/16/2015
 SCALE: 1" = 200' PRIOR INSTRUMENT: 20140509172