
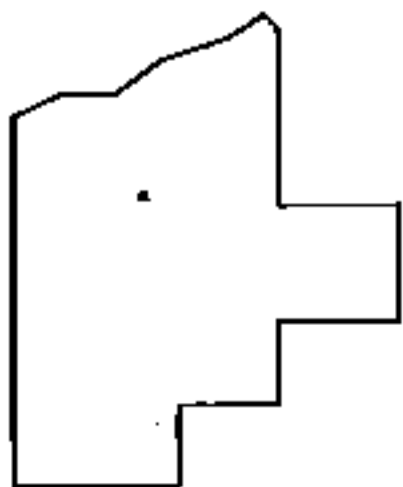
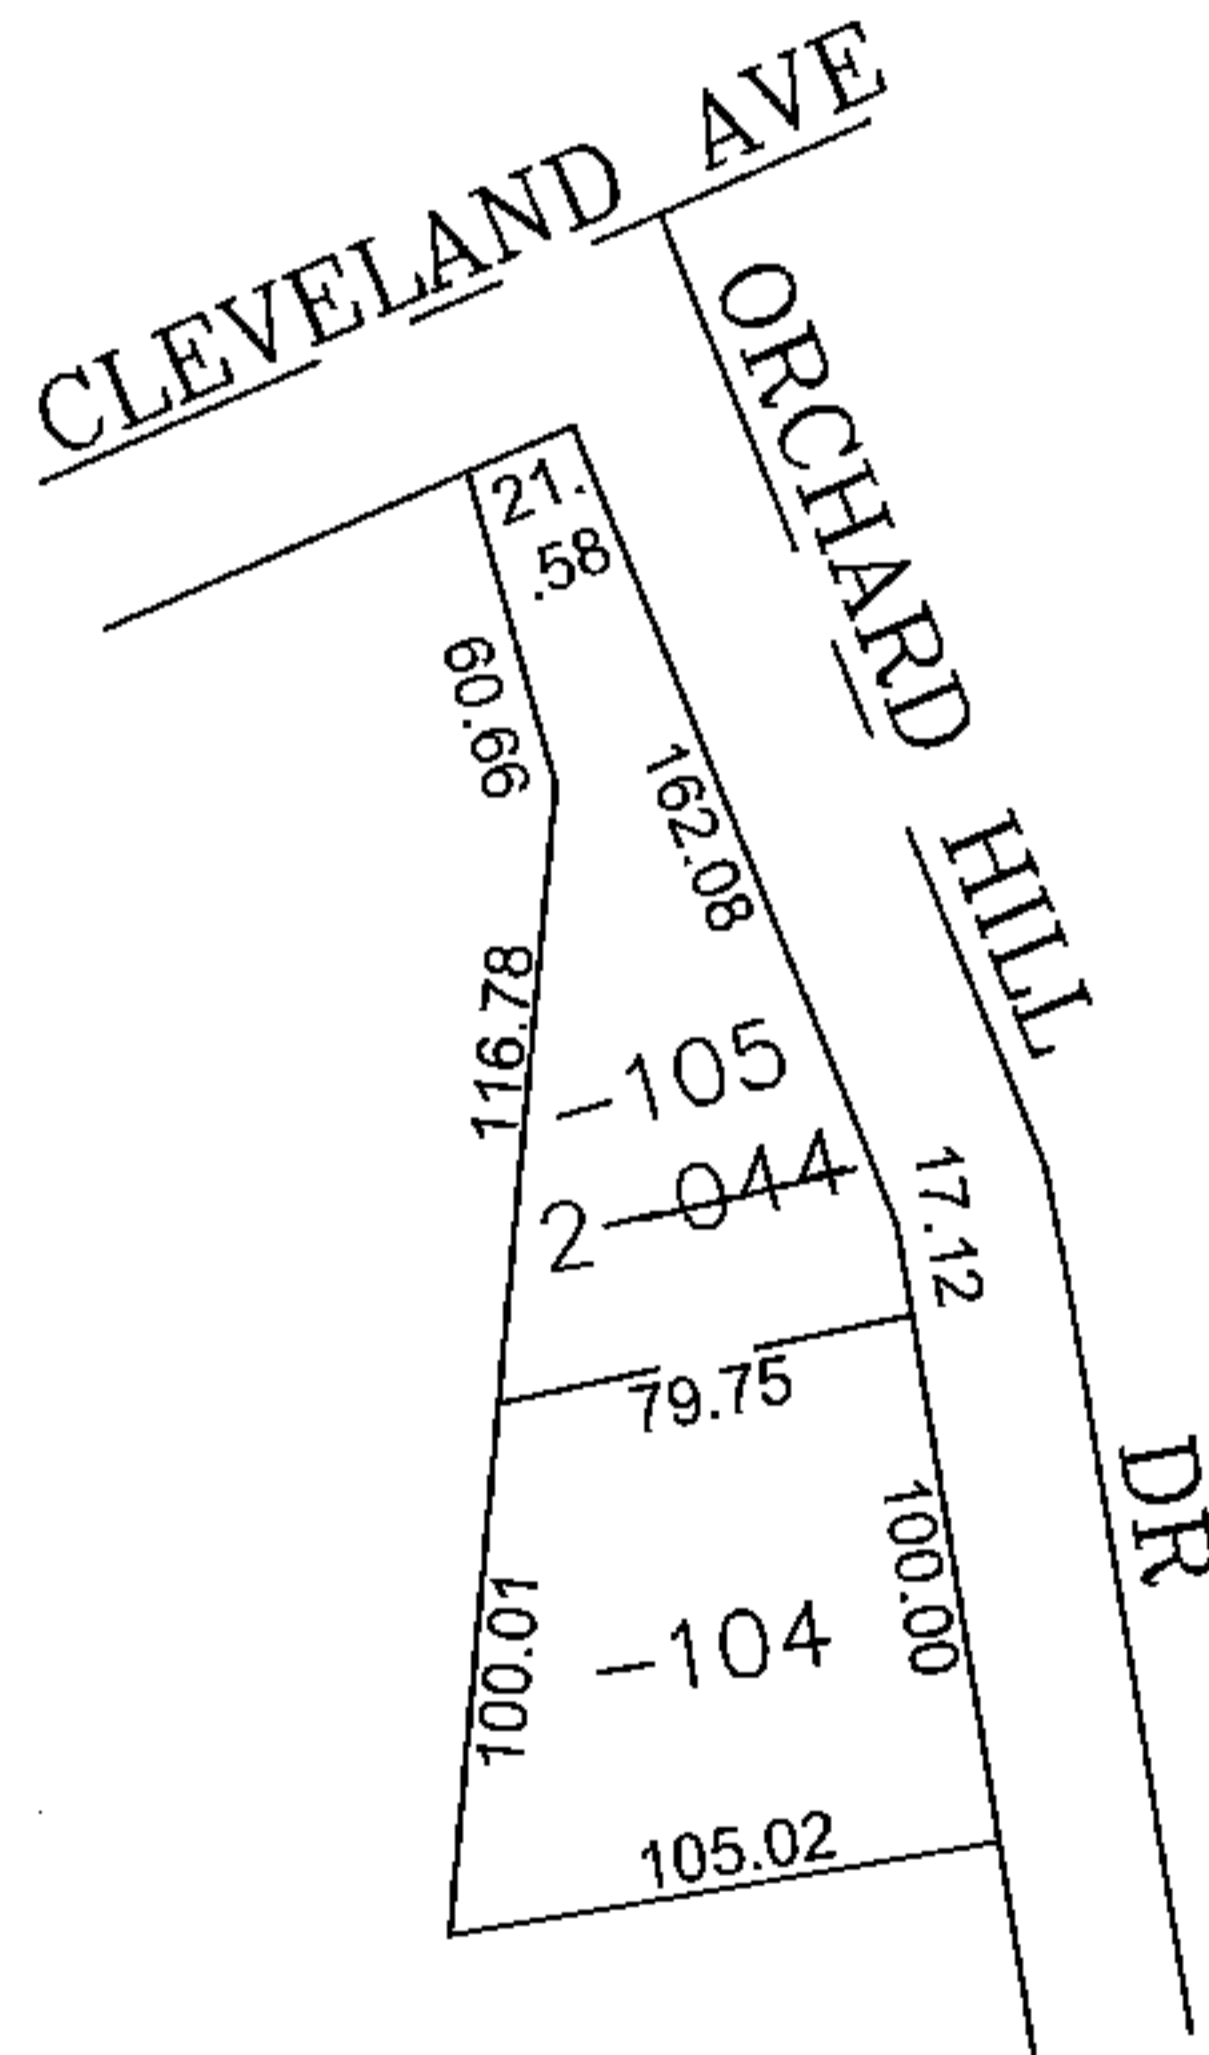


PARENT PARCEL: 05-00-038-106-044

CHILD PARCEL: 05-00-038-106-104, -105

STARTING POINT: SIDELINE OF CLEVELAND AVE & ORCHARD HILL DR

15-03391

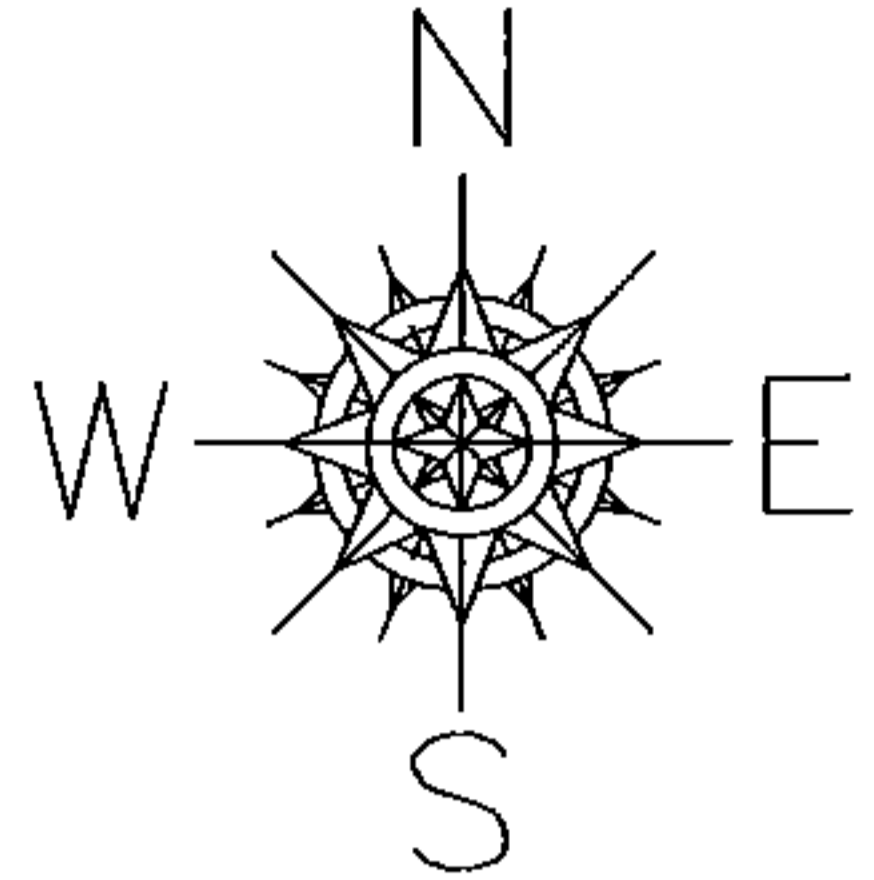

SPLITS/DEEDS PROCESSED

LORAIN COUNTY TAX MAP DEPARTMENT
226 MIDDLE AVE. ELYRIA, OHIO

SURVEYED BY: JAMES A RESAR

CLOSURE: 0.00 : 10.000

MAP PAGE(S): 05-00-038-B

APPROVED BY: JAH DATE: 7/16/2015

SCALE: 1" = 100 PRIOR INSTRUMENT: 20020812722