
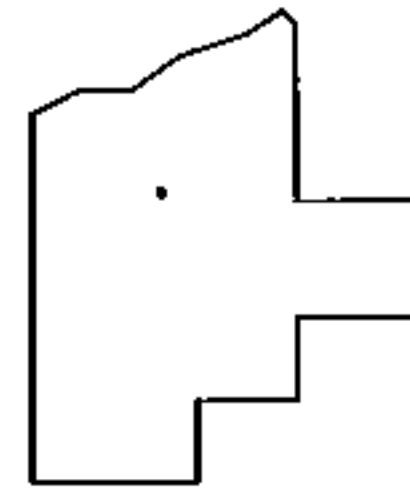
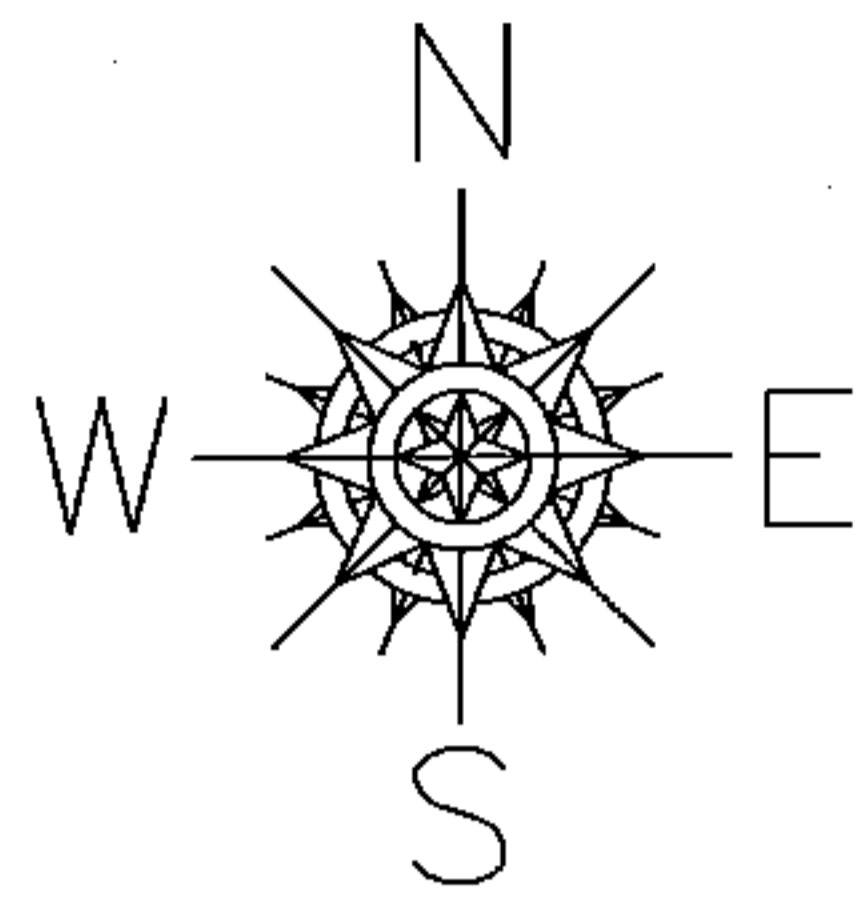


PARENT PARCEL: 11-00-089-000-090, -089, 11-00-090-000-021  
 CHILD PARCEL: 11-00-089-000-134, -135, -136 11-00-090-000-021  
 STARTING POINT: CENTERLINE OF CHESTNUT RIDGE RD & BENDER RD

15-03392

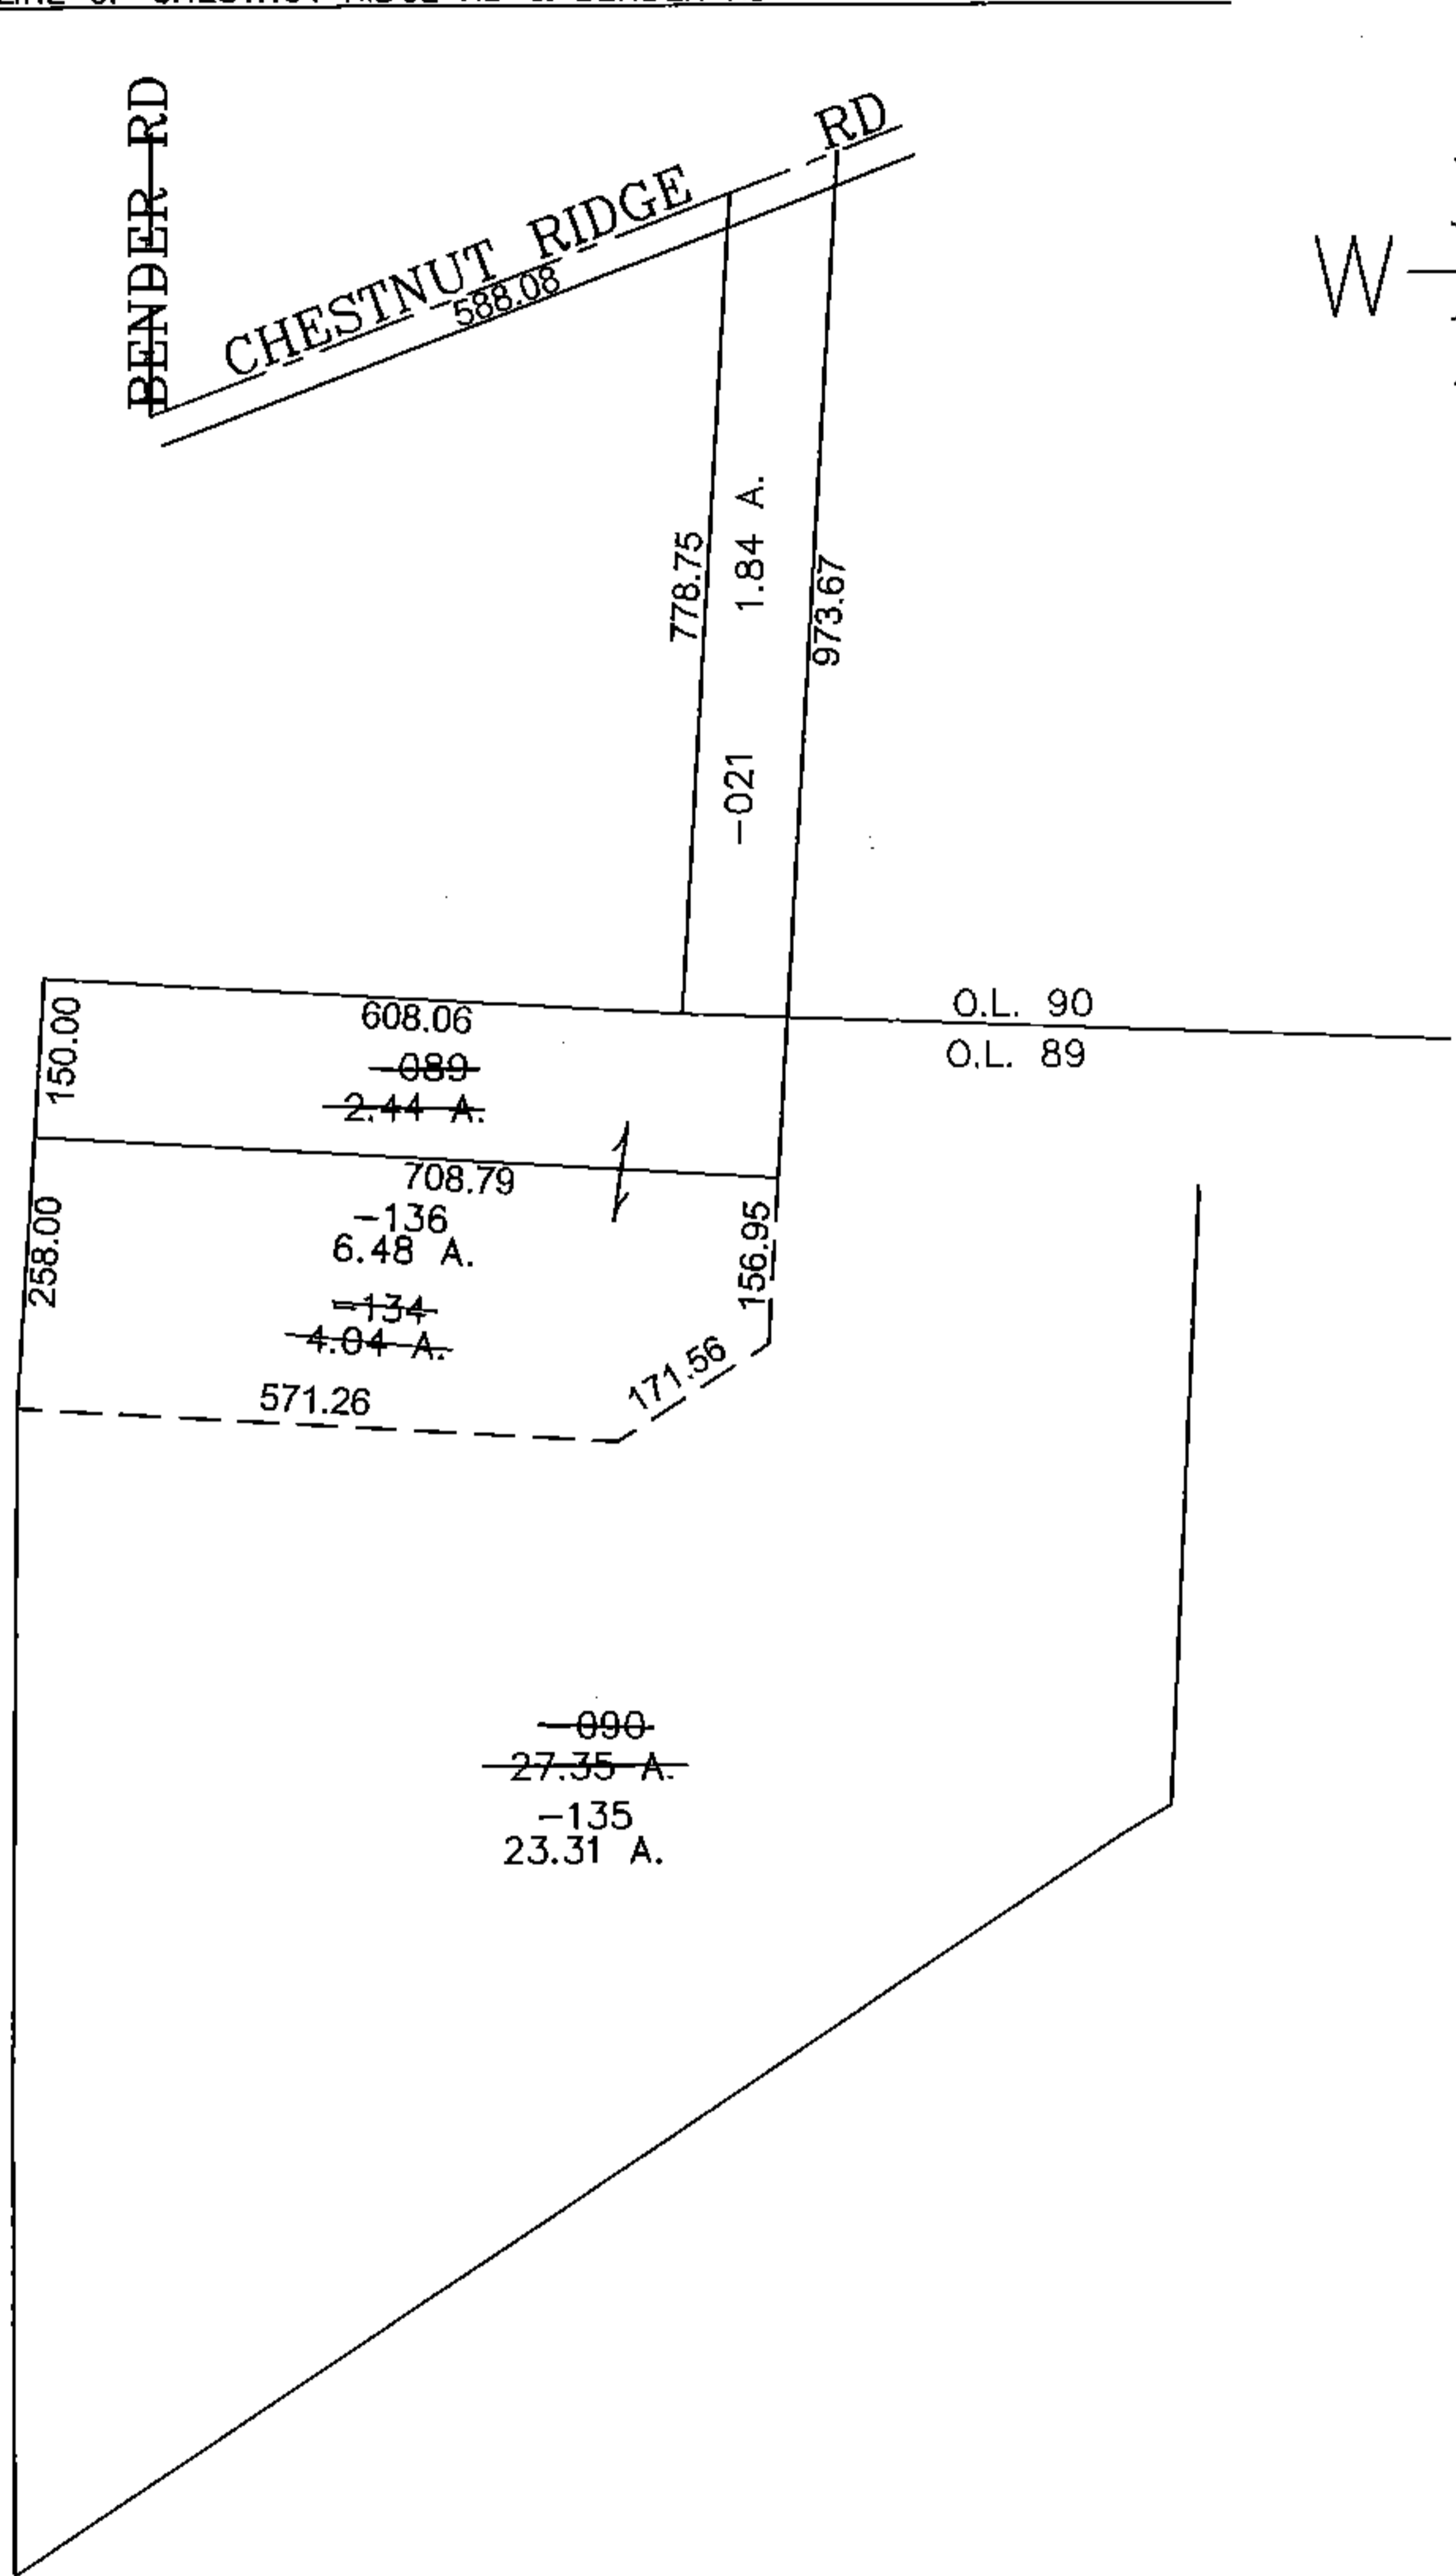

**SPLITS/DEEDS PROCESSED**  
 LORAIN COUNTY TAX MAP DEPARTMENT  
 226 MIDDLE AVE. ELYRIA, OHIO

SURVEYED BY: DALE HAYWOOD  
 CLOSURE: 0.00 : 10.000  
 MAP PAGE(S): 11-A  
 APPROVED BY: JAH DATE: 7-17-2015  
 SCALE: 1" = 300 PRIOR INSTRUMENT: DV 1255/383