
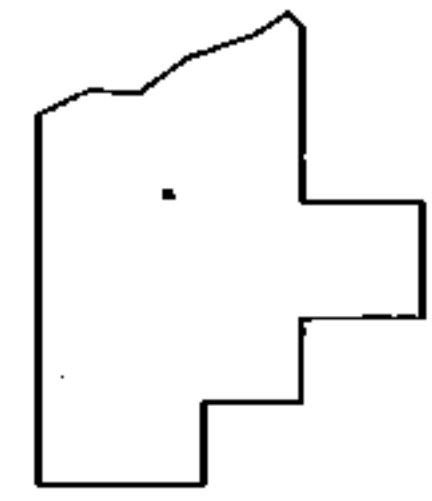
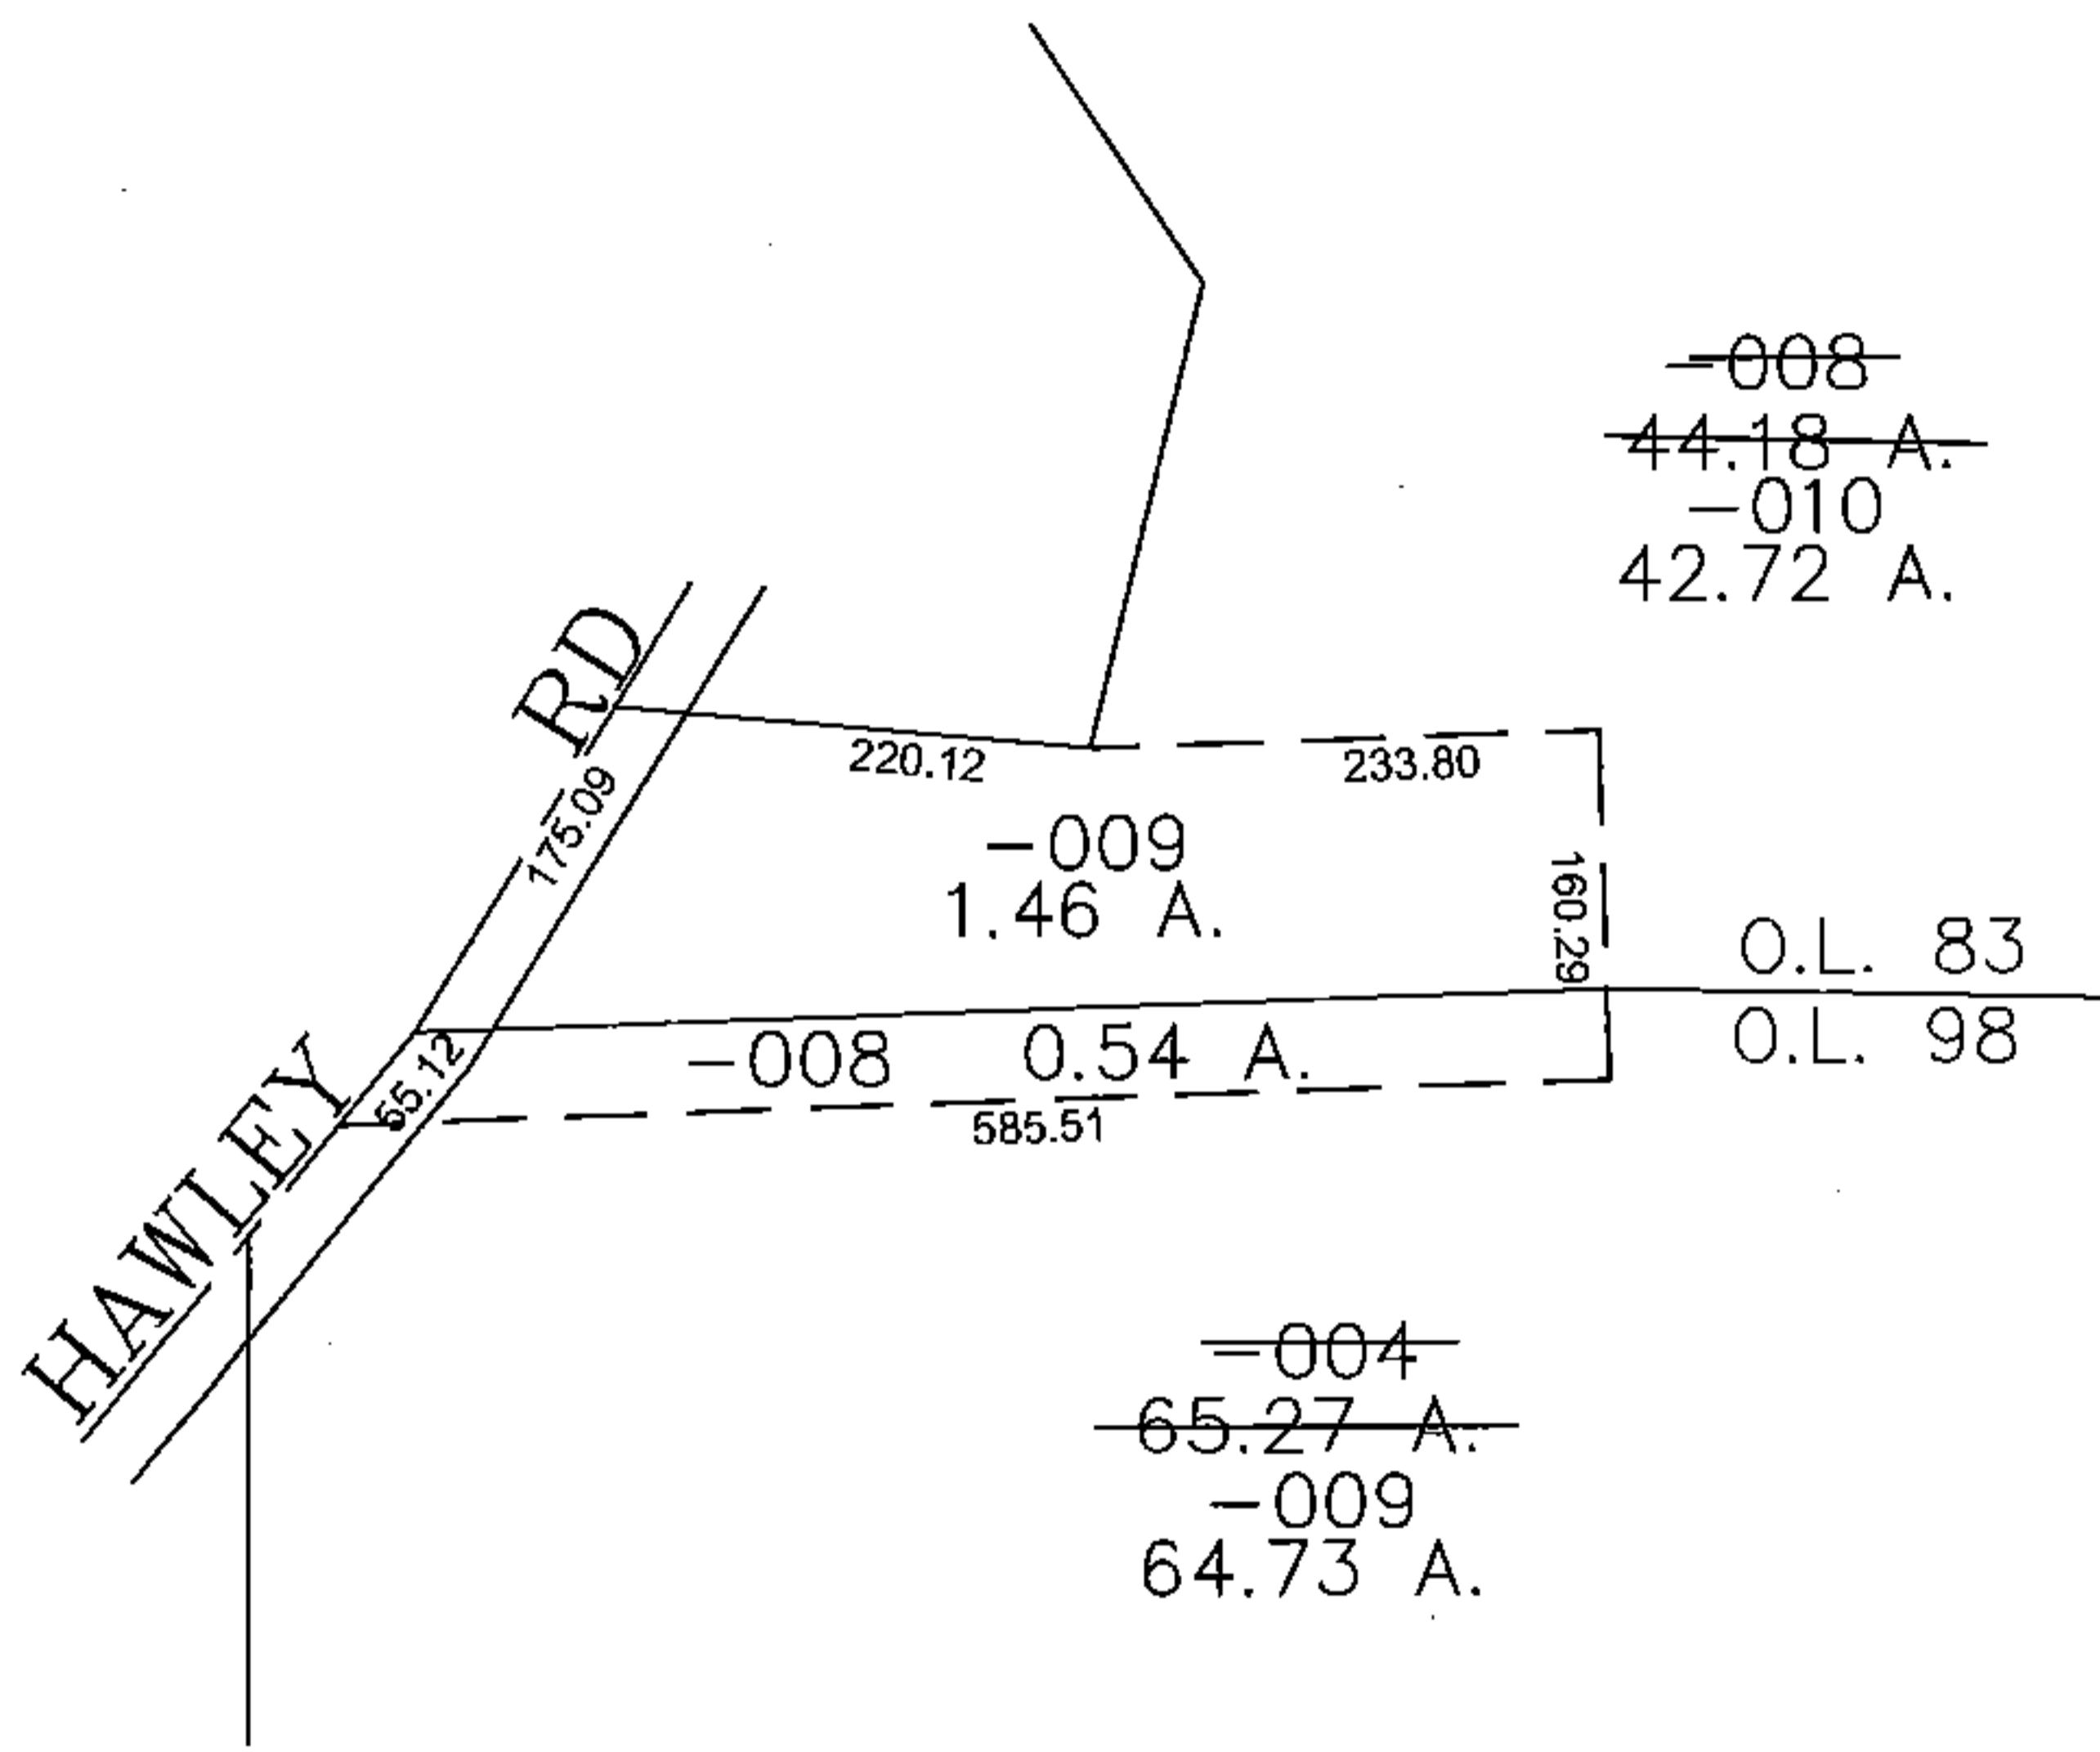


PARENT PARCEL: 14-00-083-000-008, 14-00-098-000-004
 CHILD PARCEL: 14-00-083-000-009, 010 14-00-098-000-008, -009
 STARTING POINT: CENTERLINE OF HAWLEY RD & O.L. 83

15-03393

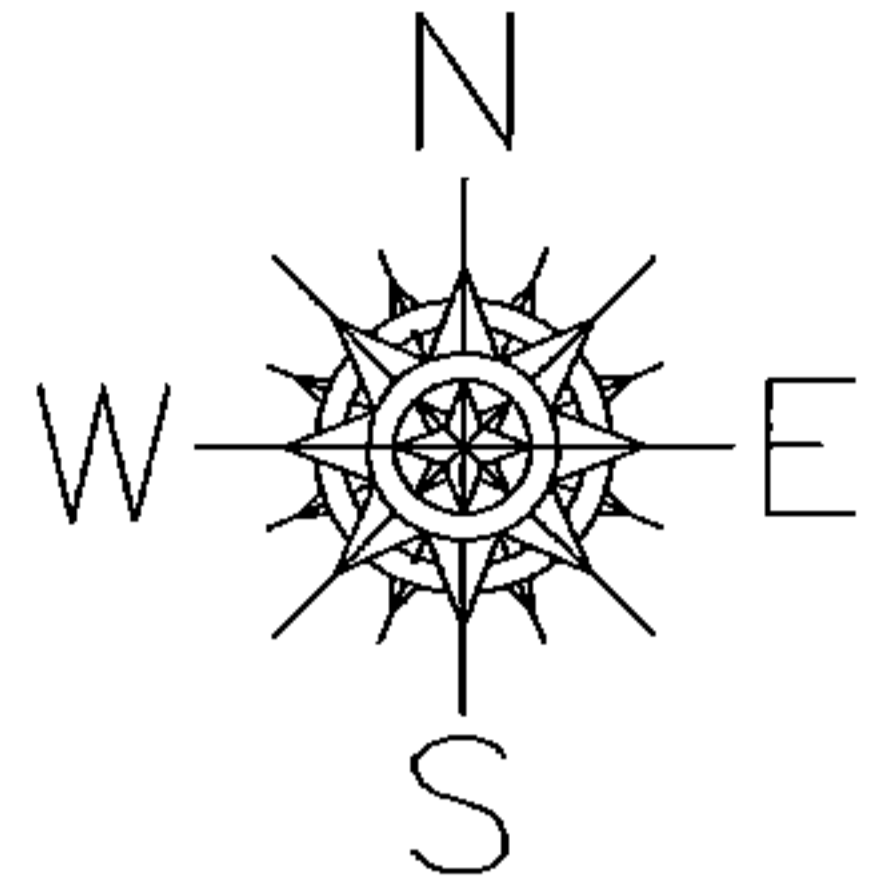

SPLITS/DEEDS PROCESSED
 LORAIN COUNTY TAX MAP DEPARTMENT
 226 MIDDLE AVE. ELYRIA, OHIO

SURVEYED BY: JAMES RESAR
 CLOSURE: 0.00 : 10,000
 MAP PAGE(S): 0.00: 10,000
 APPROVED BY: JAH DATE: 7/17/2015
 SCALE: 1" = 200 PRIOR INSTRUMENT: 20080245445