


PARENT PARCEL: 08-14-006-000-006

CHILD PARCEL: XX-XX-XXX-XXX-XXX



STARTING POINT: SOUTHWEST CORNER OF O.L.6 TR.14

16-03394-A

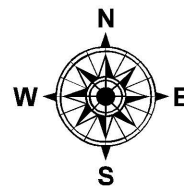

MAP CORRECTION ONLY
CORR. PER SURVEY T,SIMON

1616.5

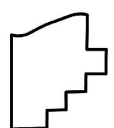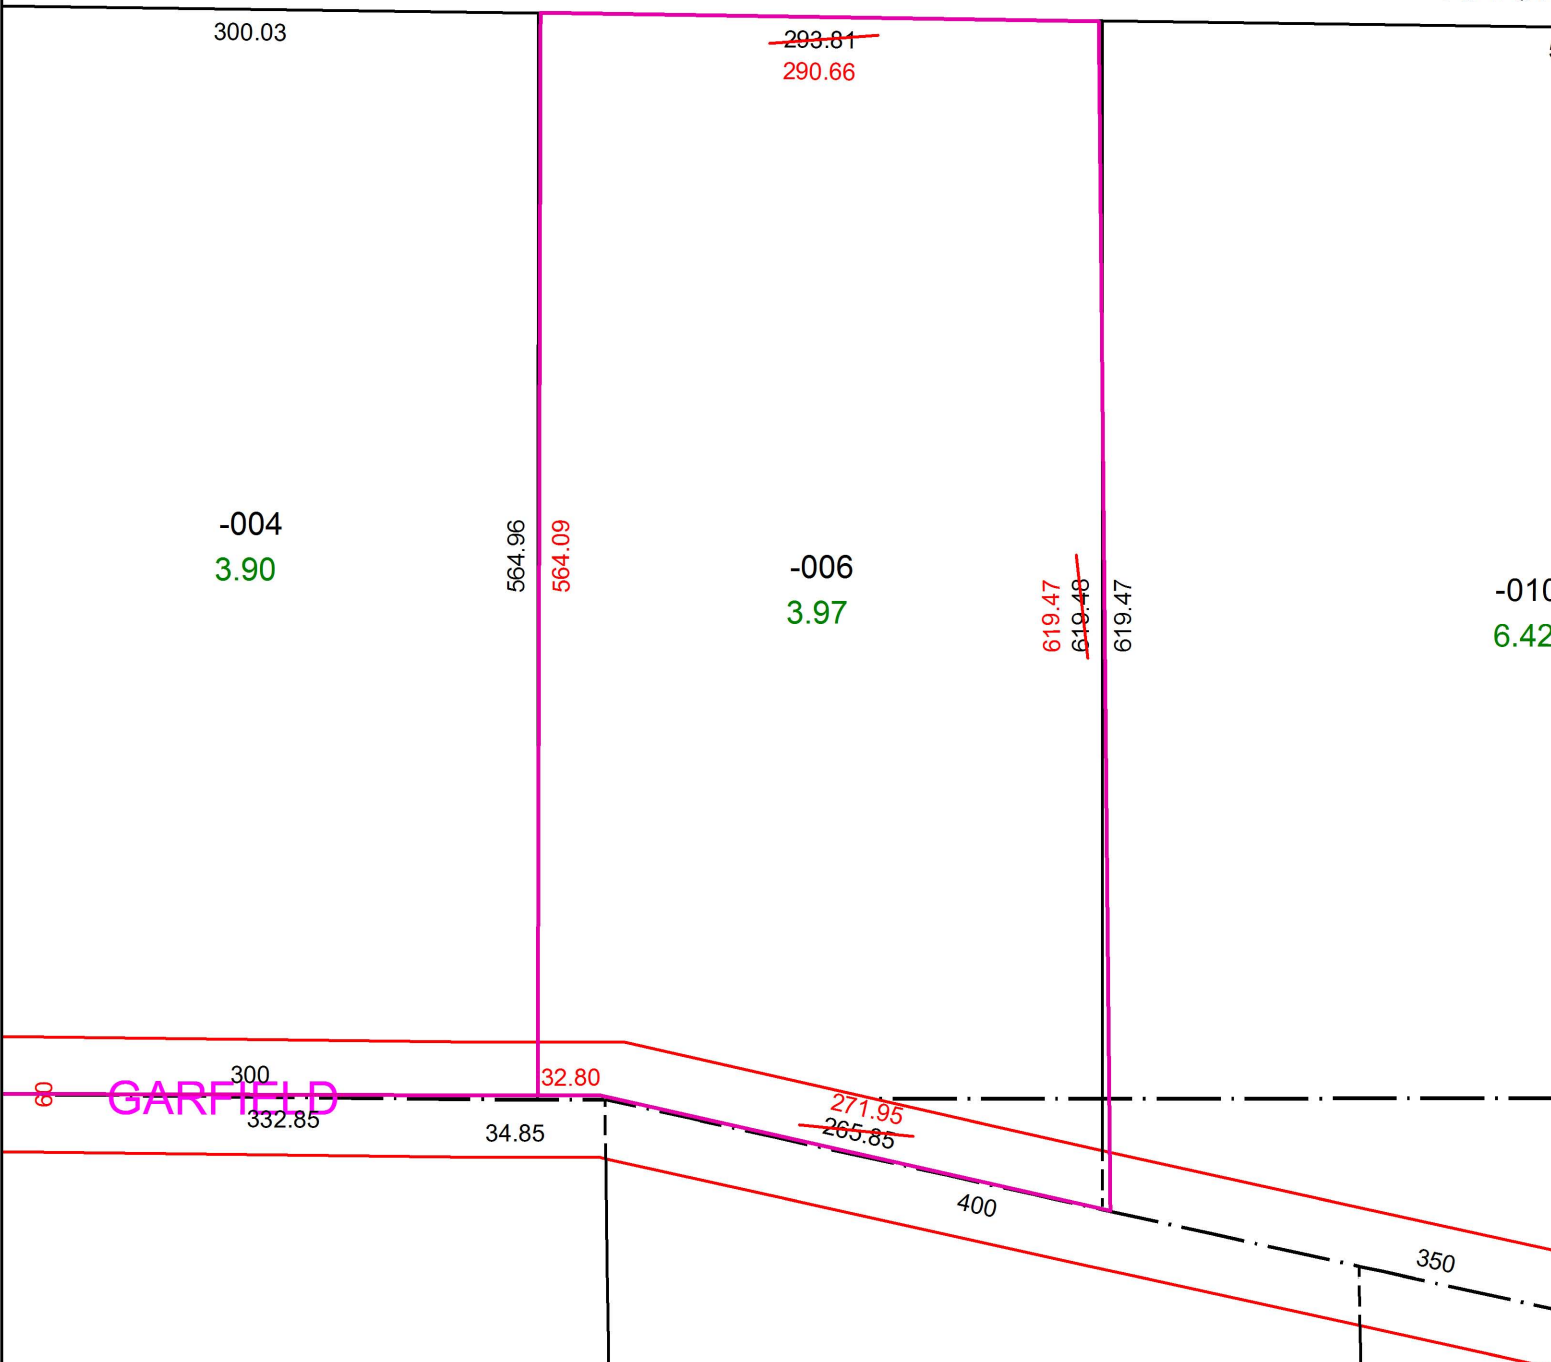

SPLITS/DEEDS PROCESSED
LORAIN COUNTY TAX MAP DEPARTMENT
226 MIDDLE AVE. ELYRIA, OH

SURVEYED BY: THOMAS A. SIMON
CLOSURE: 1:310,329
MAP PAGE(S): 8-B
APPROVED BY: RRM DATE: 3-4-16
SCALE: 1" = 100 PRIOR INSTRUMENT: 20150556428