
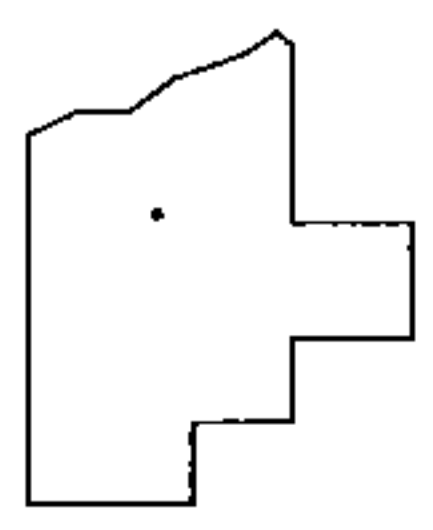
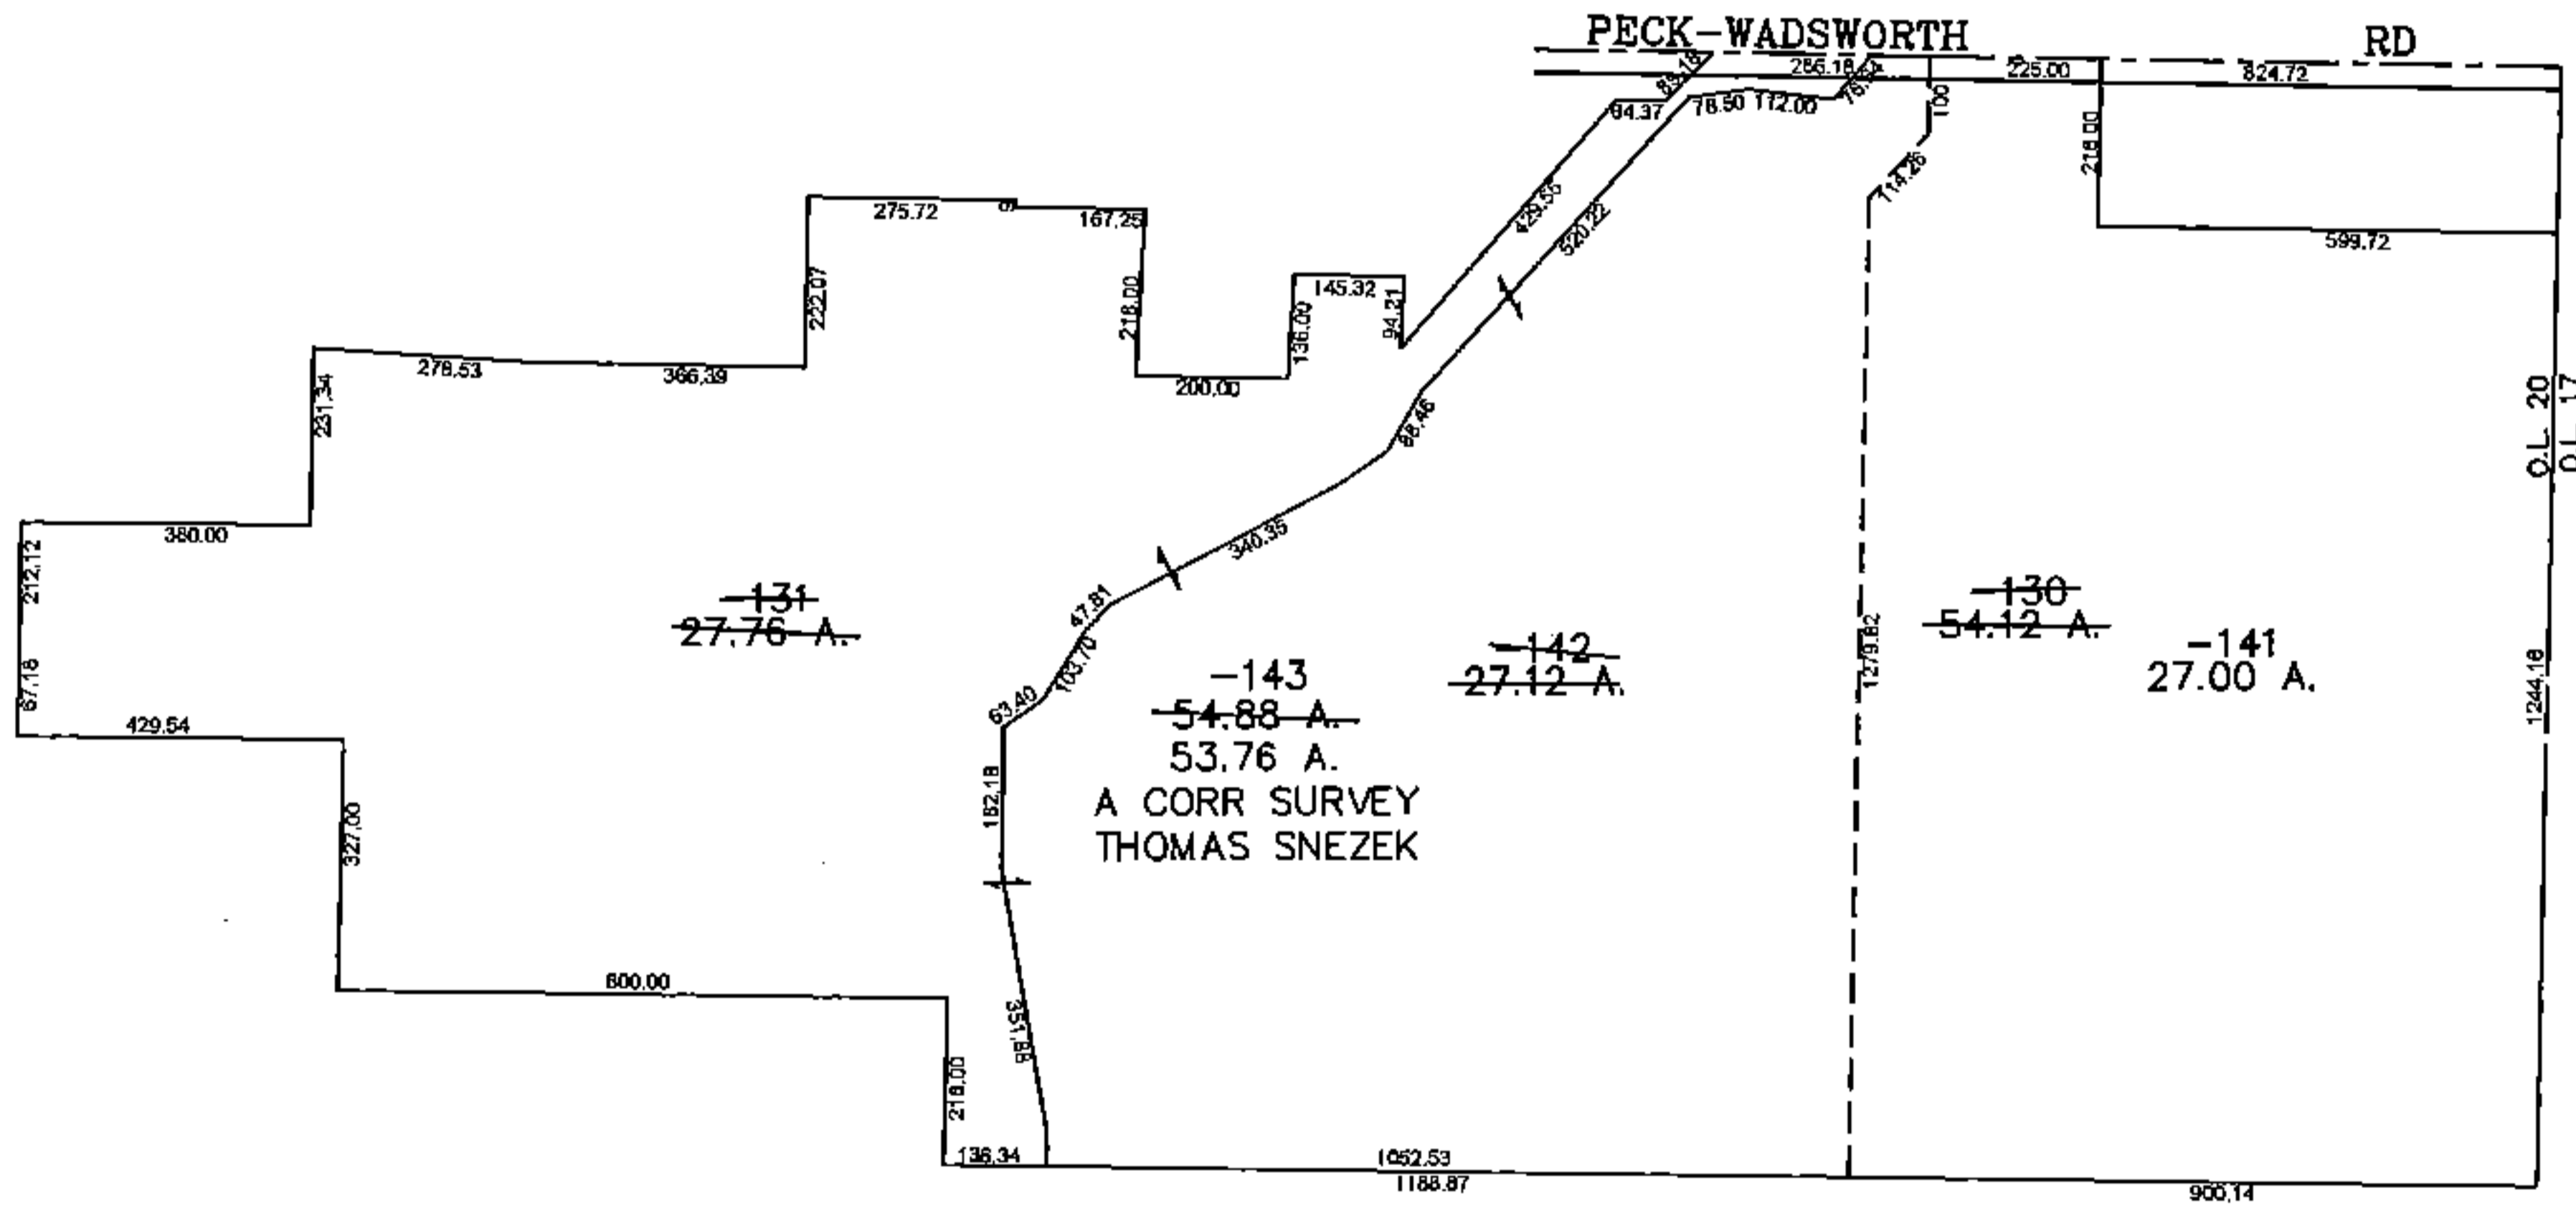


PARENT PARCEL: 18-00-020-000-130, 131
CHILD PARCEL: 18-00-020-000-141, -142, -143
STARTING POINT: CENTERLINE OF PECK-WADSWORTH RD & O.L. 20

15-03395

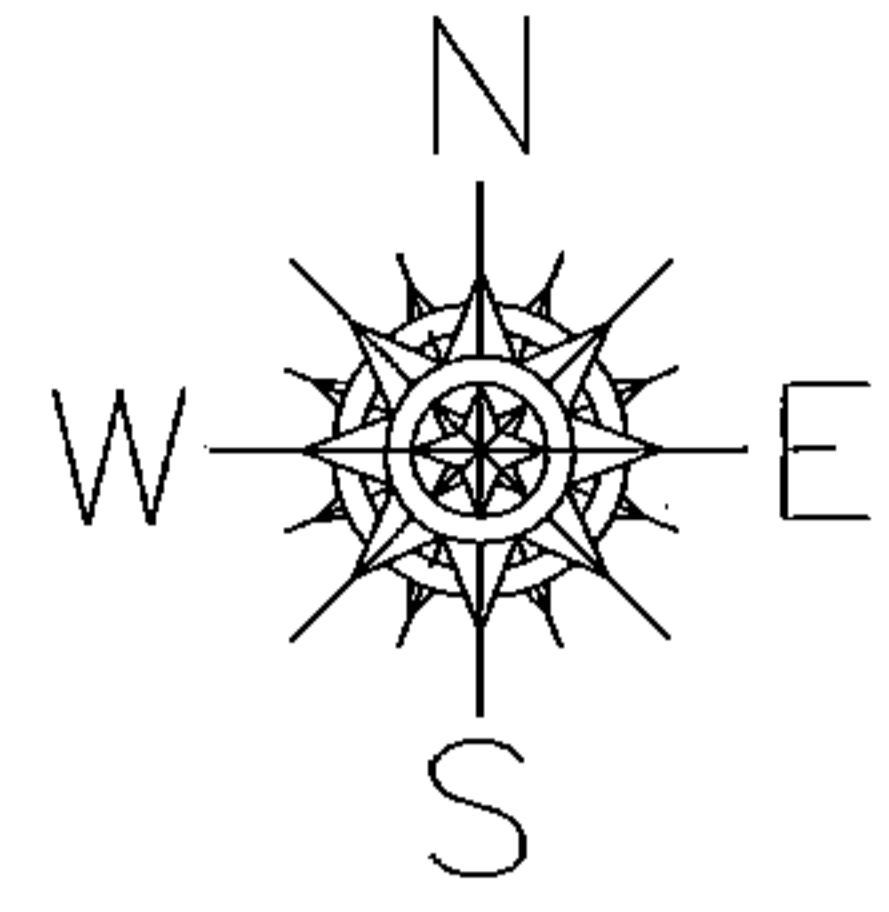

SPLITS/DEEDS PROCESSED
LORAIN COUNTY TAX MAP DEPARTMENT
226 MIDDLE AVE. ELYRIA, OHIO

SURVEYED BY: THOMAS SNEZEK
CLOSURE: 0.00 : 10,000
MAP PAGE(S): 18-00-020-B
APPROVED BY: JAH DATE: 7/21/2015
SCALE: 1" = 500 PRIOR INST.: 20130447623