
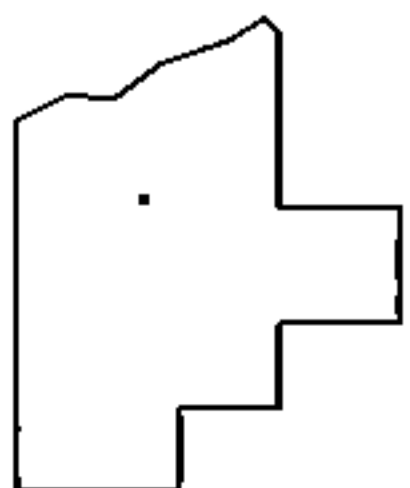
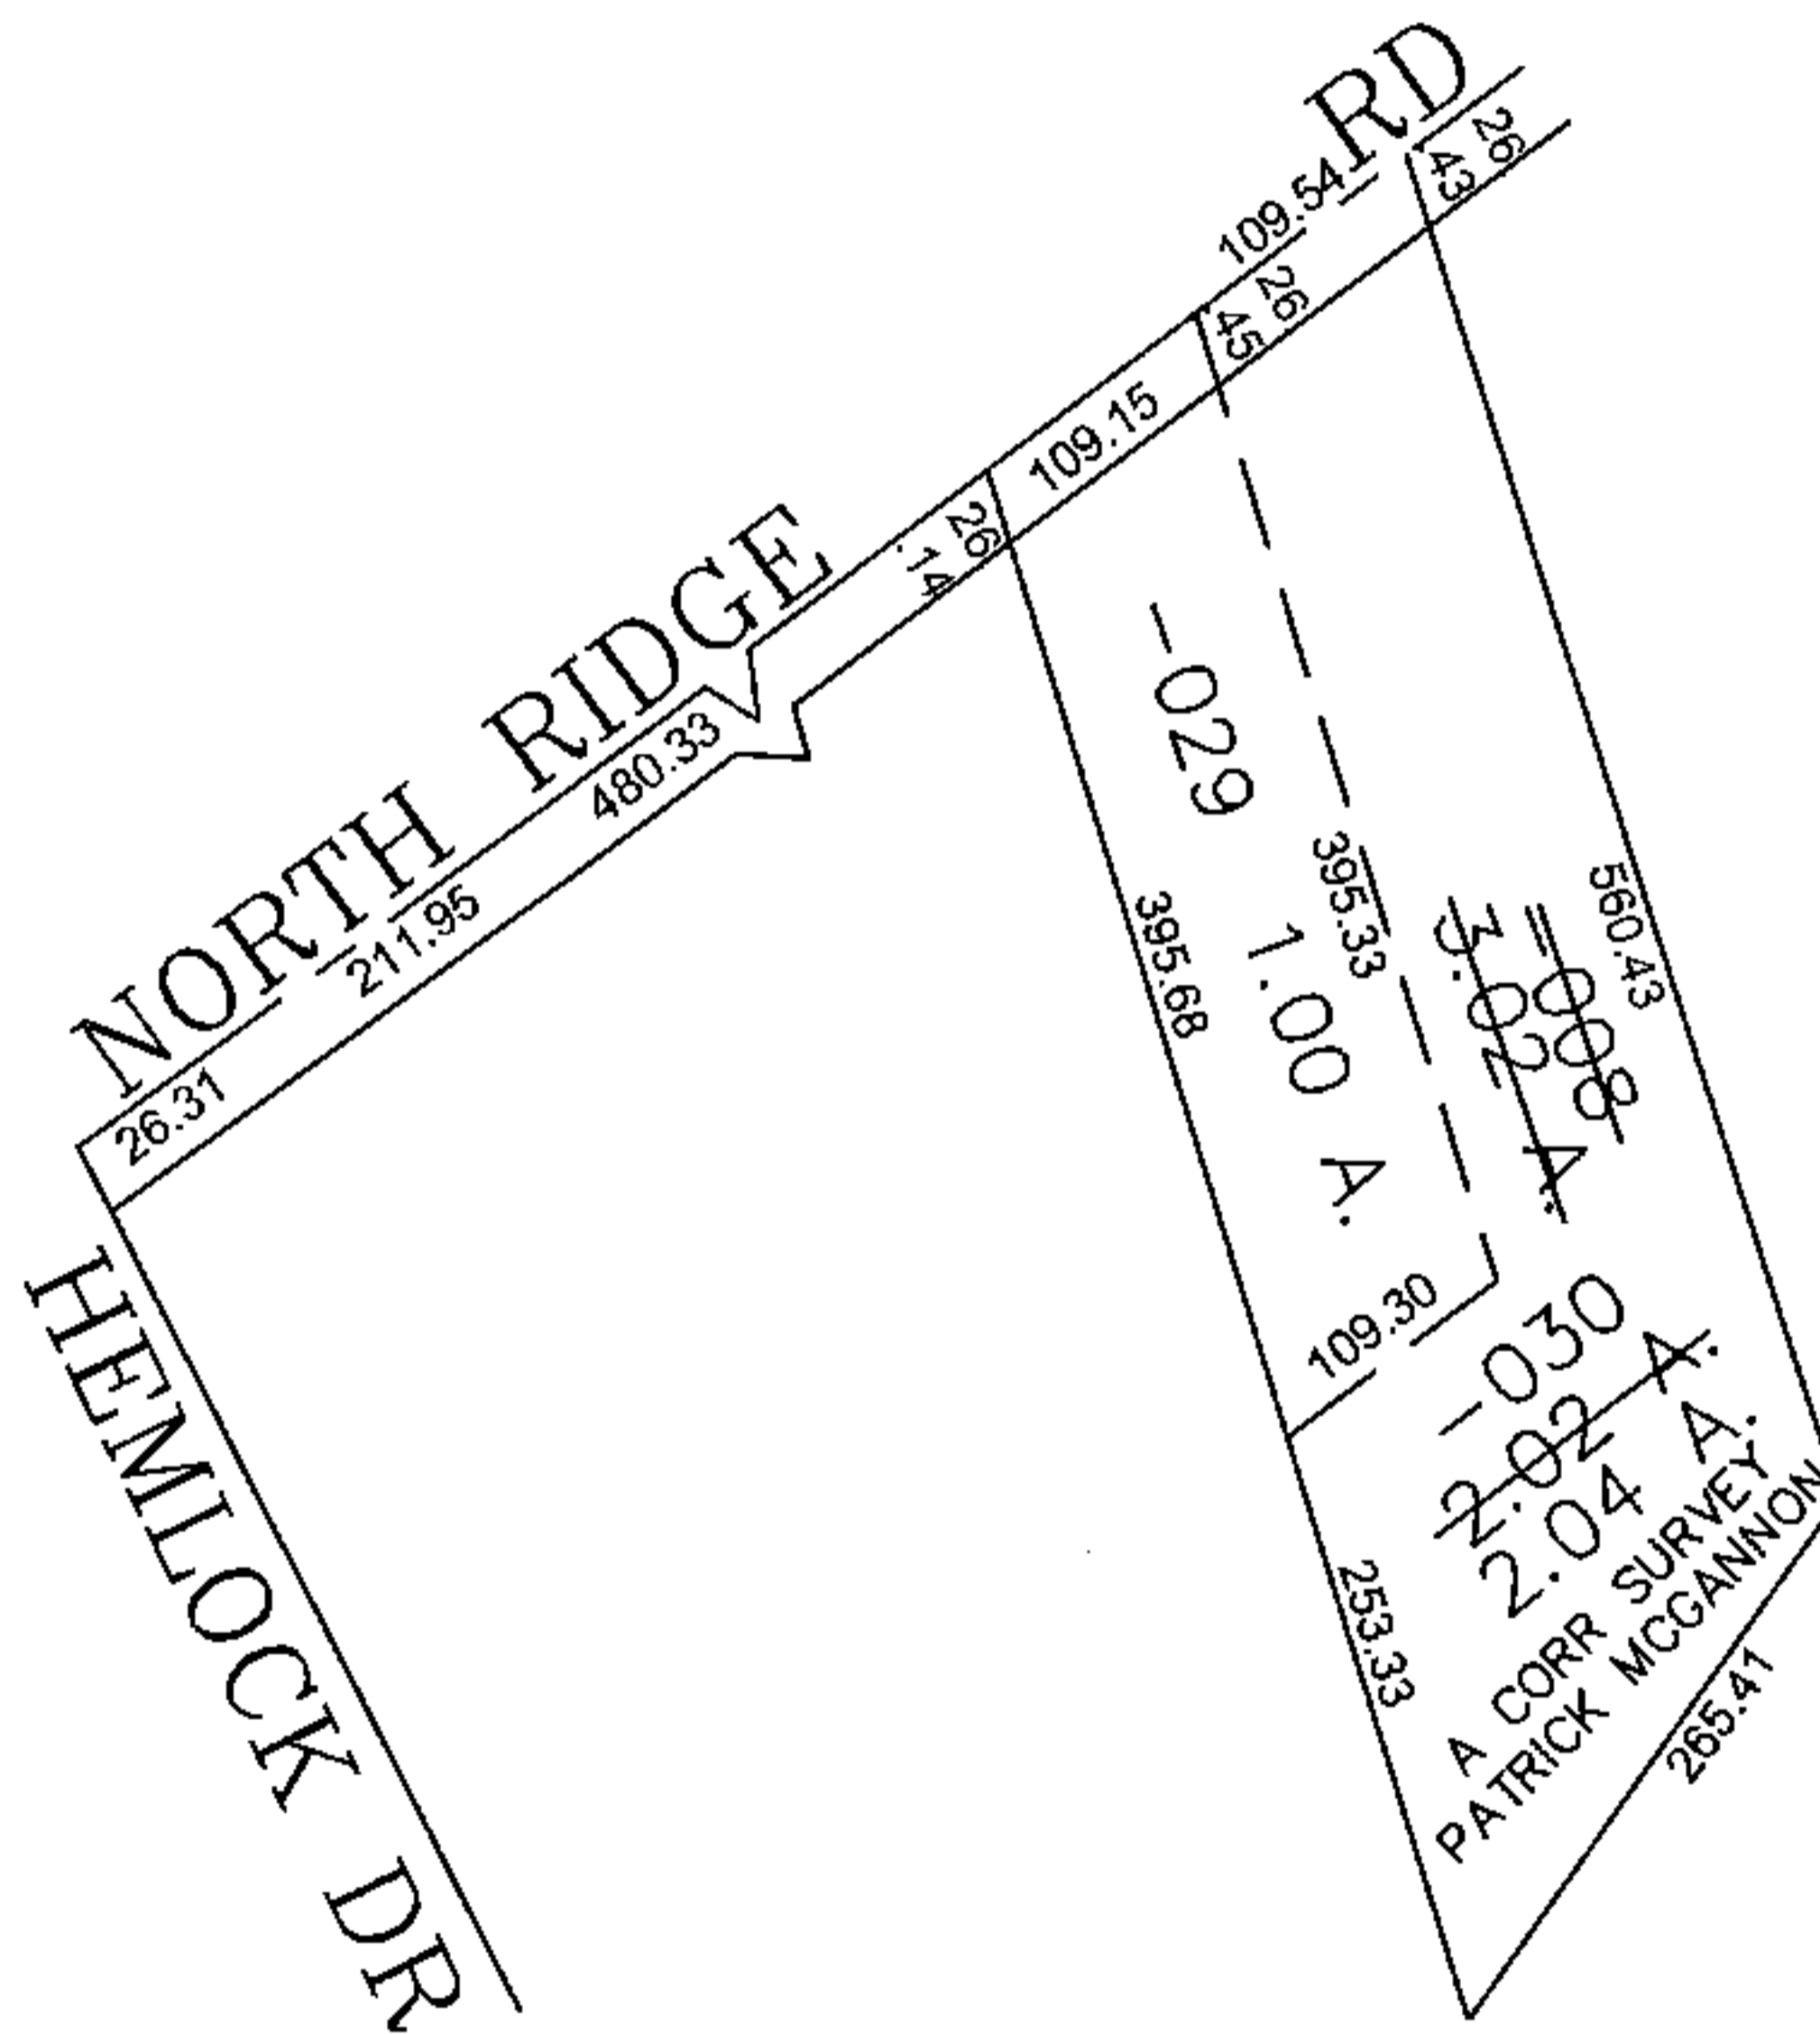


PARENT PARCEL: 05-00-059-103-008

CHILD PARCEL: 05-00-059-103-029, -030

STARTING POINT: CENTERLINE OF NORTH RIDGE RD & EAST LINE OF HEMLOCK DR

15-03396

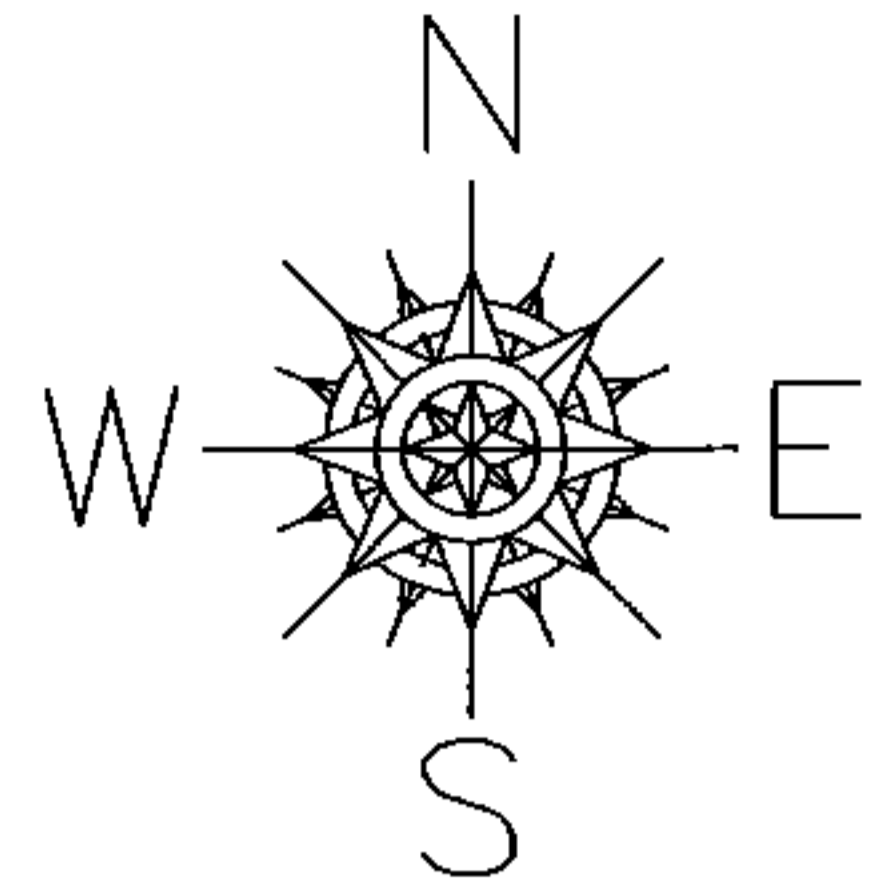

SPLITS/DEEDS PROCESSED

LORAIN COUNTY TAX MAP DEPARTMENT
226 MIDDLE AVE. ELYRIA, OHIO

SURVEYED BY: PATRICK MCGANNON

CLOSURE: 0.00 : 10,000

MAP PAGE(S): 05-00-059-A

APPROVED BY: JAH DATE: 7/23/2015

SCALE: 1" = 200 PRIOR INSTRUMENT: 20080268764