


PARENT PARCEL: 19-02-001-0000-007

CHILD PARCEL: XX-XX-XXX-XXX-XXX

STARTING POINT: SOUTHEAST CORNER OF O.L.1 TR. 2

16-03399-X


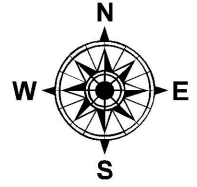


TRACT 3

TRACT 2

ACREAGE CORRECTION

6.53
~~6.72~~
 CORR. PER SURVEY T.SIMON

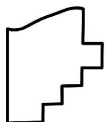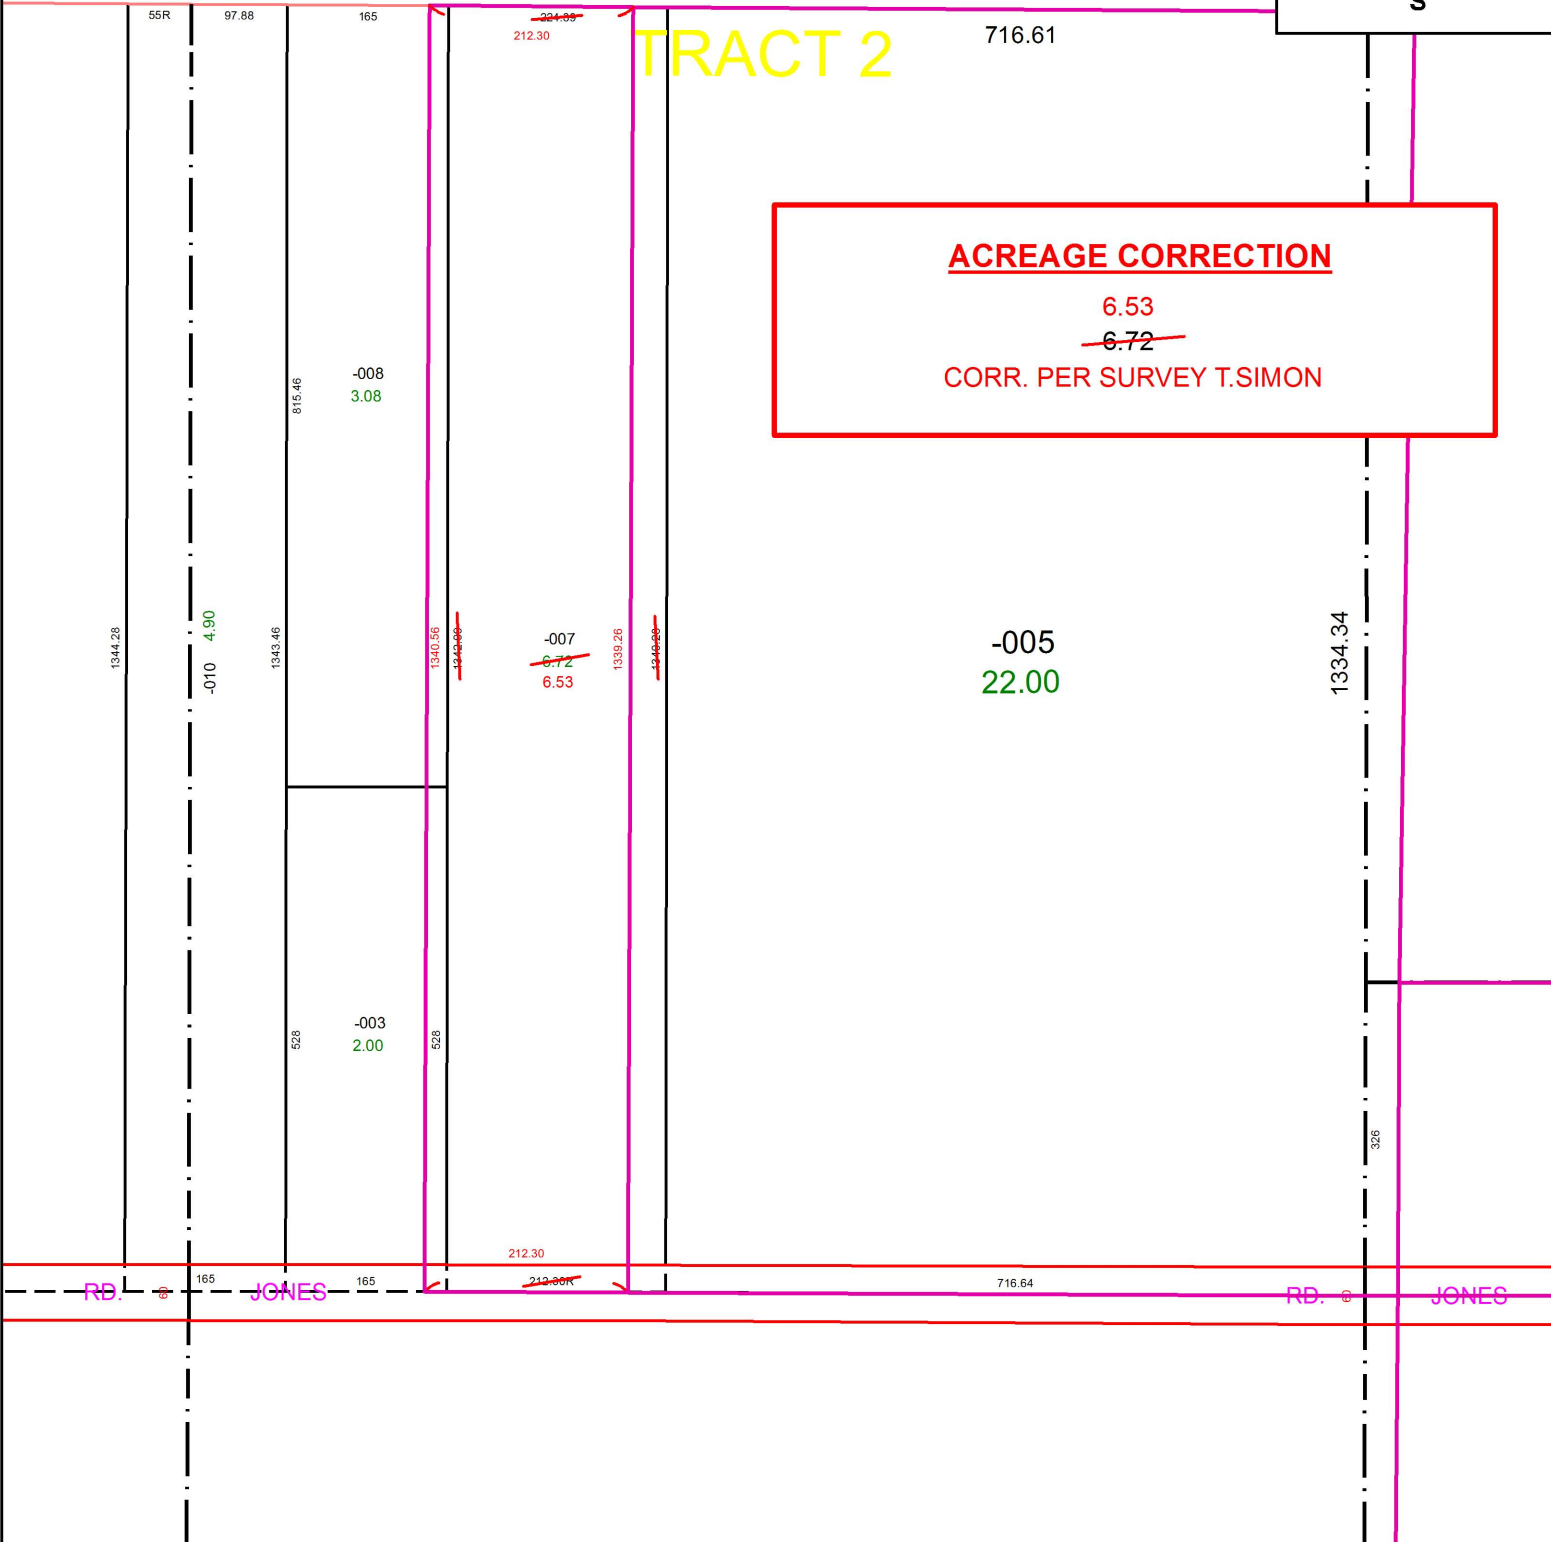

SPLITS/DEEDS PROCESSED
 LORAIN COUNTY TAX MAP DEPARTMENT
 226 MIDDLE AVE. ELYRIA, OH

SURVEYED BY: THOMAS A. SIMON

CLOSURE: 1: 690,725

MAP PAGE(S): 19-A

APPROVED BY: RRM DATE: 3-16-16

SCALE: 1" = 200 PRIOR INSTRUMENT: 20160576012