


PARENT PARCEL: ADD TO DUPLICATE

CHILD PARCEL: 02-01-003-110-062 & -063

STARTING POINT: PER VAC. ORD. # 204-02

16-03402-A

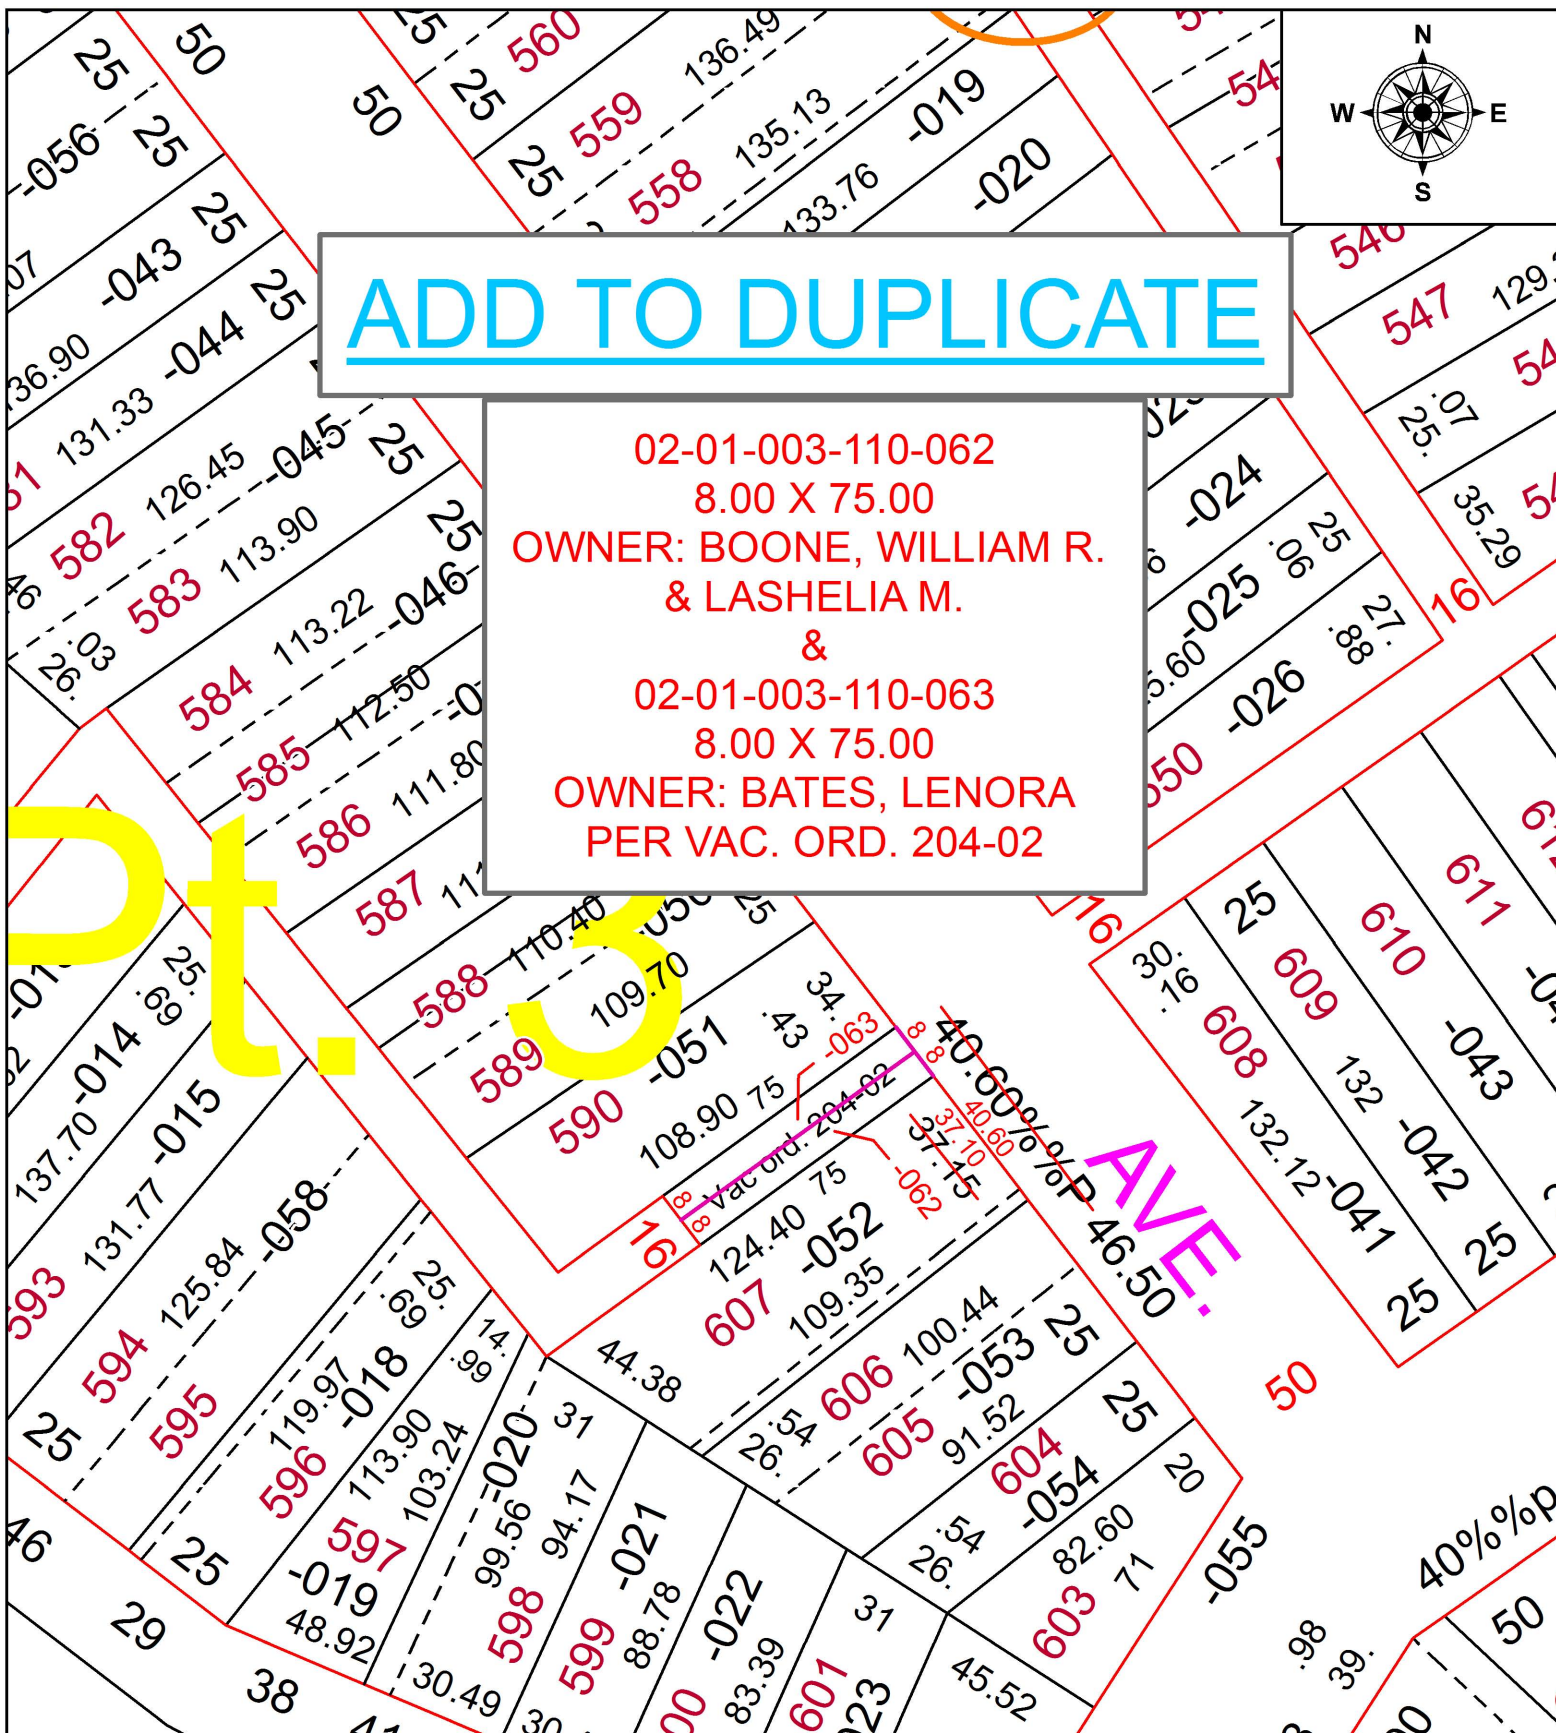


ADD TO DUPLICATE

02-01-003-110-062
 8.00 X 75.00
 OWNER: BOONE, WILLIAM R.
 & LASHELIA M.
 &
 02-01-003-110-063
 8.00 X 75.00
 OWNER: BATES, LENORA
 PER VAC. ORD. 204-02

D.T.S.

P. AVE.

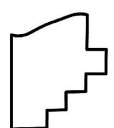

SPLITS/DEEDS PROCESSED
 LORAIN COUNTY TAX MAP DEPARTMENT
 226 MIDDLE AVE. ELYRIA, OH

SURVEYED BY: NA
 CLOSURE: NA
 MAP PAGE(S): 02-01-003
 APPROVED BY: TJS DATE: 3/23/16
 SCALE: 1" = 50 PRIOR INSTRUMENT: DV XXXX/XXXX