


PARENT PARCEL: 19-05-018-000-028, -029



CHILD PARCEL: 19-05-018-000-032, -033

STARTING POINT: CENTERLINE OF WEST RD & PECK-WADSWORTH RD

15-03402

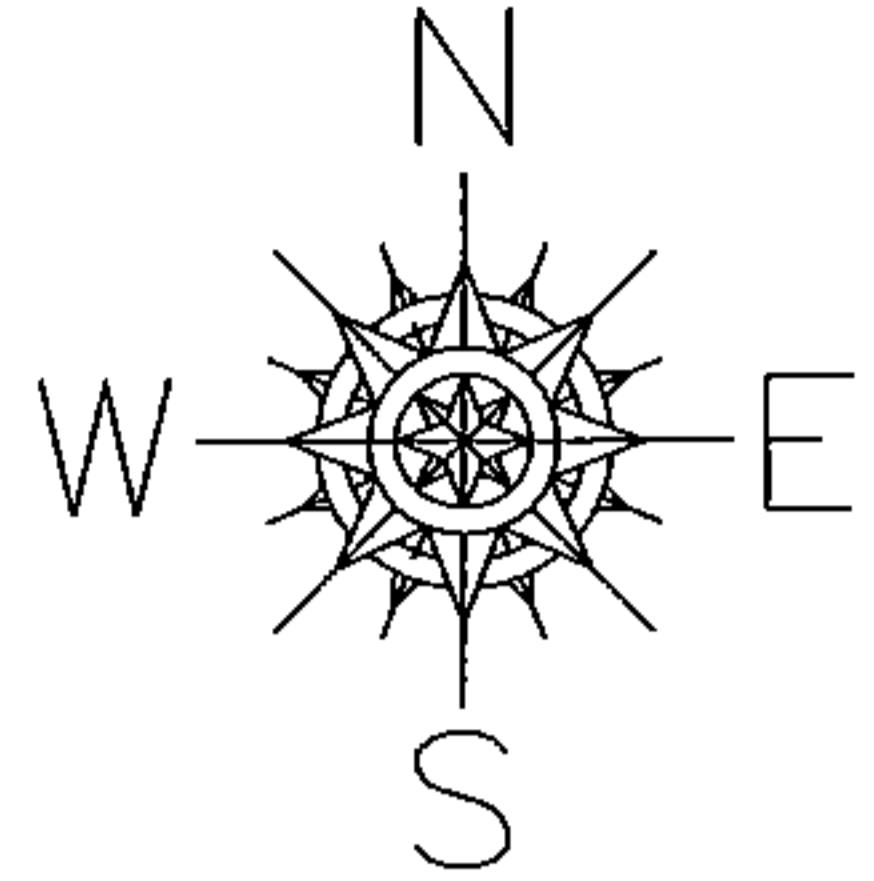

PECK-WADSWORTH RD

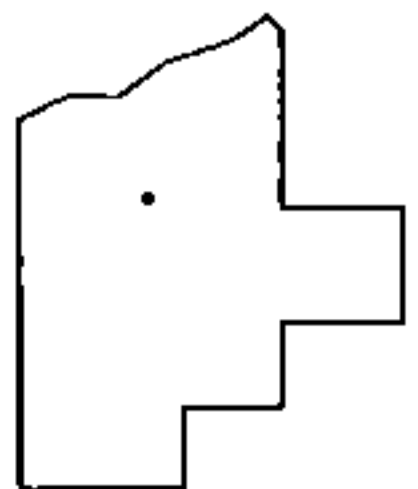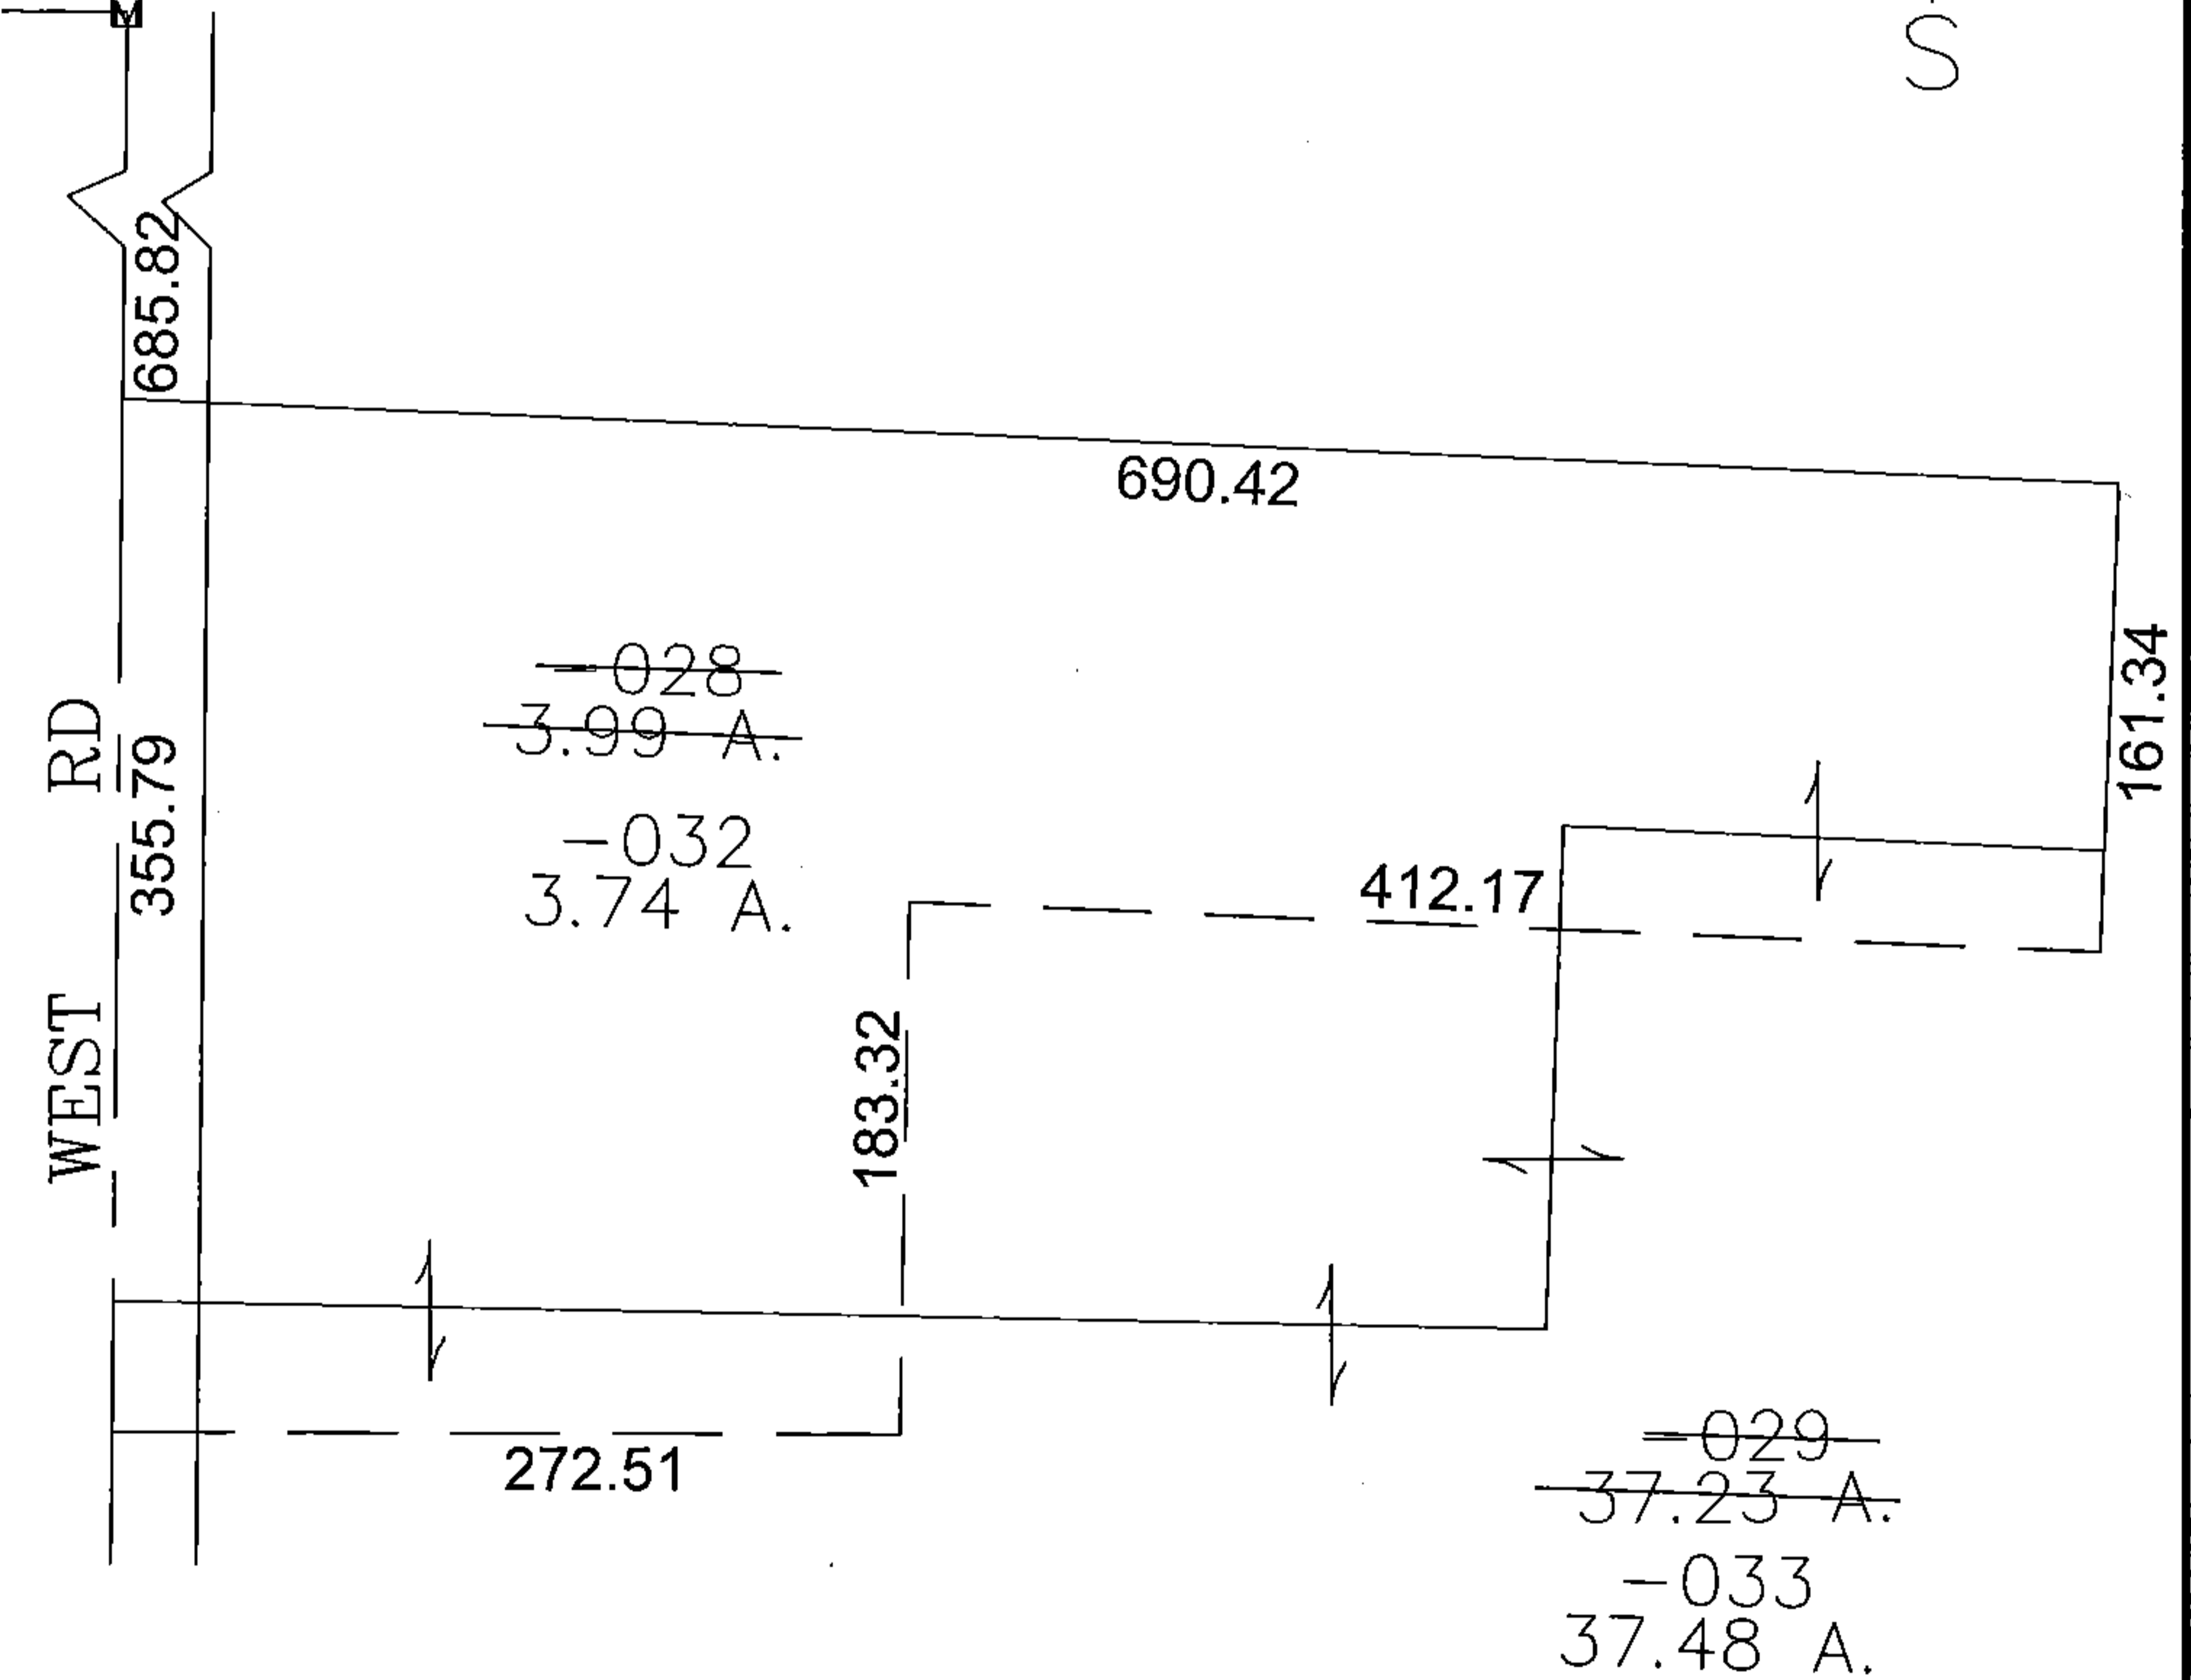

SPLITS/DEEDS PROCESSED

LORAIN COUNTY TAX MAP DEPARTMENT
226 MIDDLE AVE. ELYRIA, OHIO

SURVEYED BY: RICHARD CARLSON

CLOSURE: 0.00 : 10.000

MAP PAGE(S): 19-A

APPROVED BY: JAH DATE: 7/30/2015

SCALE: 1" = 100 PRIOR INSTRUMENT: 19920207799