
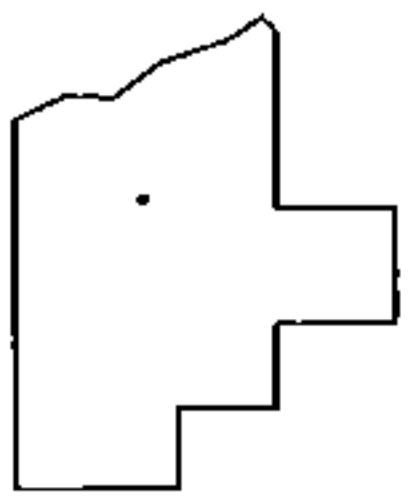
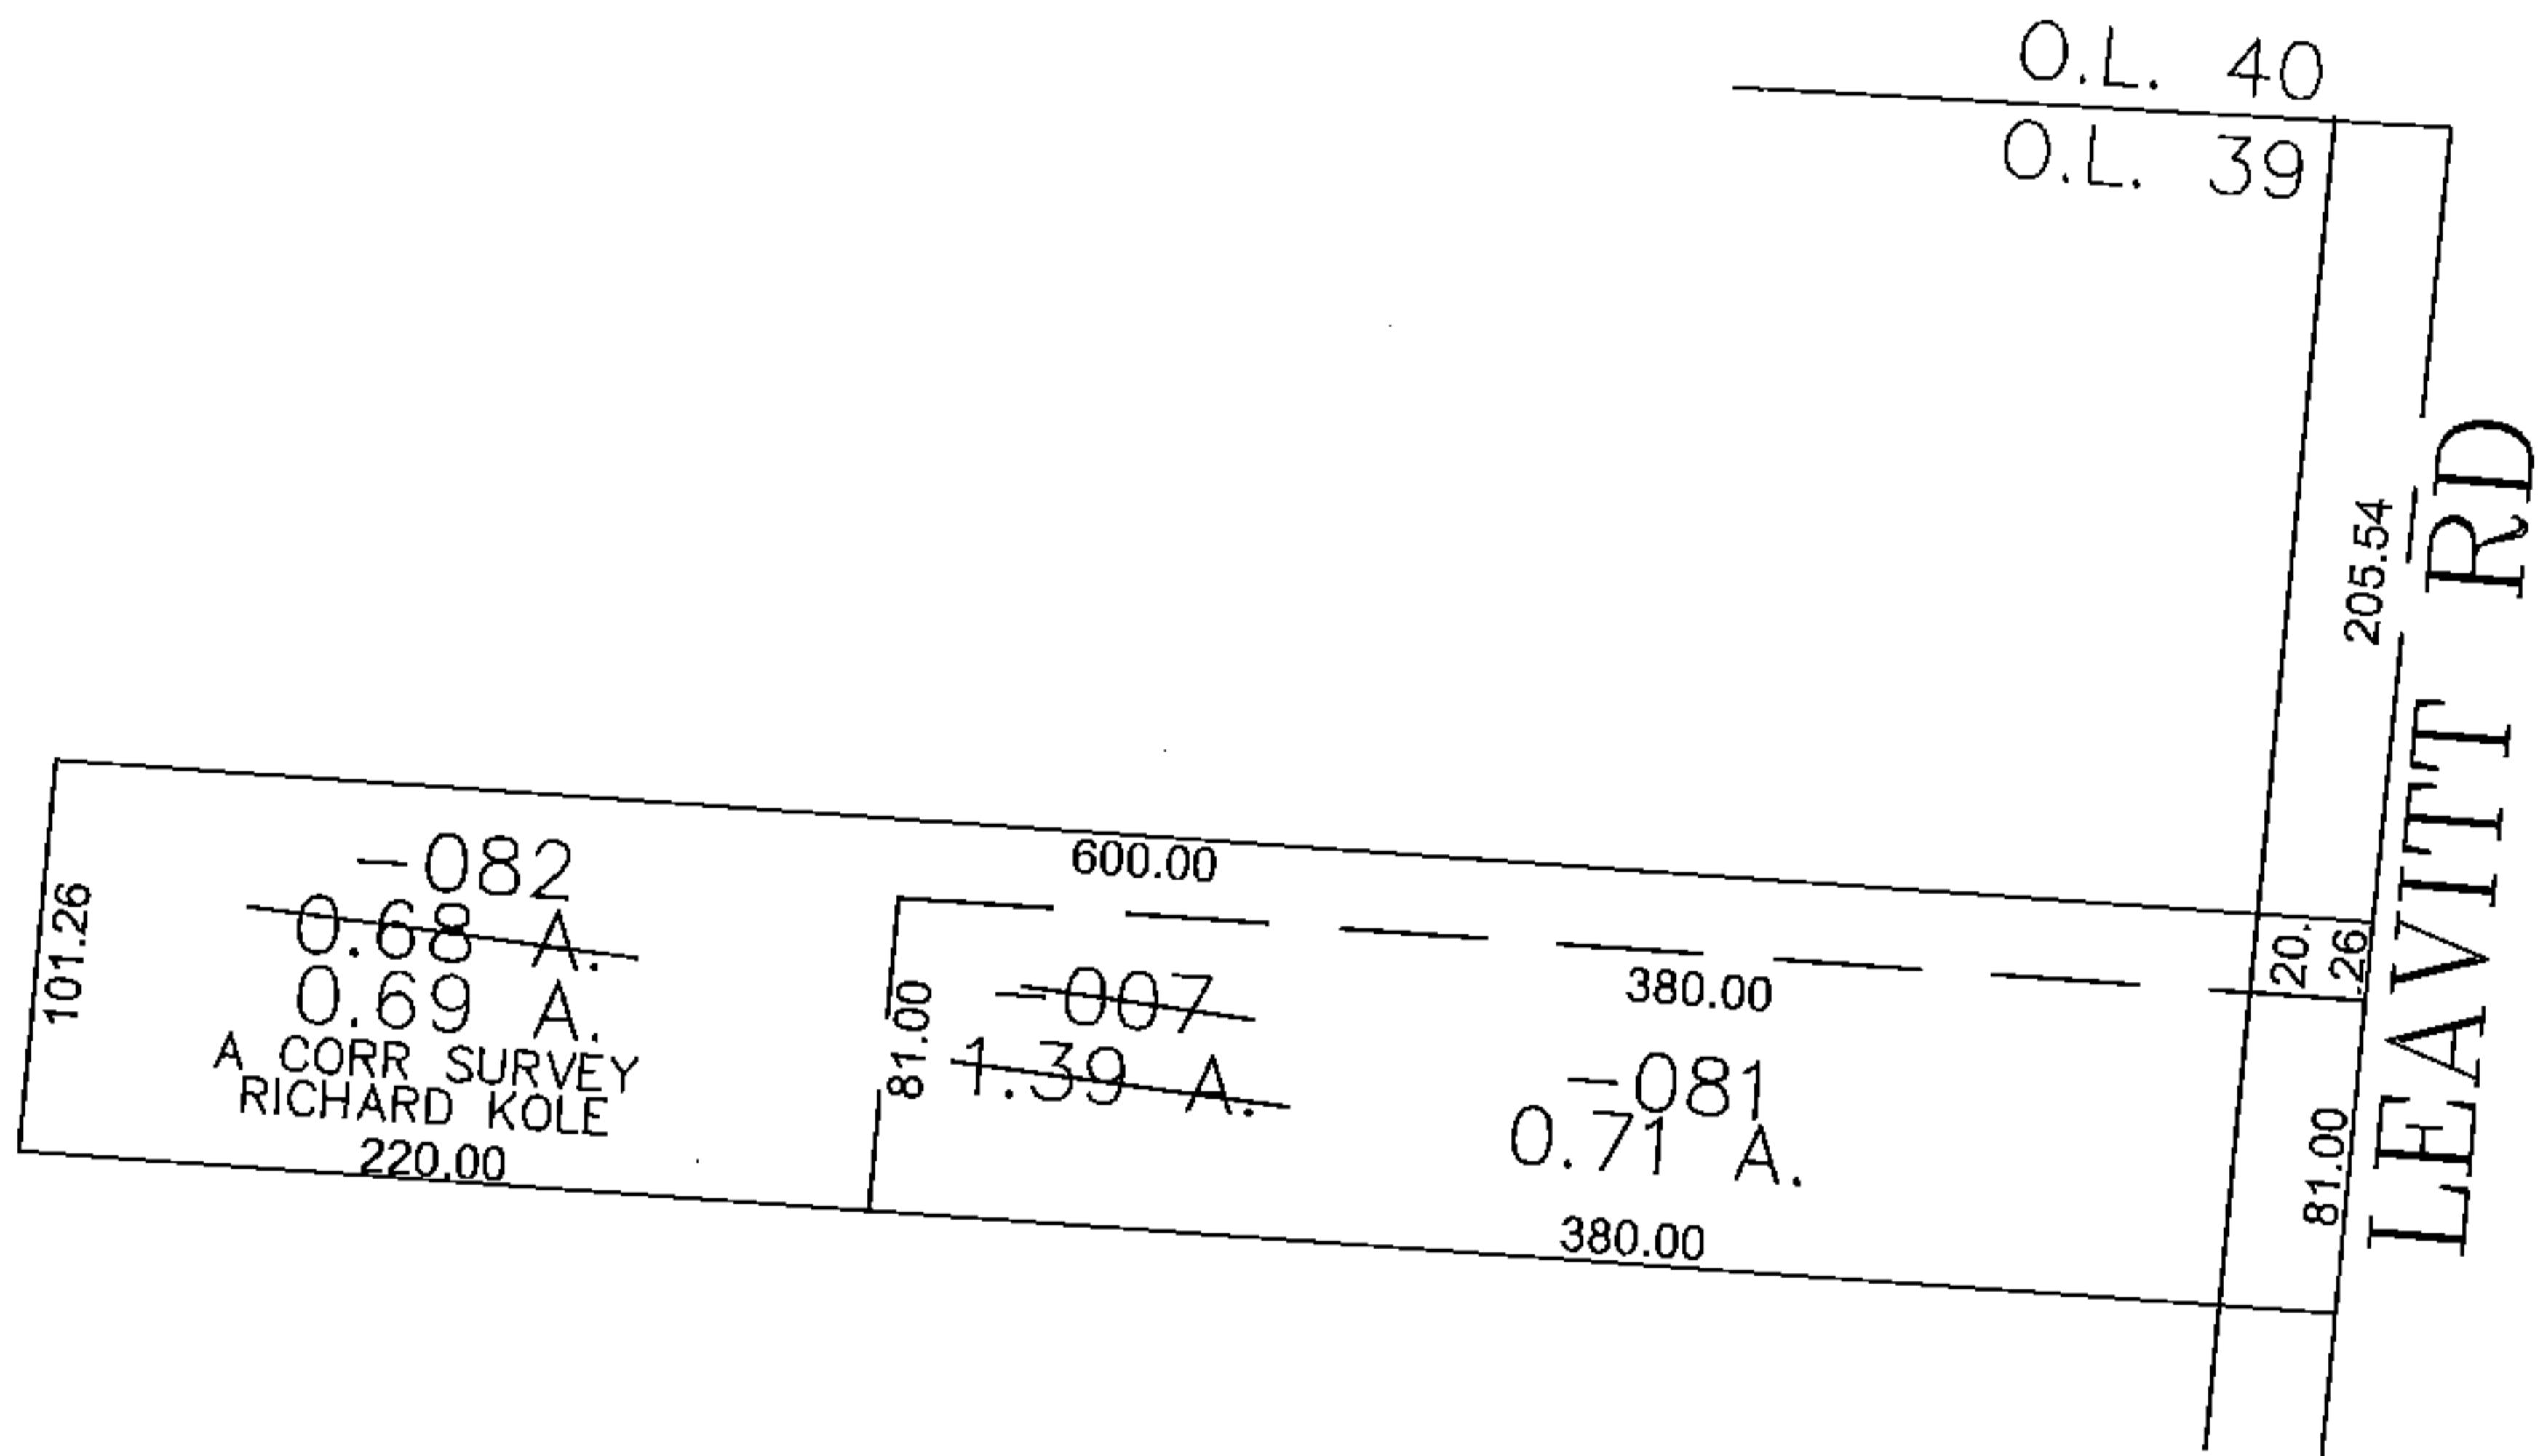


PARENT PARCEL: 05-00-039-108-007

CHILD PARCEL: 05-00-039-108-081, -082

STARTING POINT: CENTERLINE OF LEAVITT RD & O.L. 39

15-03403

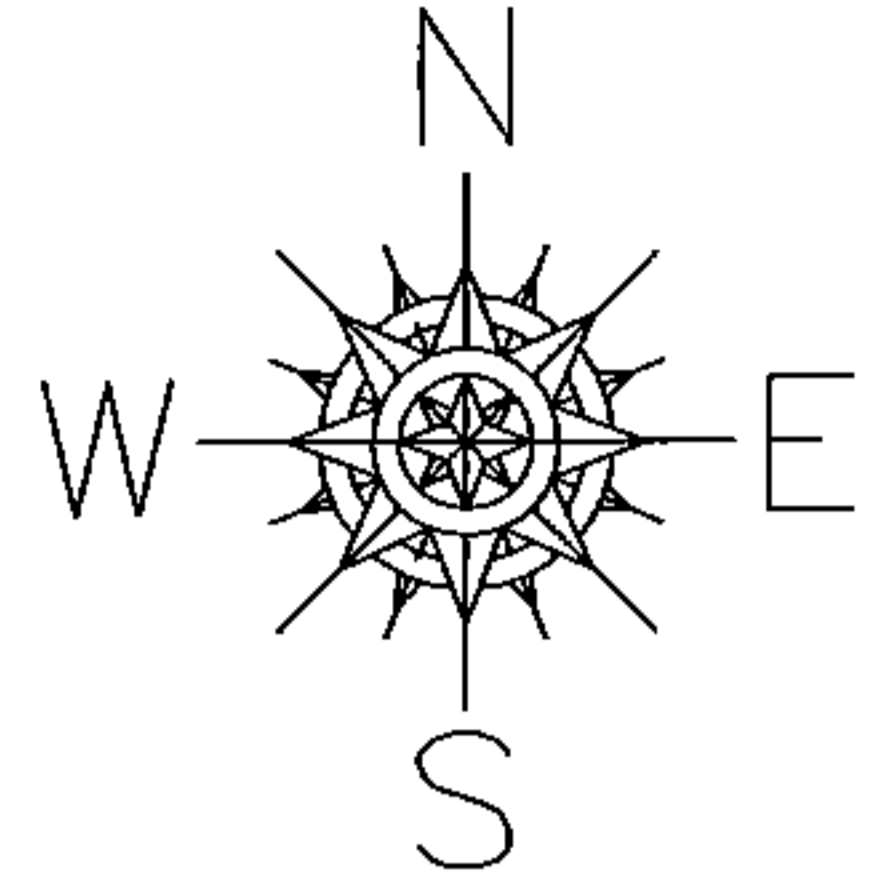

SPLITS/DEEDS PROCESSED

LORAIN COUNTY TAX MAP DEPARTMENT
226 MIDDLE AVE. ELYRIA, OHIO

SURVEYED BY: RICHARD KOLE
 CLOSURE: 0.00 : 10.000
 MAP PAGE(S): 05-00-039-B
 APPROVED BY: JAH DATE: 8/4/2015
 SCALE: 1" = 100 PRIOR INSTRUMENT: 20060166047