
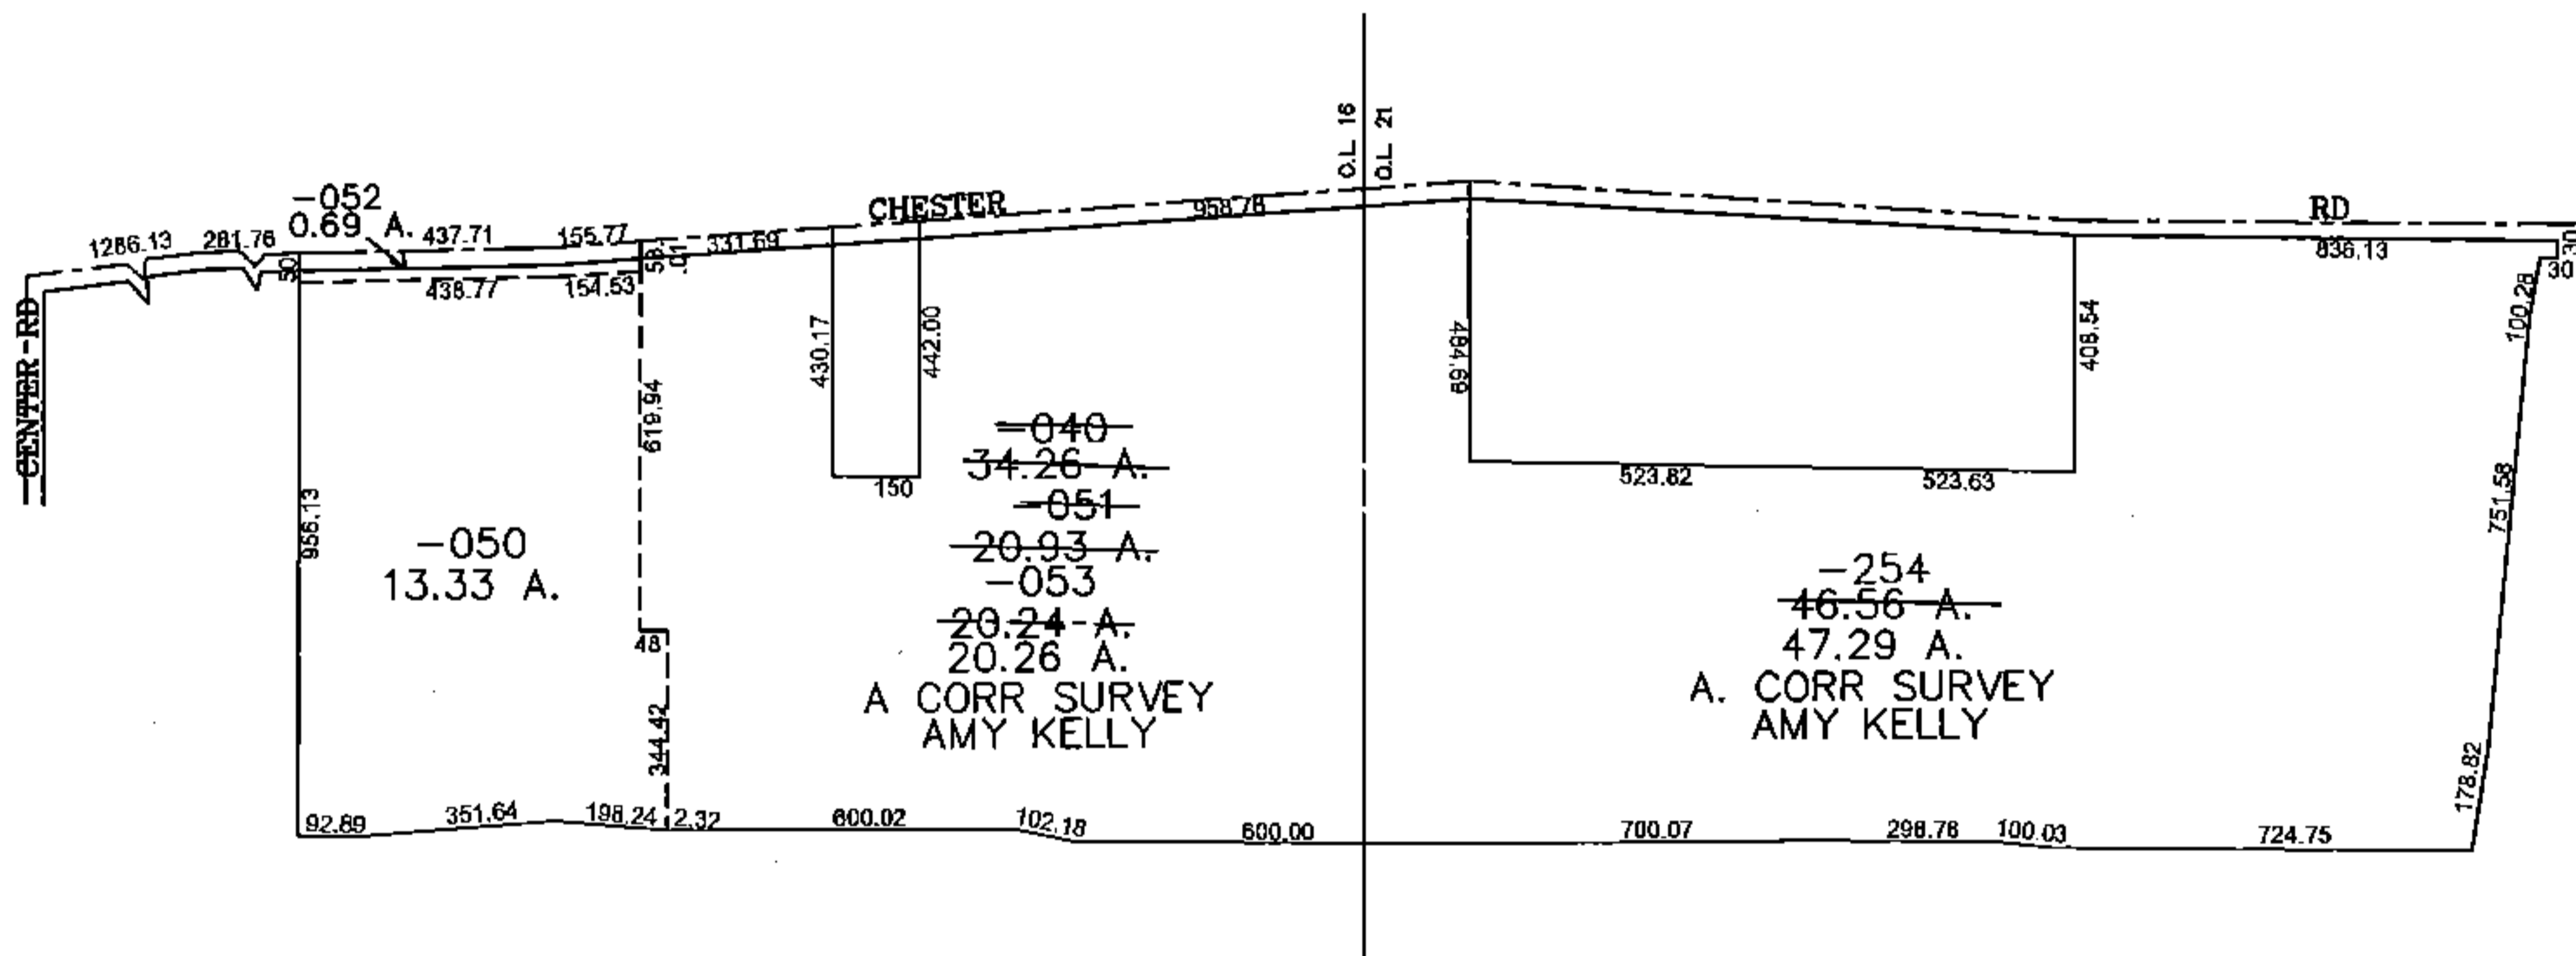


PARENT PARCEL: 04-00-016-104-040, 04-00-021-000-254

CHILD PARCEL: 04-00-016-104-050 THRU -053

STARTING POINT: CENTERLINE OF CENTER RD & CHESTER RD

15-03404

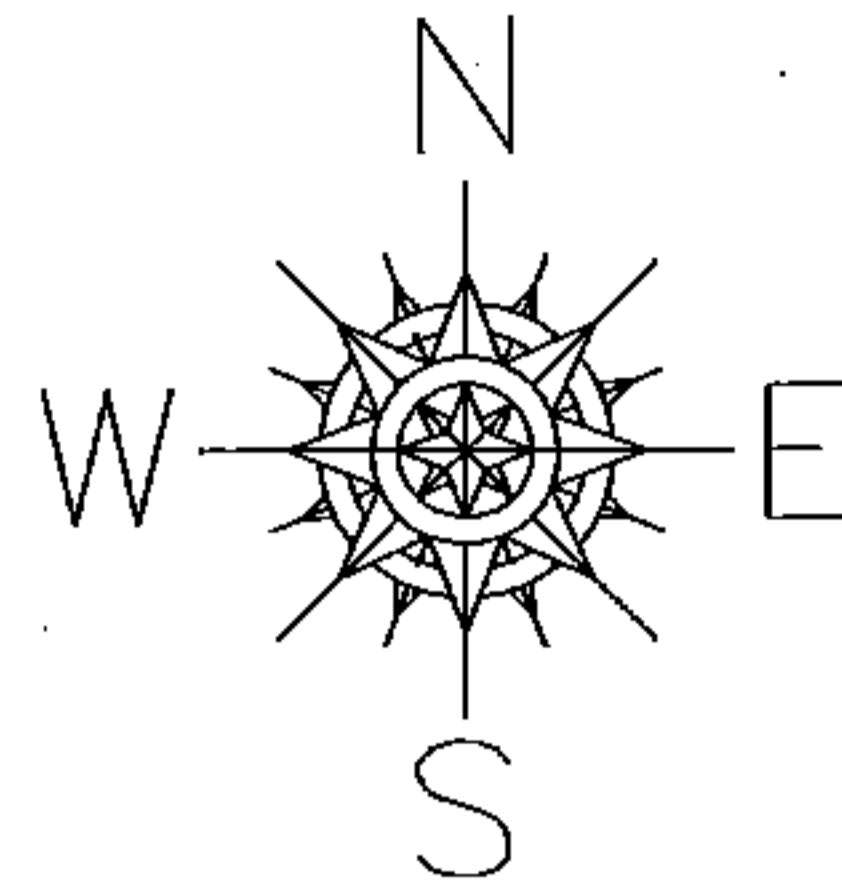

SPLITS/DEEDS PROCESSED

LORAIN COUNTY TAX MAP DEPARTMENT
226 MIDDLE AVE. ELYRIA, OHIO

SURVEYED BY: AMY KELLY

CLOSURE: 0.00 : 10.000

MAP PAGE(S): 04-00-016-A

APPROVED BY: JAH DATE: 8/7/2015

SCALE: 1" = 600 PRIOR INSTRUMENT: 20080256715