


PARENT PARCEL: 03-00-110-105-021


CHILD PARCEL: XX-XX-XXX-XXX-XXX

STARTING POINT: INTERSECTION OF C/L OF PEARL RD. AND C/L OF NORTH RIDGE RD.


16-03405-C

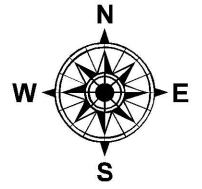

MAP CORRECTION ONLY
CORR. PER SURVEY M.LEWANDOWSKI

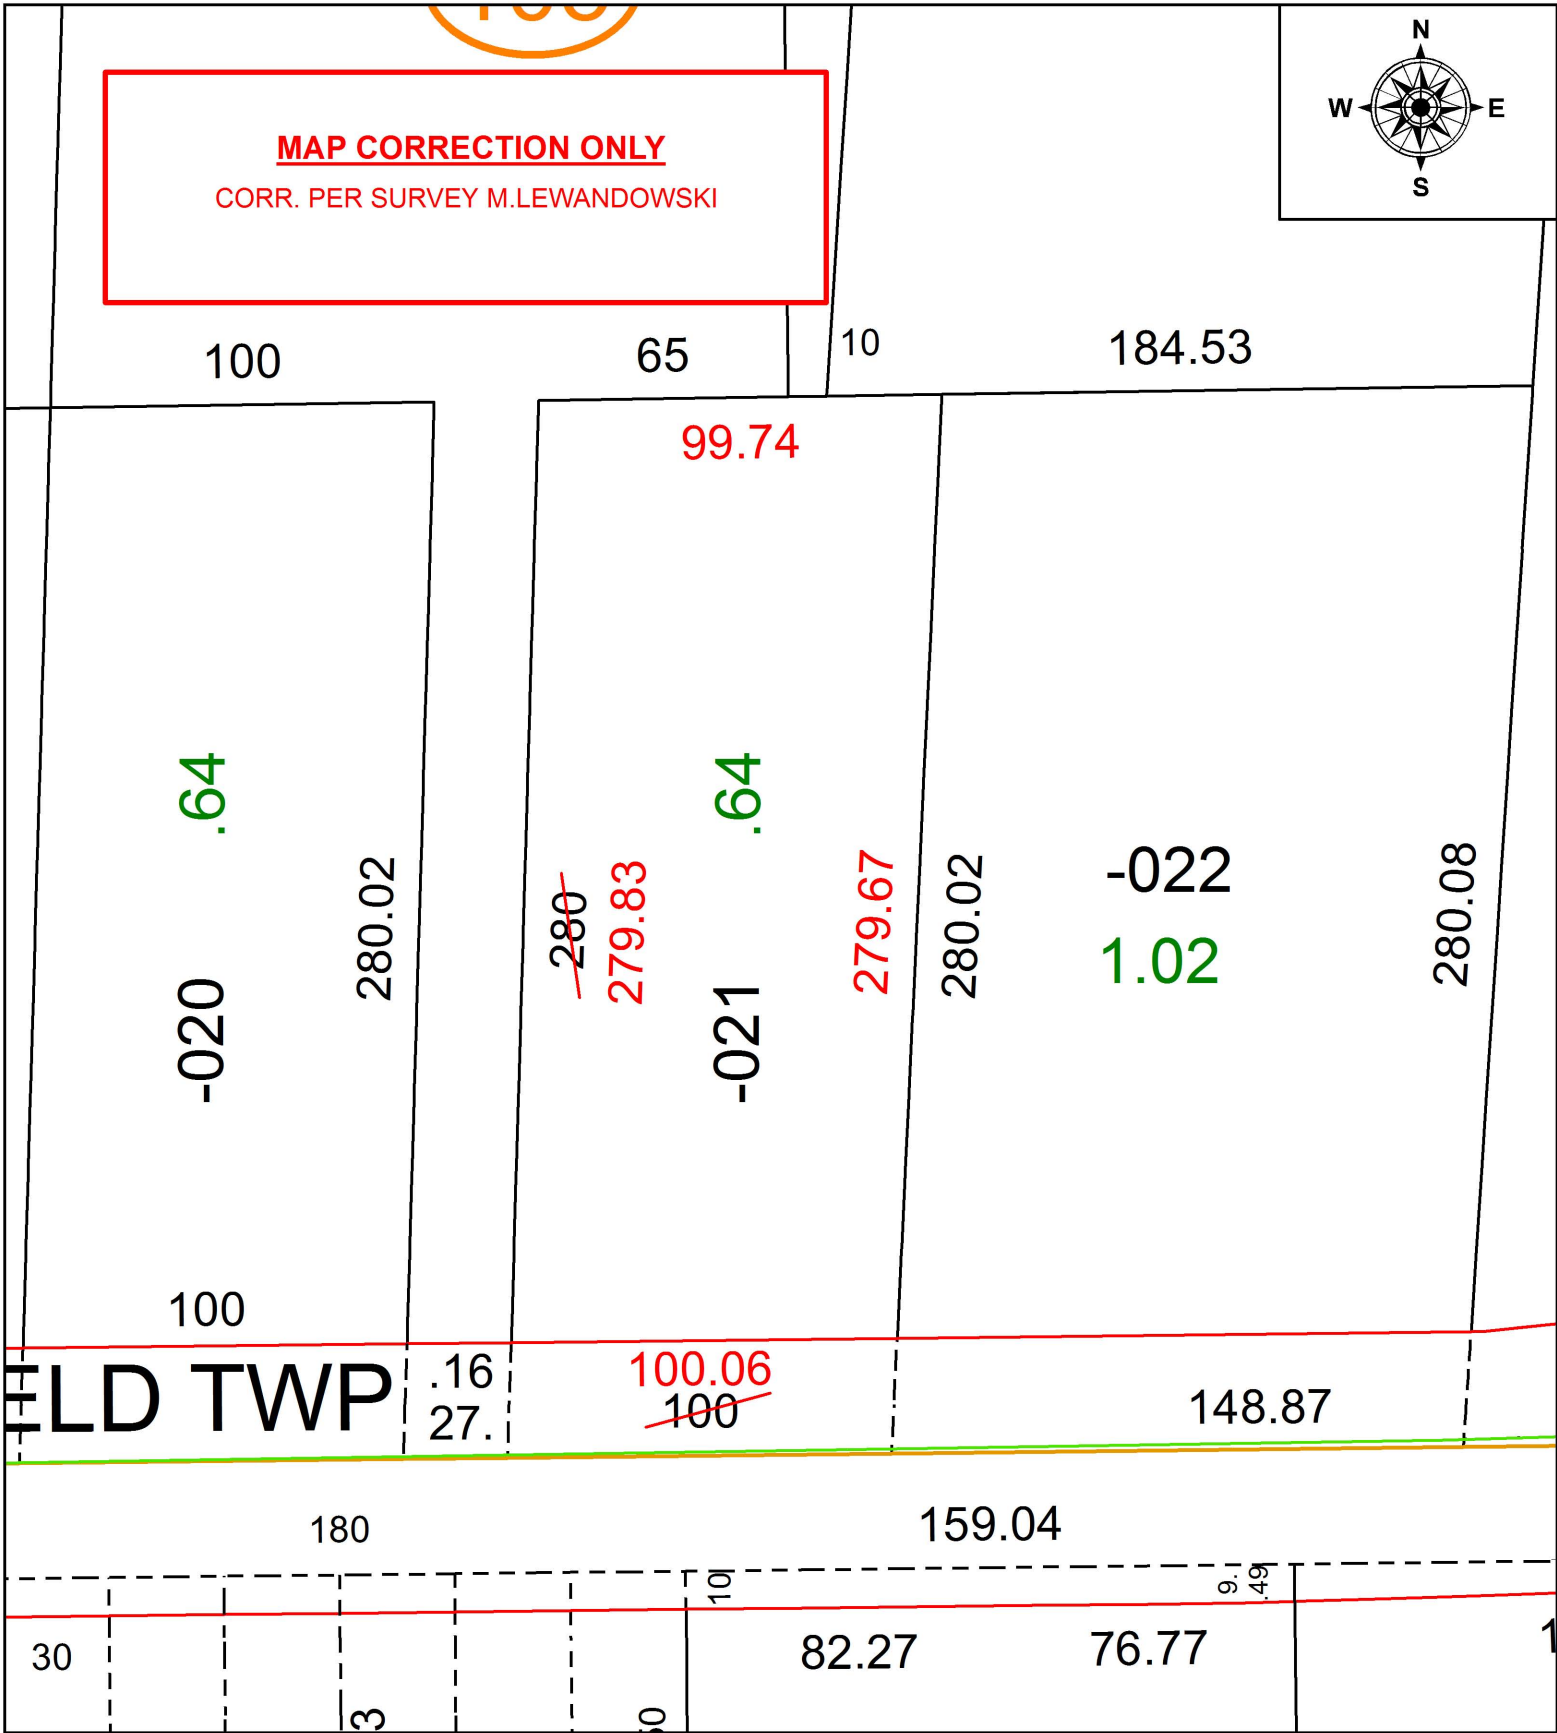

FIELD TWP

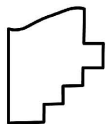

SPLITS/DEEDS PROCESSED
LORAIN COUNTY TAX MAP DEPARTMENT
226 MIDDLE AVE. ELYRIA, OH

SURVEYED BY: MATTHEW D. LEWANDOWSKI
CLOSURE: 1: 199,365
MAP PAGE(S): 3-00-110
APPROVED BY: RRM DATE: 4-4-16
SCALE: 1" = 50 PRIOR INSTRUMENT: OR 349/22