


PARENT PARCEL: 14-00-096-000-006

CHILD PARCEL: XX-XX-XXX-XXX-XXX

STARTING POINT: INTERSECTION OF NORTH LINE OF O.L.96 AND C/L OF HALLAUER RD.

16-03406-A

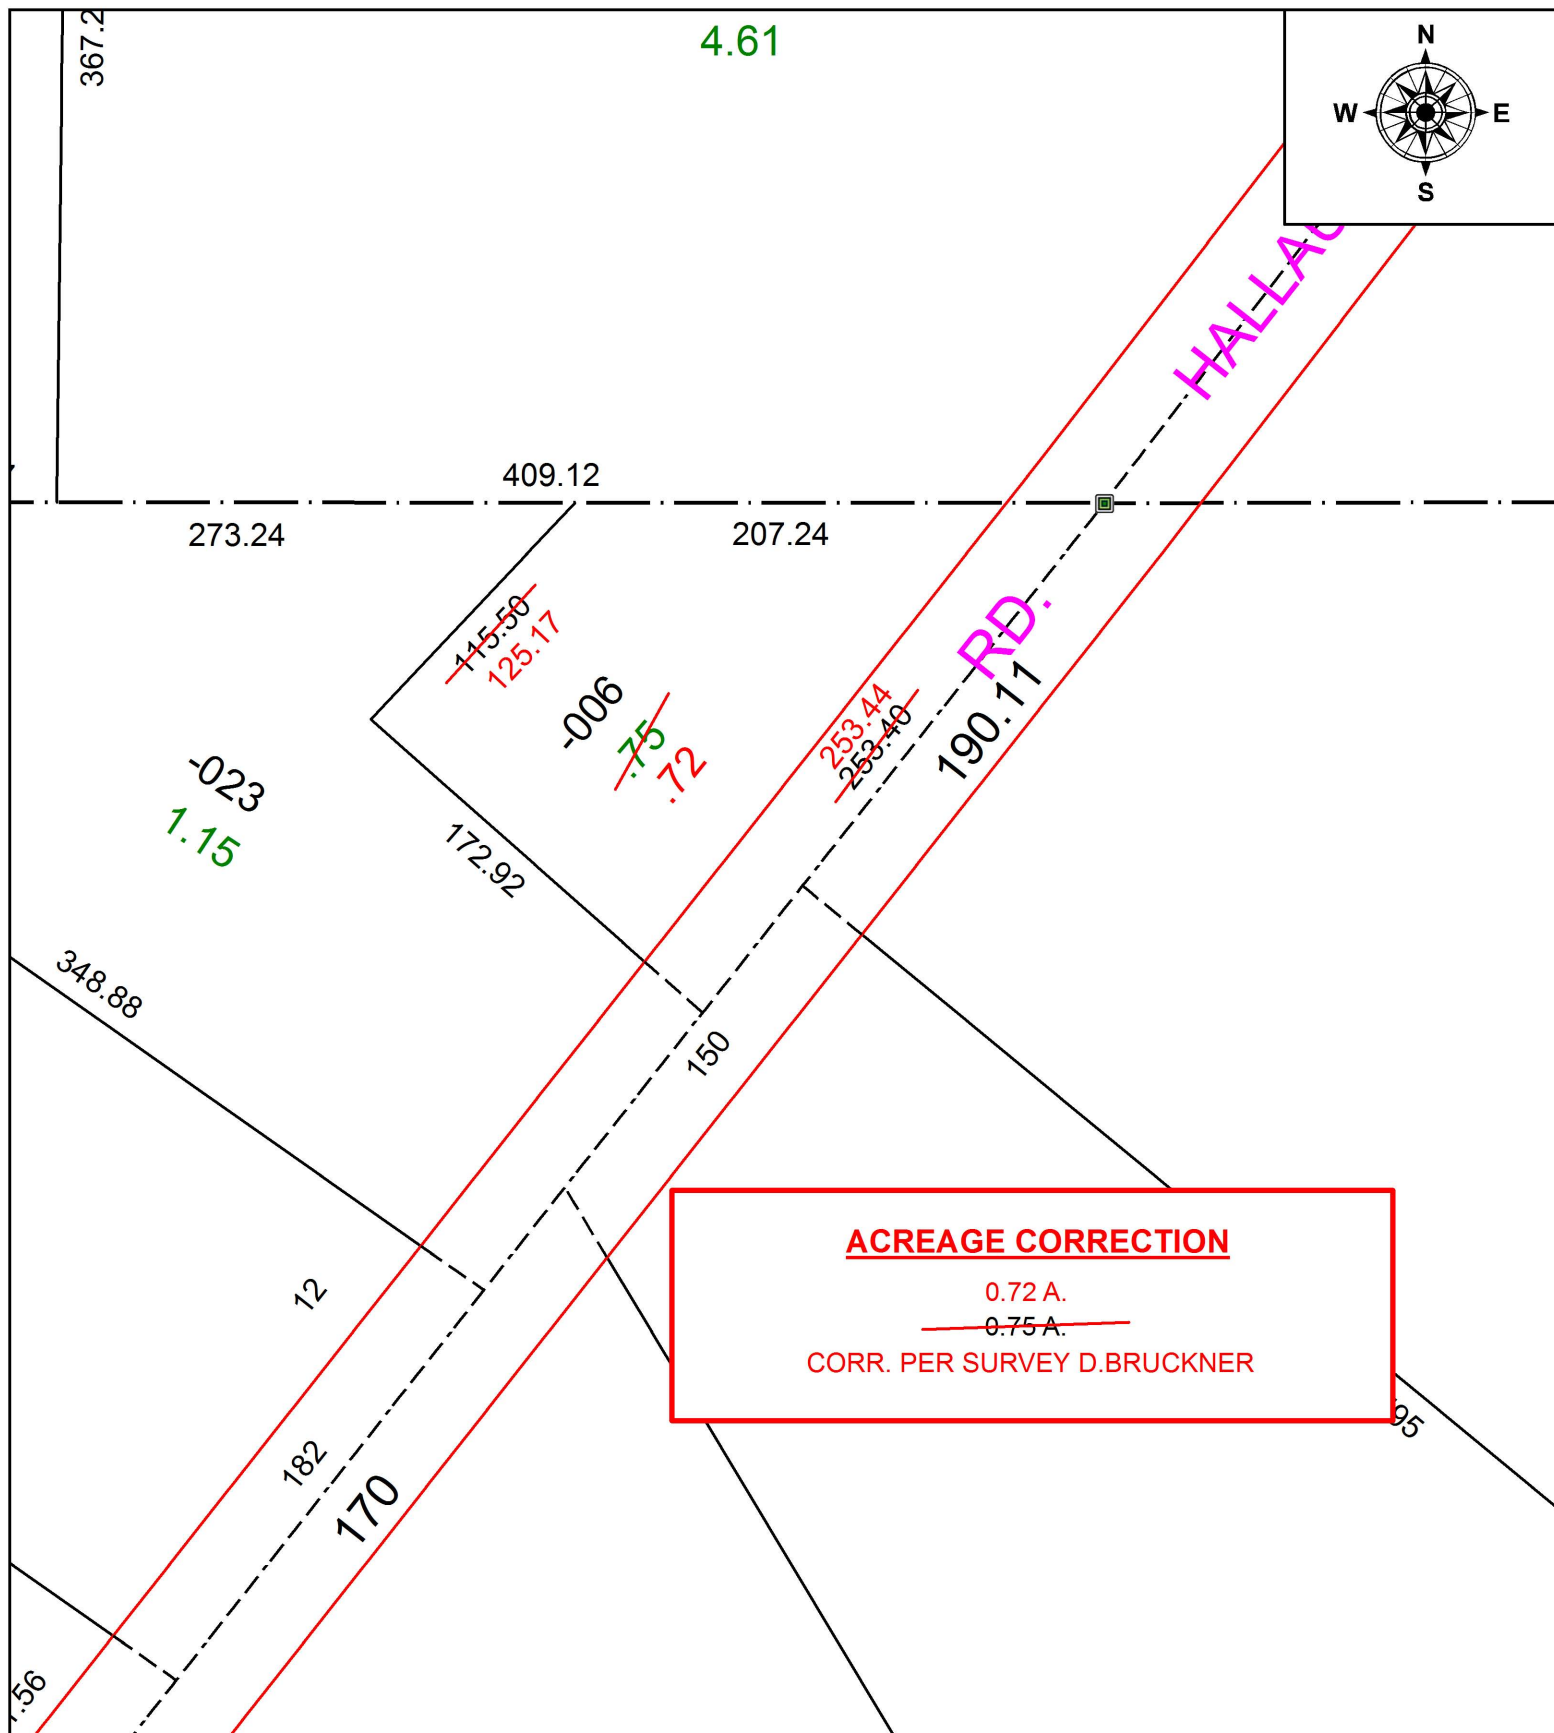

**ACREAGE CORRECTION**  
 0.72 A.  
~~0.75 A.~~  
 CORR. PER SURVEY D.BRUCKNER



**SPLITS/DEEDS PROCESSED**  
 LORAIN COUNTY TAX MAP DEPARTMENT  
 226 MIDDLE AVE. ELYRIA, OH

SURVEYED BY: DAVID J. BRUCKNER  
 CLOSURE: 1:274,751  
 MAP PAGE(S): 14-G  
 APPROVED BY: RRM DATE: 3-28-16  
 SCALE: 1" = 75' PRIOR INSTRUMENT: 20140501932