


PARENT PARCEL: 16-00-080-000-001

CHILD PARCEL: 16-00-080-000-026, -027

STARTING POINT: CENTERLINE OF LAW RD & O.L. 80 GRAFTON TWP

15-03406

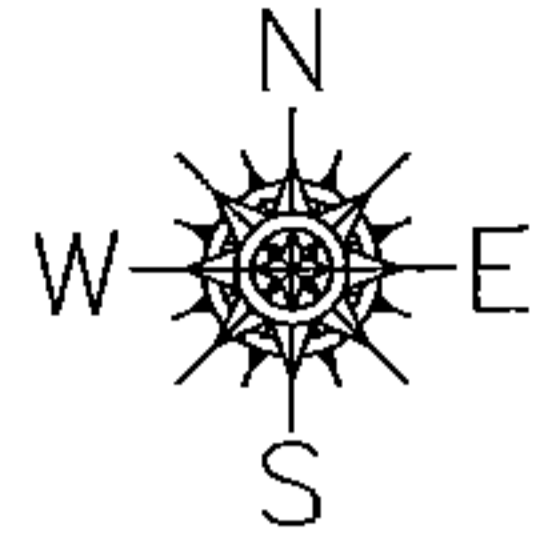

LAW

RD

646.51

646.51

LAGRANGE TWP

GRAFTON TWP

1393.26

1402.38

1411.52

-026
20.75 A.


~~-001~~
~~41.00 A.~~
-027
~~20.25 A.~~
20.93 A.
A CORR SURVEY
BRENT ANDERSON

O.L. 71

O.L. 80

646.49

649.31

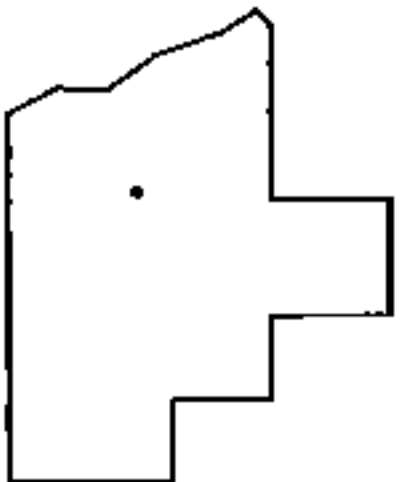

SPLITS/DEEDS PROCESSED

LORAIN COUNTY TAX MAP DEPARTMENT
226 MIDDLE AVE. ELYRIA, OHIO

SURVEYED BY: BRENT ANDERSON

CLOSURE: 0.00 : 10,000

MAP PAGE(S): 16-E

APPROVED BY: JAH DATE: 8-10-2015

SCALE: 1" = 200 PRIOR INSTRUMENT: 20150551703