
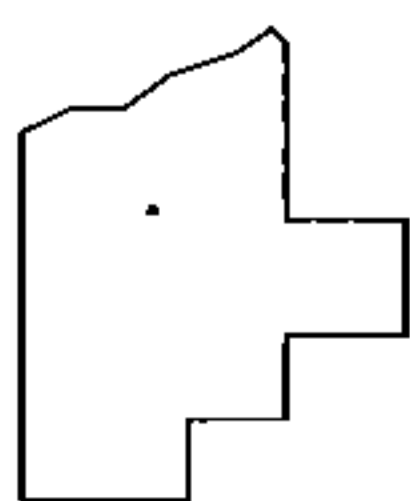
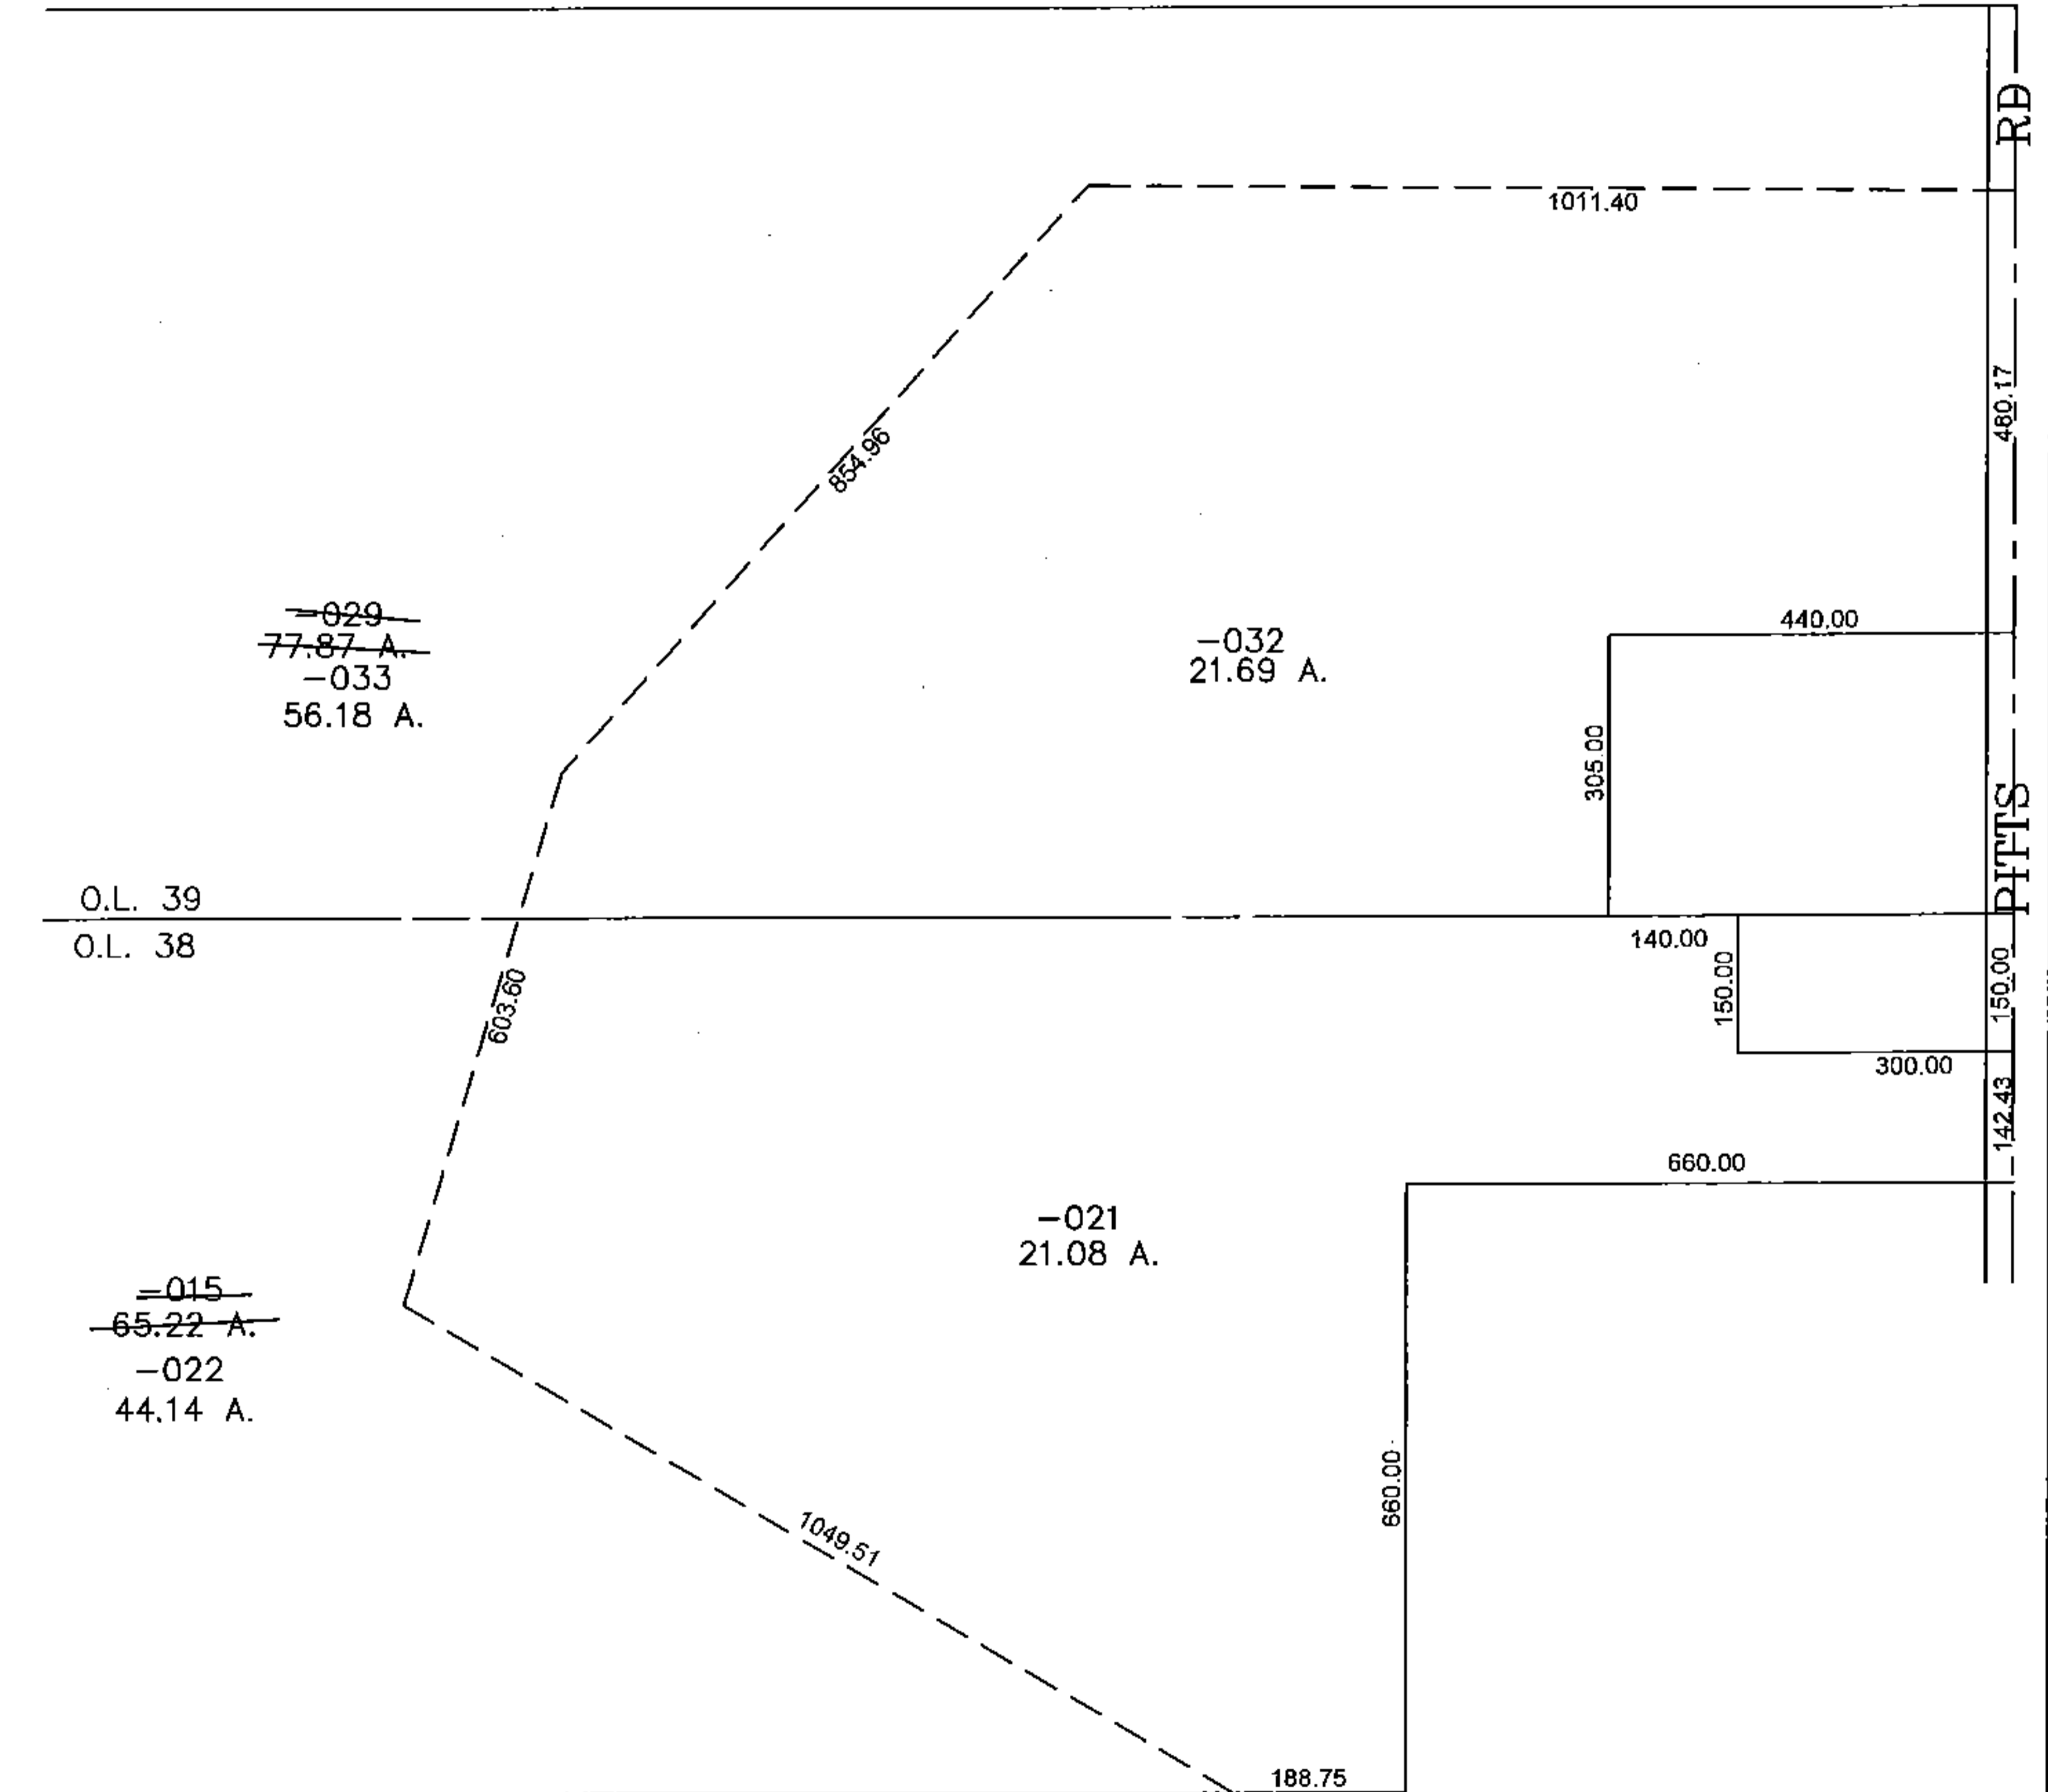


PARENT PARCEL: 1800-038-000-015, 18-00-039-000-029

CHILD PARCEL: 18-00-038-000-021, -022 18-00-039-000-032, -033

STARTING POINT: XXXXXX

15-03407

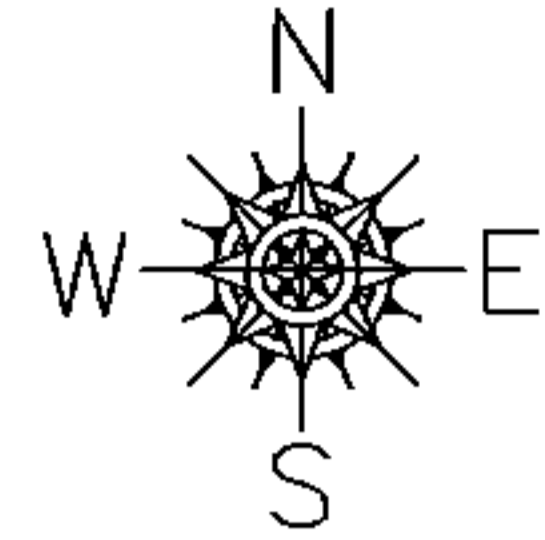

**SPLITS/DEEDS PROCESSED**

LORAIN COUNTY TAX MAP DEPARTMENT  
226 MIDDLE AVE. ELYRIA, OHIO

SURVEYED BY: RICHARD CARLSON

CLOSURE: 0.00 : 10.000

MAP PAGE(S): 18-E

APPROVED BY: JAH DATE: 8/11/2015

SCALE: 1" = 300 PRIOR INSTRUMENT: 20140529280