
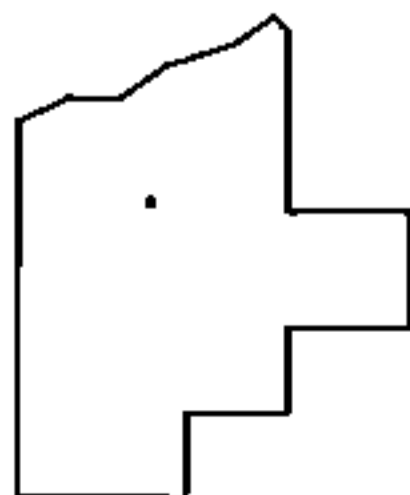
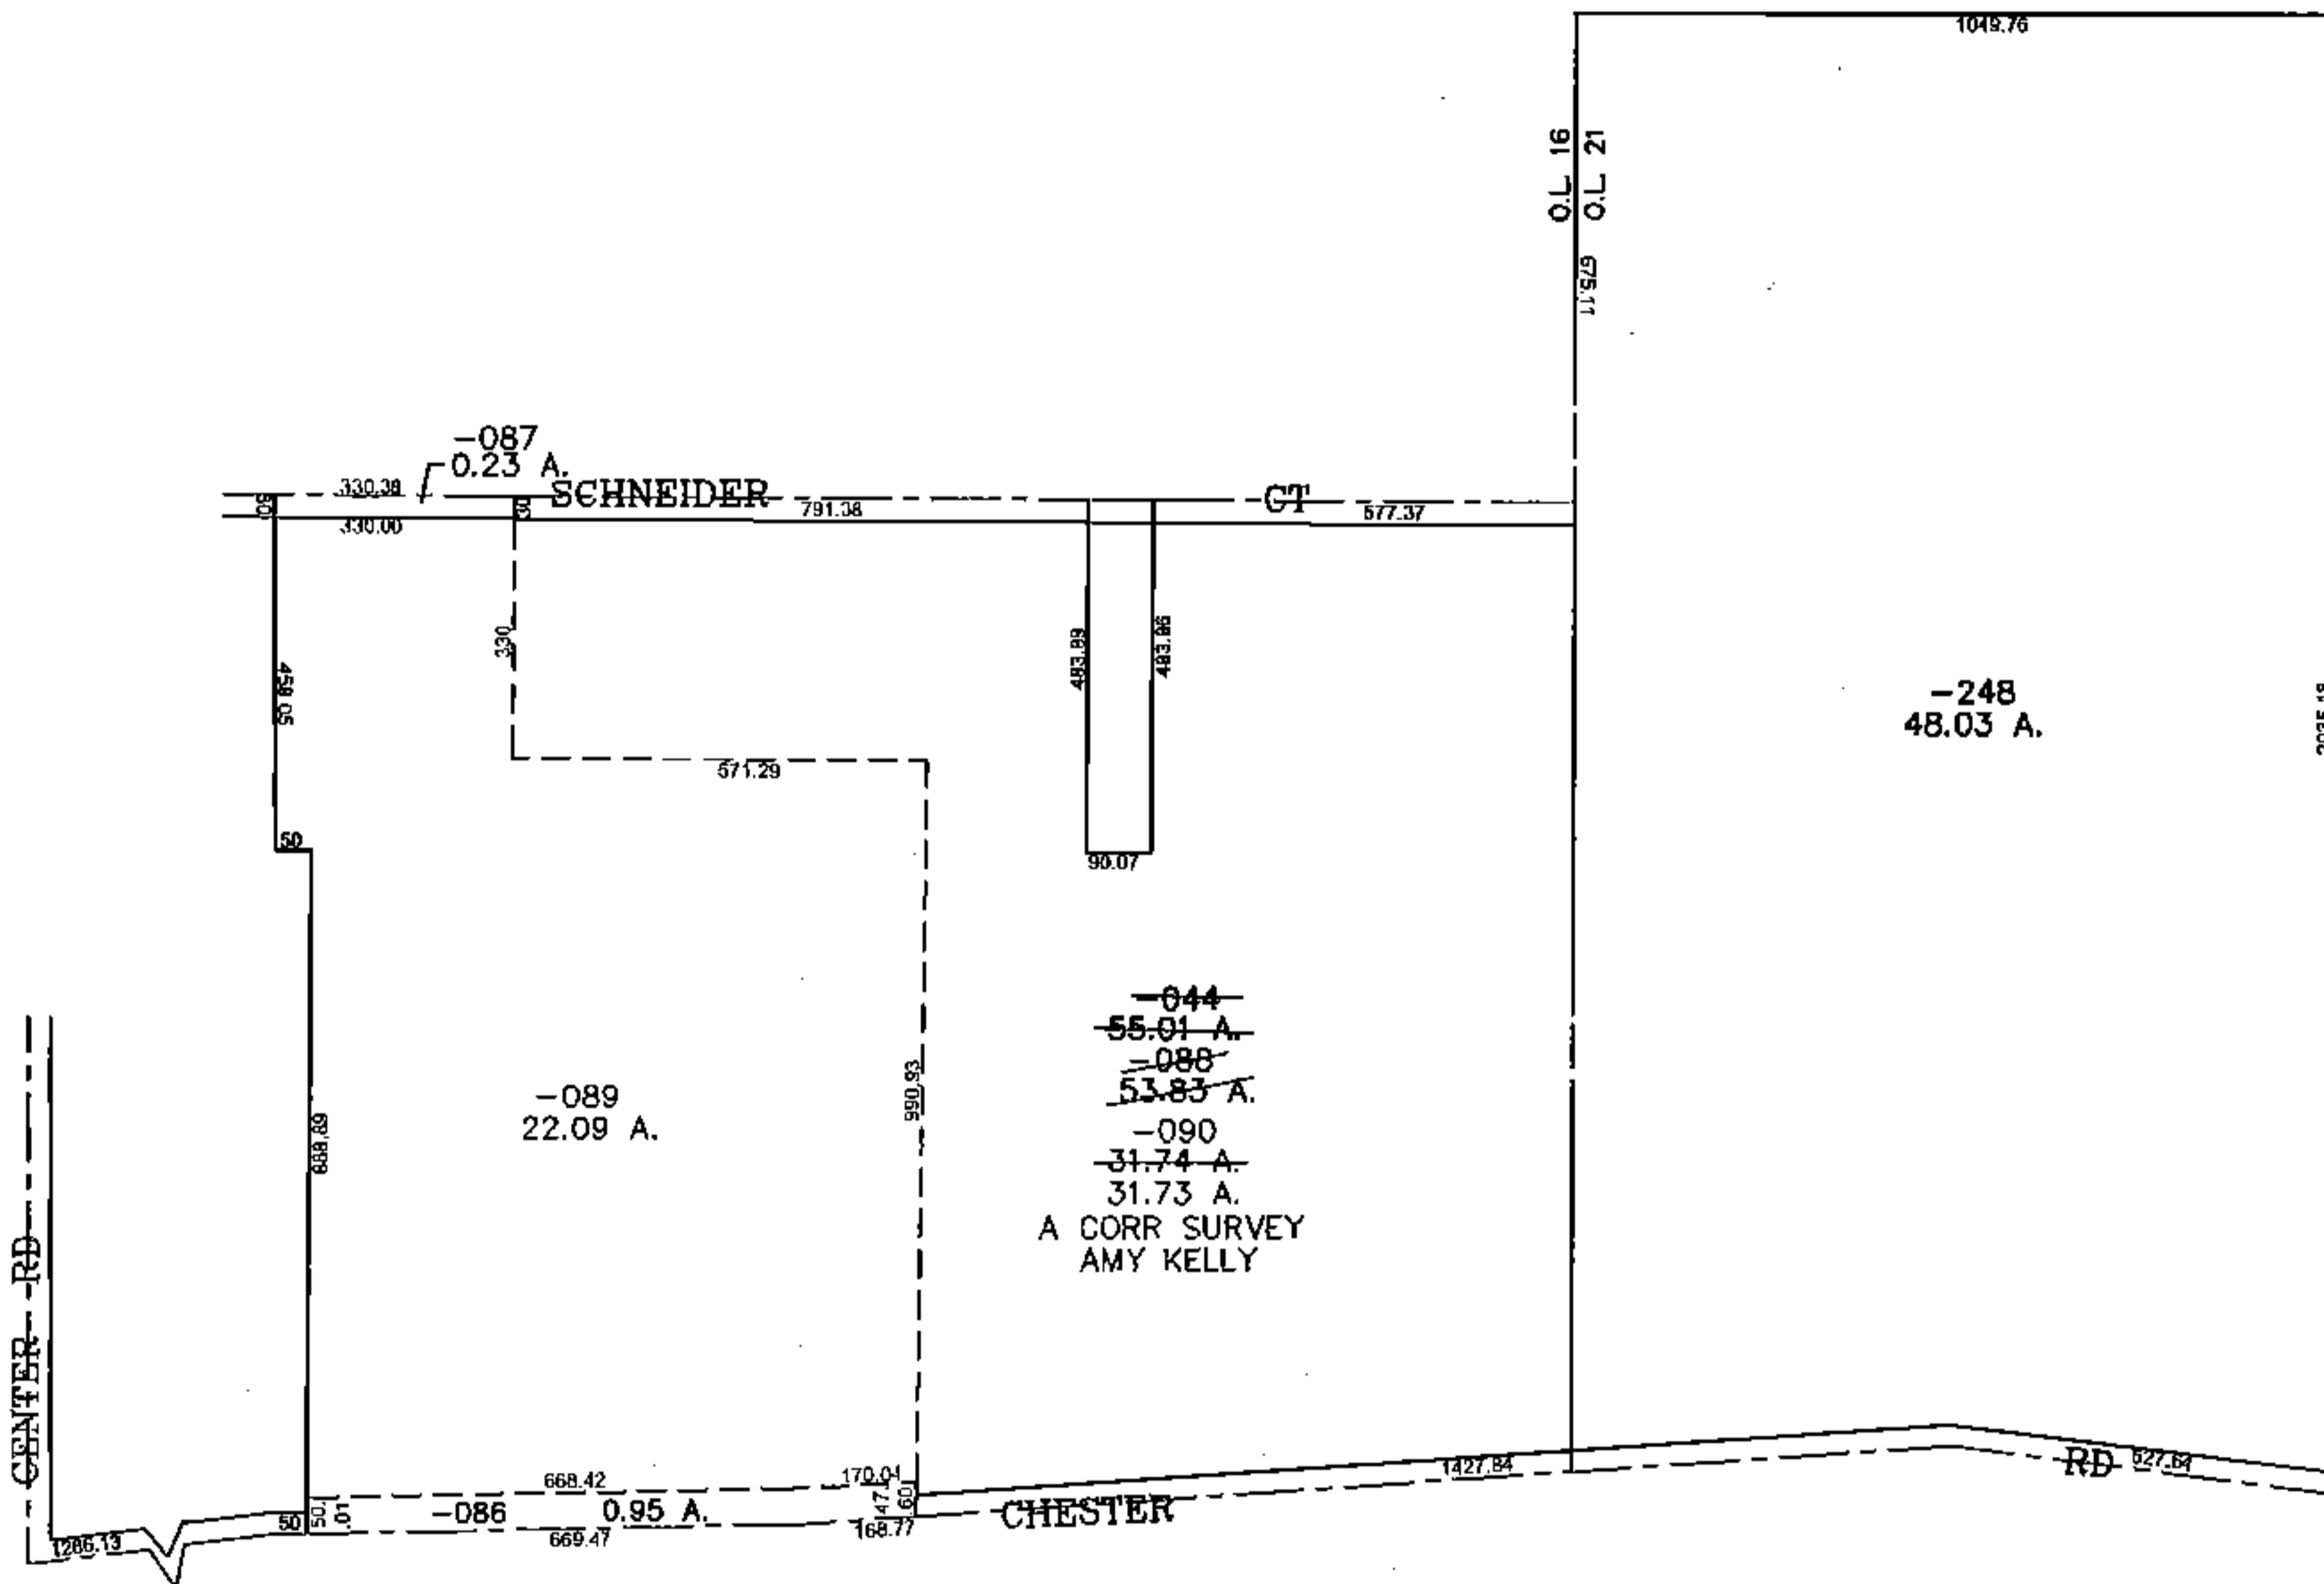


PARENT PARCEL: 04-00-016-102-044, 04-00-021-000-248

CHILD PARCEL: 04-00-016-102-086 THRU -090

STARTING POINT: CENTERLINE OF CENTER RD & CHESTER RD

15-03410

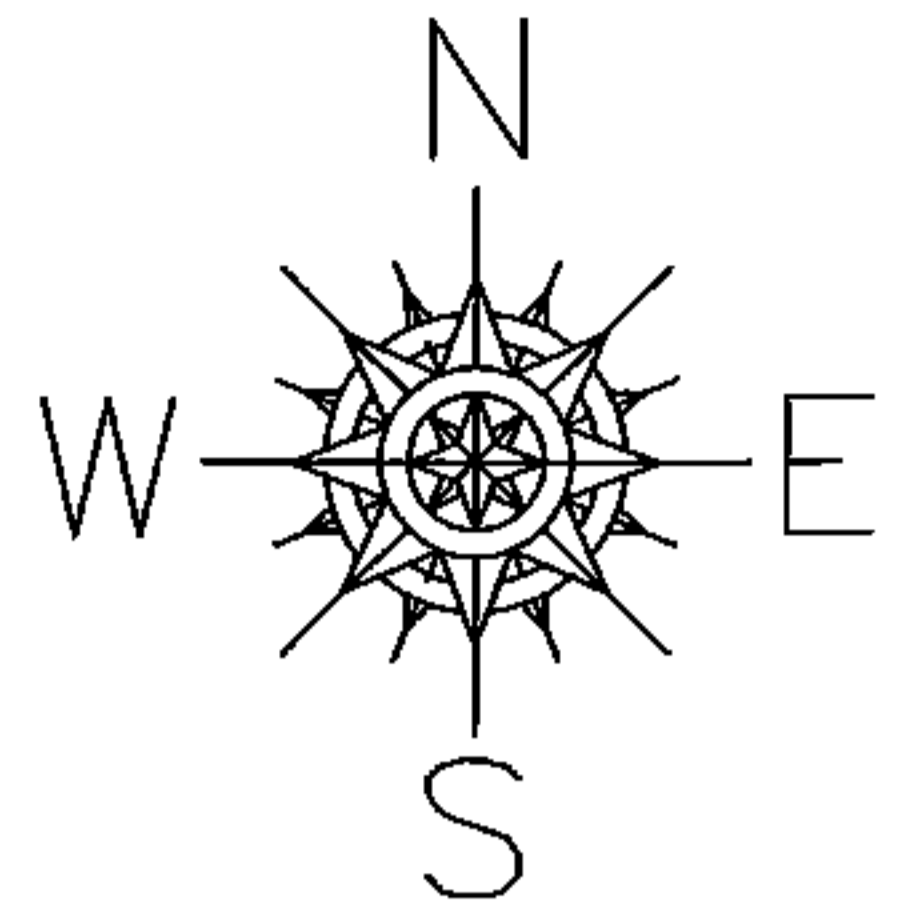

SPLITS/DEEDS PROCESSED

LORAIN COUNTY TAX MAP DEPARTMENT
226 MIDDLE AVE. ELYRIA, OHIO

SURVEYED BY: AMY KELLY
 CLOSURE: 0.00 : 10,000
 MAP PAGE(S): 04-00-016-H
 APPROVED BY: JH & RRM DATE: 8-17-15
 SCALE: 1" = 500 PRIOR INSTRUMENT: 20080263879