
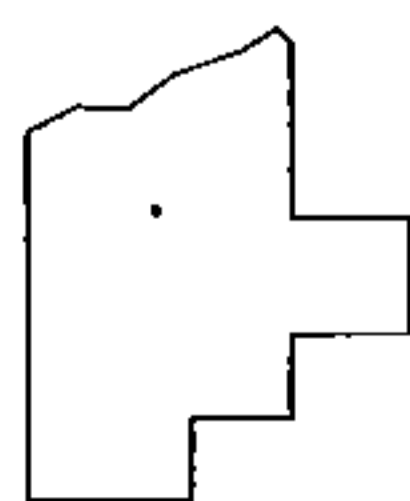
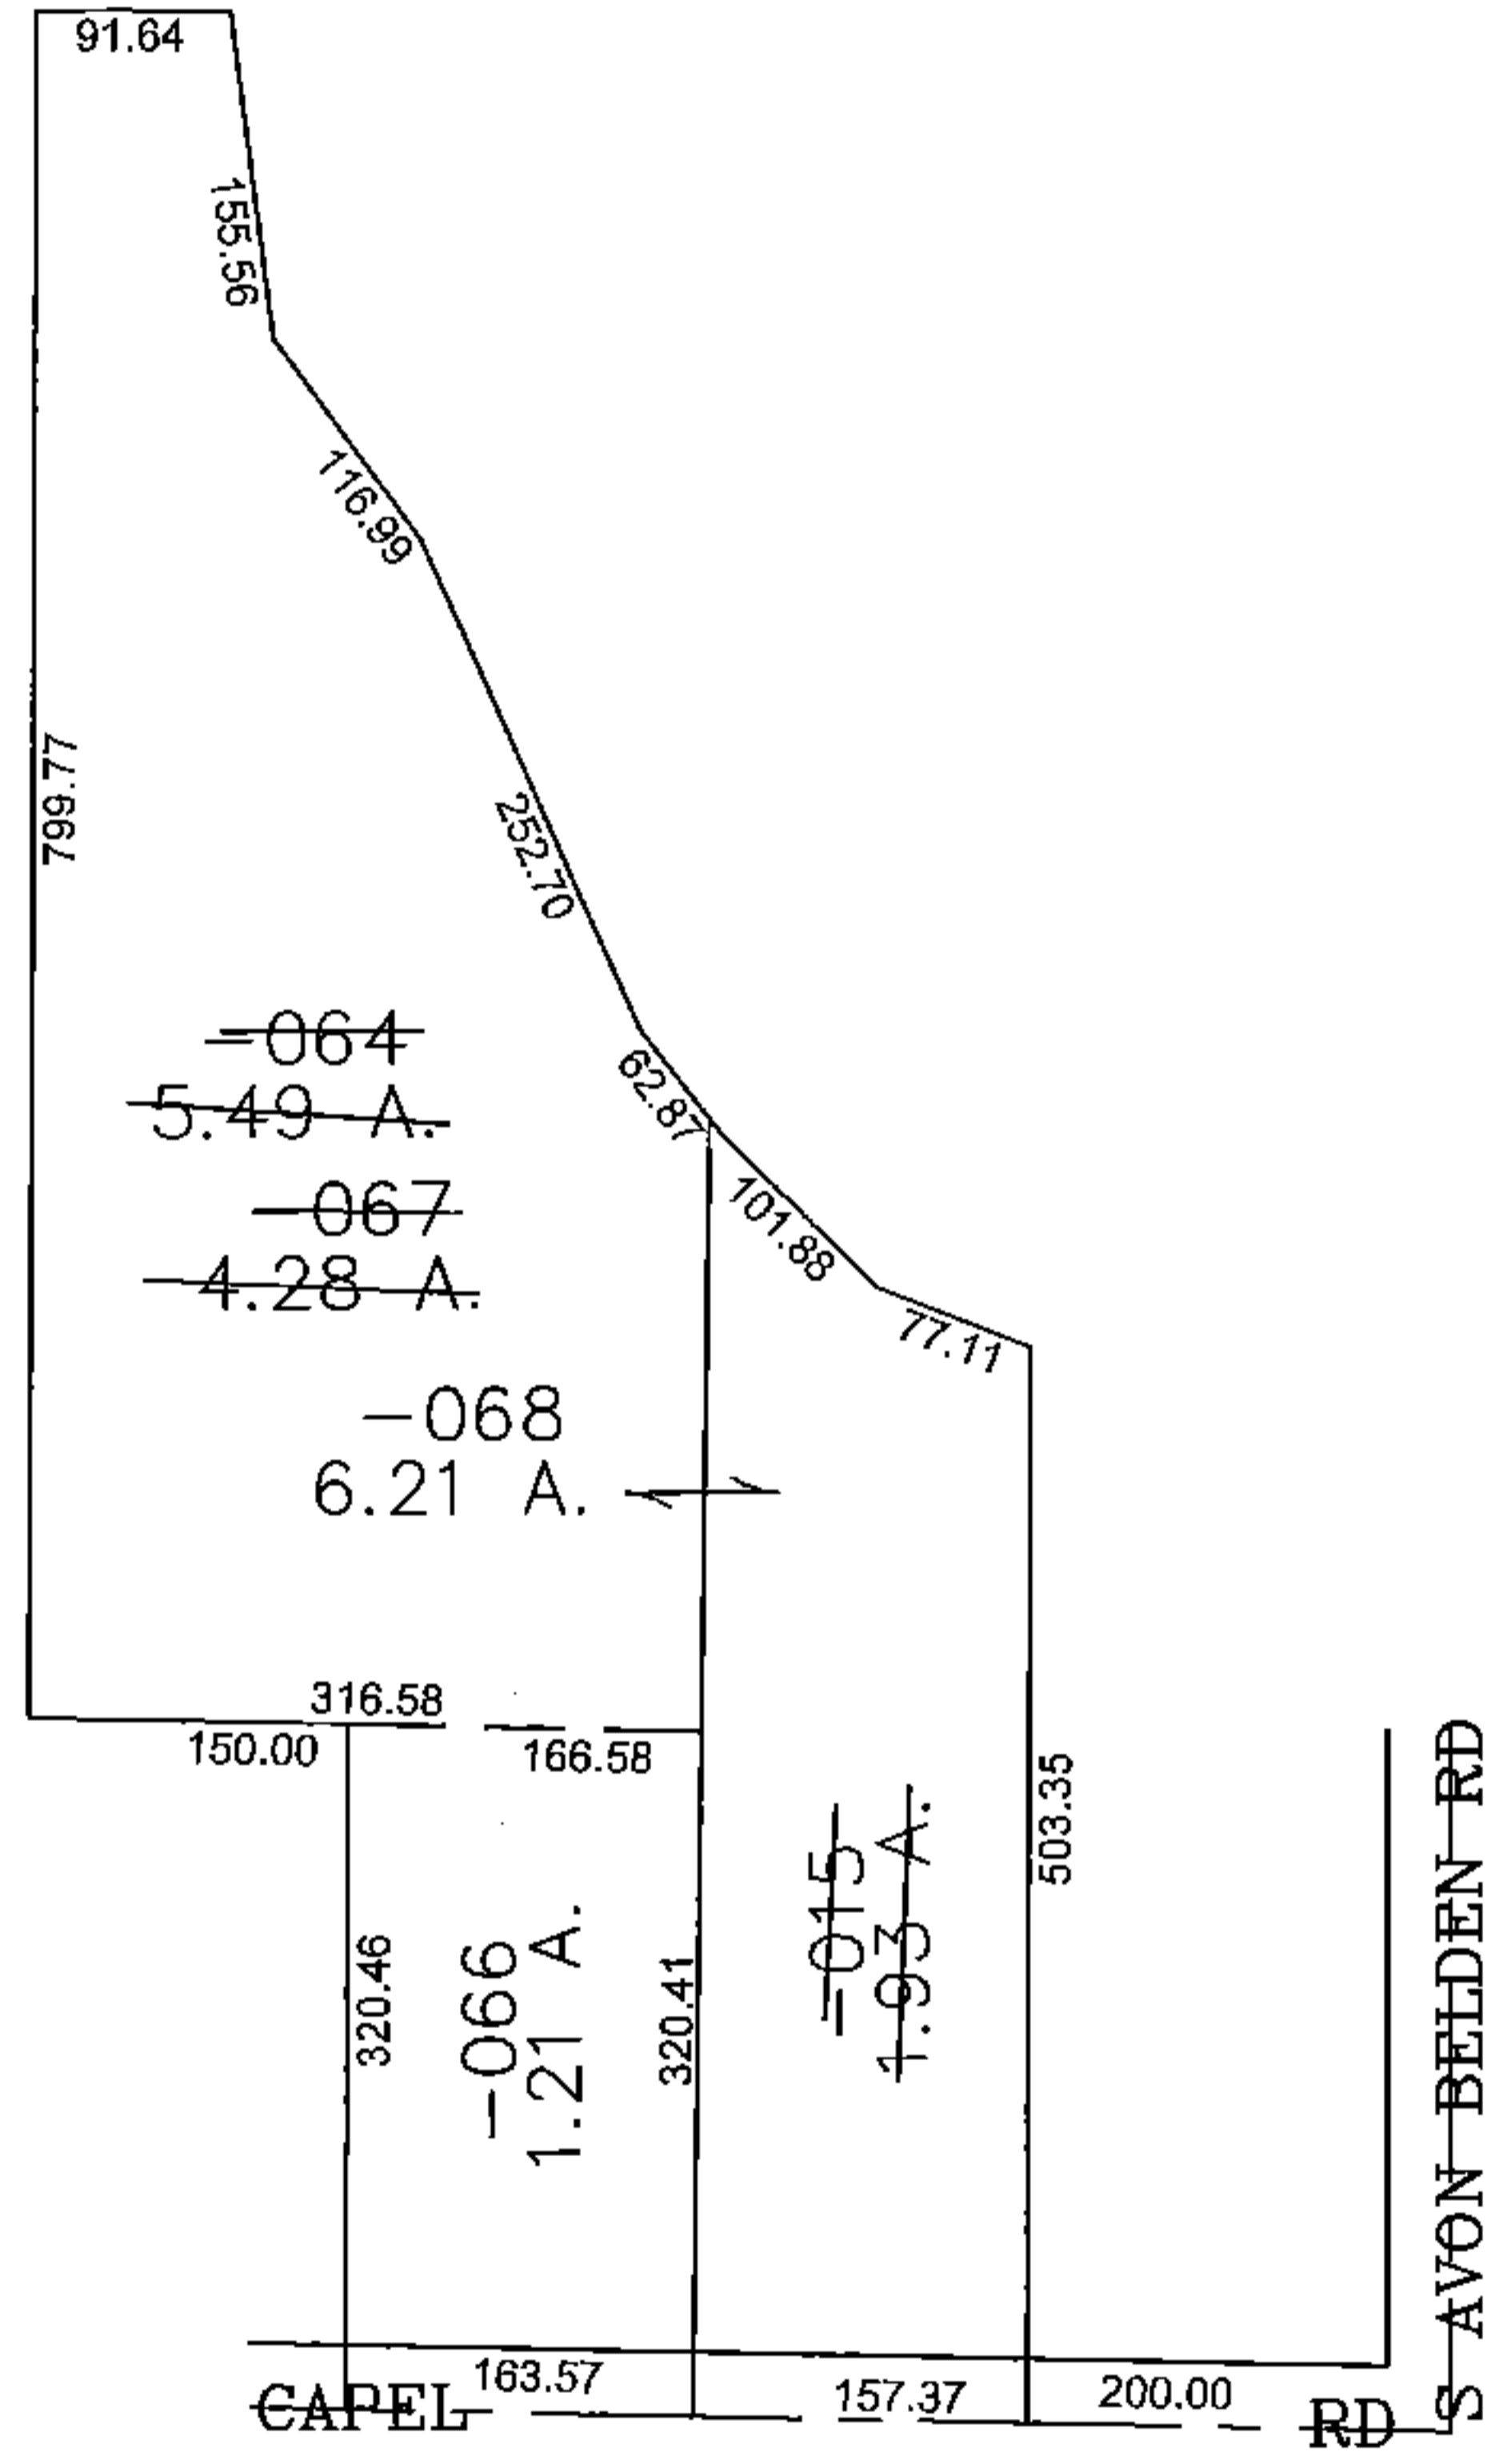


PARENT PARCEL: 11-00-057-000-064, -015  
 CHILD PARCEL: 11-00-057-000-066, -067, -068  
 STARTING POINT: CENTERLINE OF CAPEL RD & S AVON BELDEN RD

15-03411

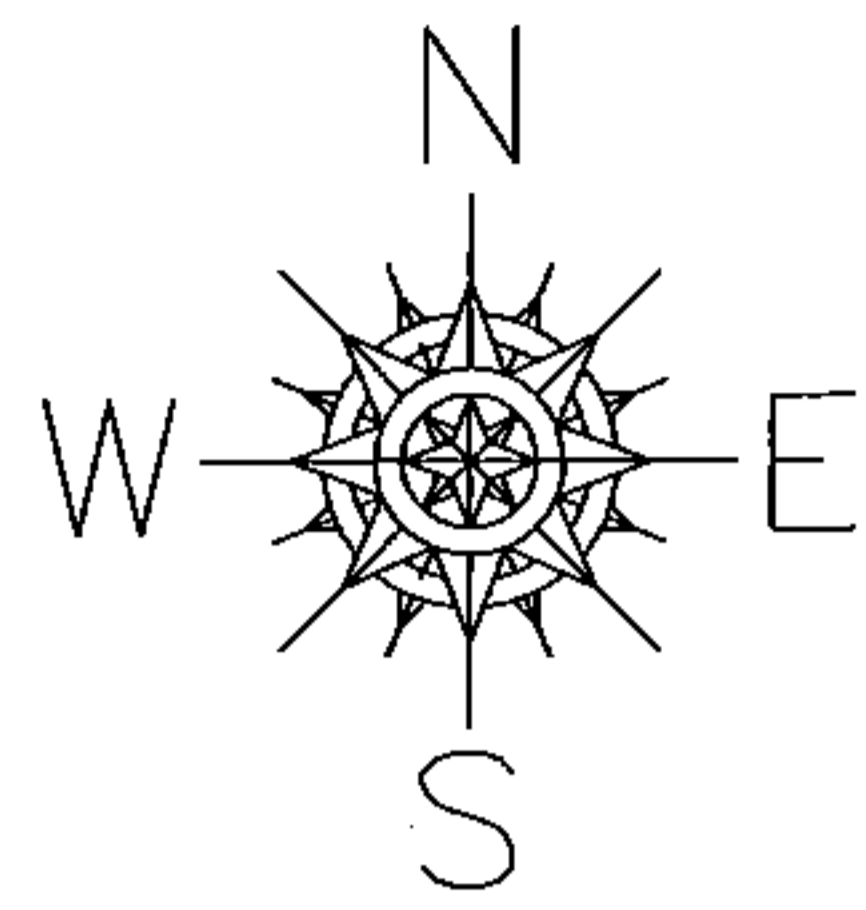

**SPLITS/DEEDS PROCESSED**  
 LORAIN COUNTY TAX MAP DEPARTMENT  
 226 MIDDLE AVE. ELYRIA, OHIO

SURVEYED BY: DALE HAYWOOD  
 CLOSURE: 0.00 : 10.000  
 MAP PAGE(S): 11-00-057-A  
 APPROVED BY: JAH DATE: 8/19/2015  
 SCALE: 1" = 200' PRIOR INSTRUMENT: 20000705840