


PARENT PARCEL: 01-00-044-000-046

CHILD PARCEL: XX-XX-XXX-XXX-XXX

STARTING POINT: NORTHEAST CORNER OF LAND CONVEYED TO TENANT W. WILSON (DV 239/189)

16-03412-A

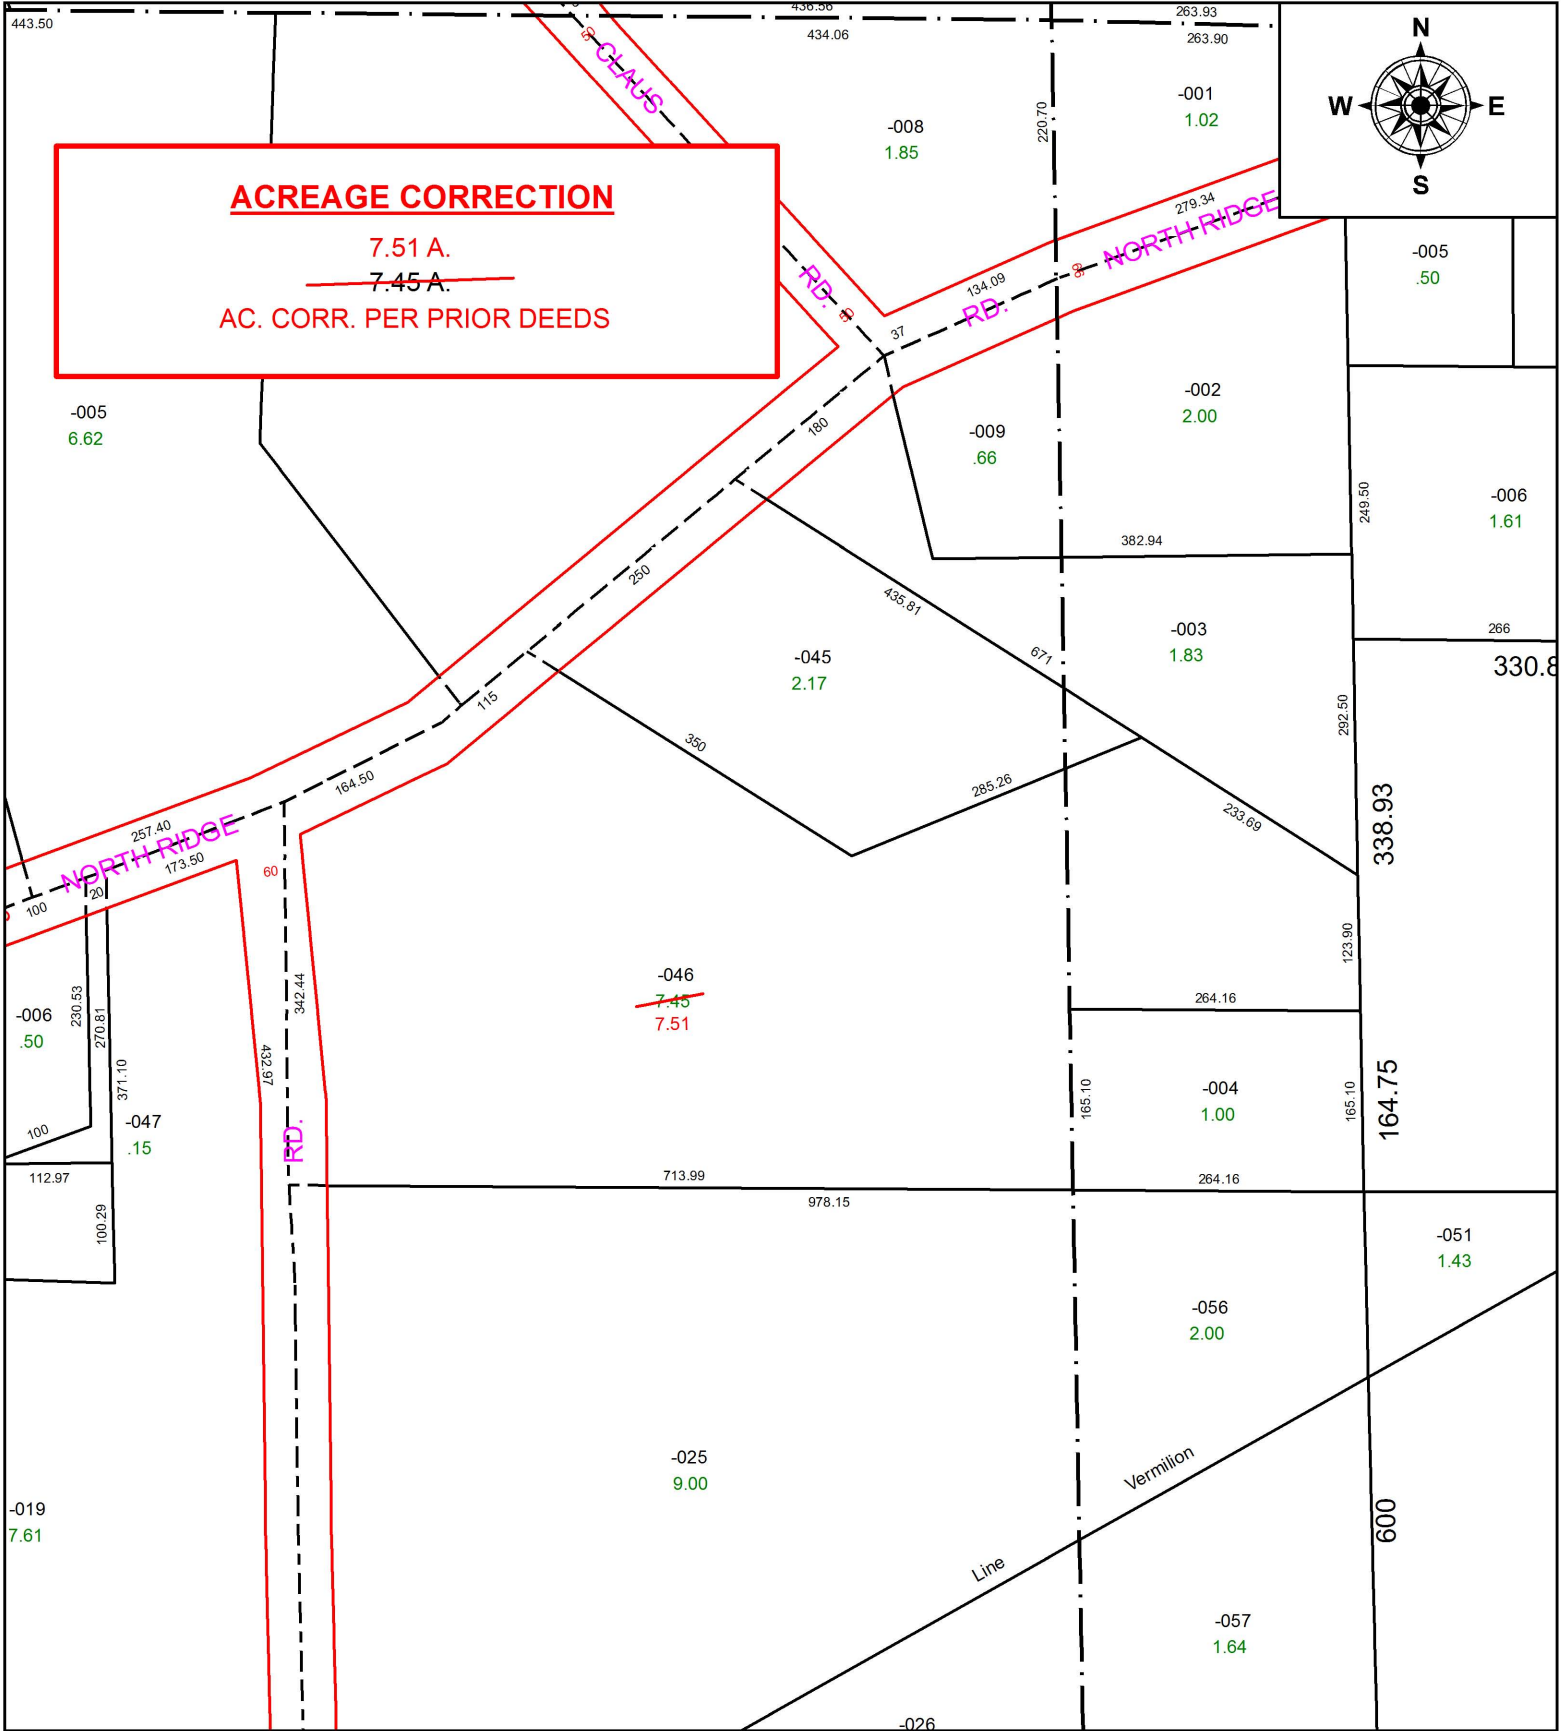

SPLITS/DEEDS PROCESSED
 LORAIN COUNTY TAX MAP DEPARTMENT
 226 MIDDLE AVE. ELYRIA, OH

SURVEYED BY: _____ N/A
 CLOSURE: _____ N/A
 MAP PAGE(S): _____ 1-00-044-B
 APPROVED BY: _____ RRM DATE: _____ 3-29-16
 SCALE: _____ 1" = 175 PRIORITY INSTRUMENT: _____ N/A