
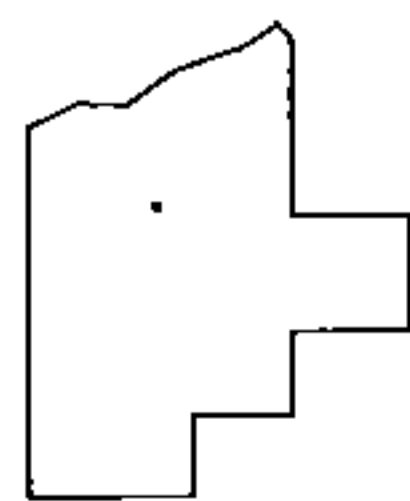
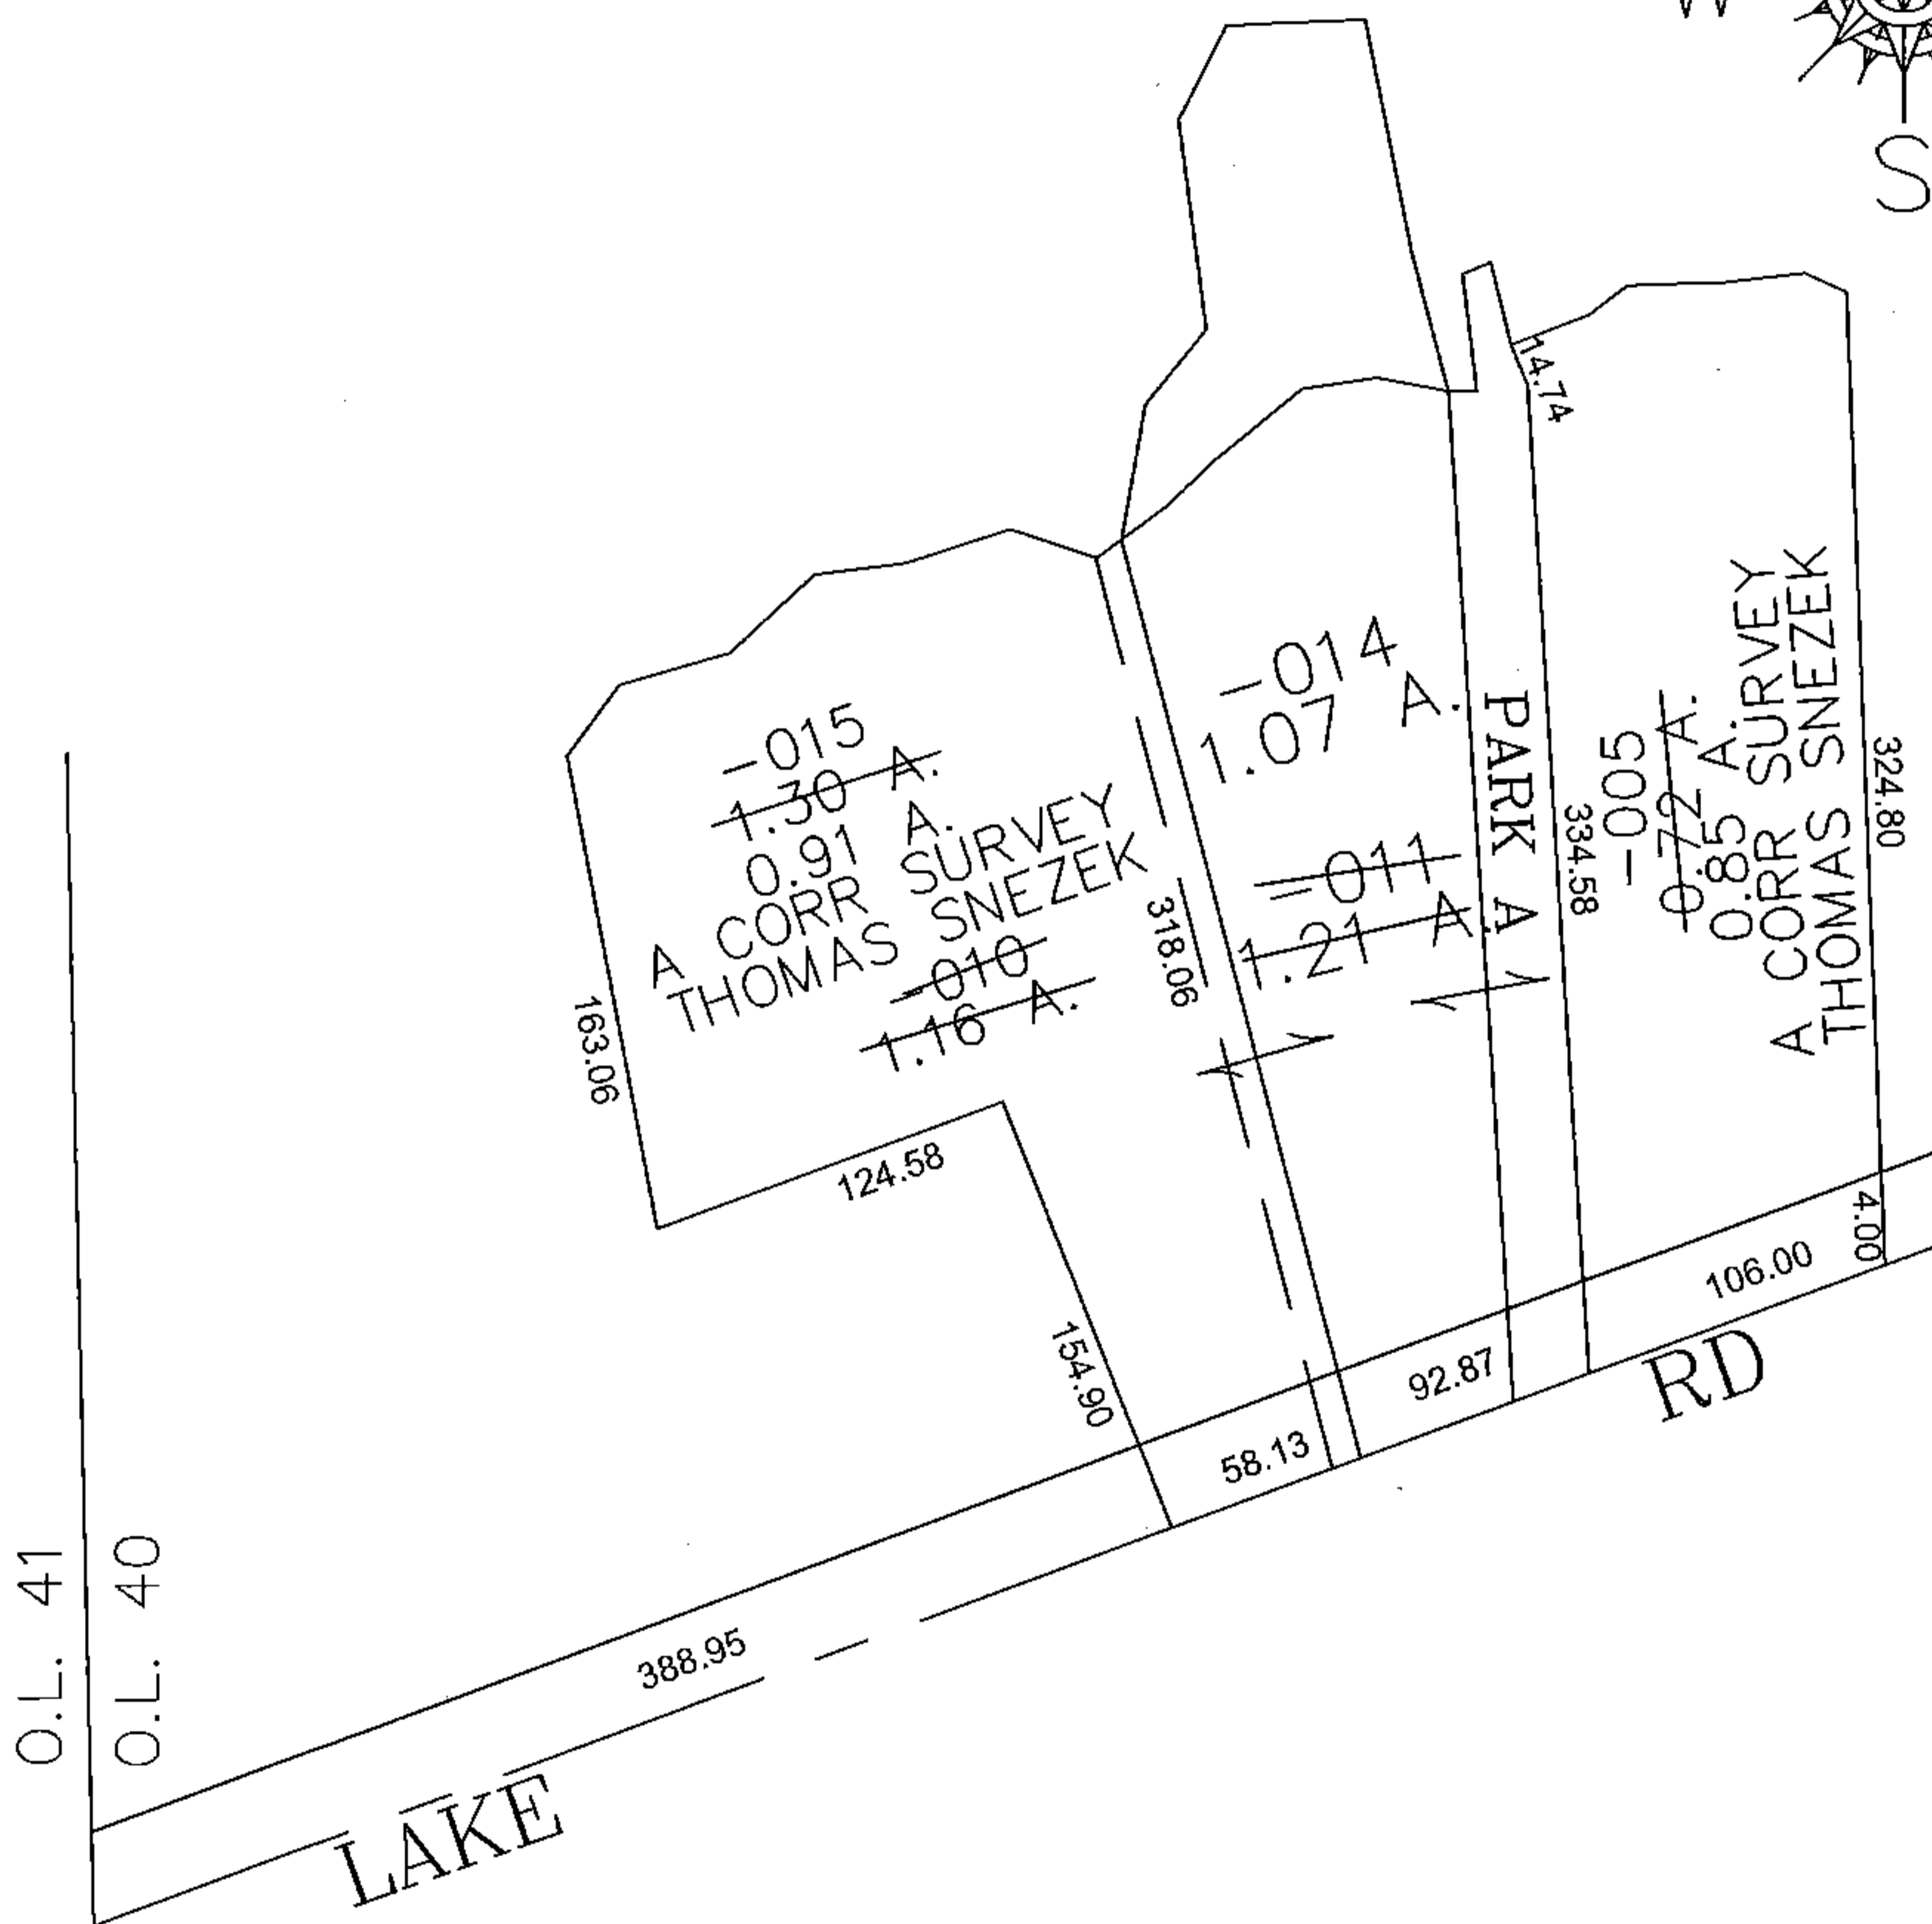


PARENT PARCEL: 03-00-040-101-010, -011, -005

CHILD PARCEL: 03-00-040-101-014, -015

STARTING POINT: CENTERLINE OF LAKE RD & O.L. 40

15-03412

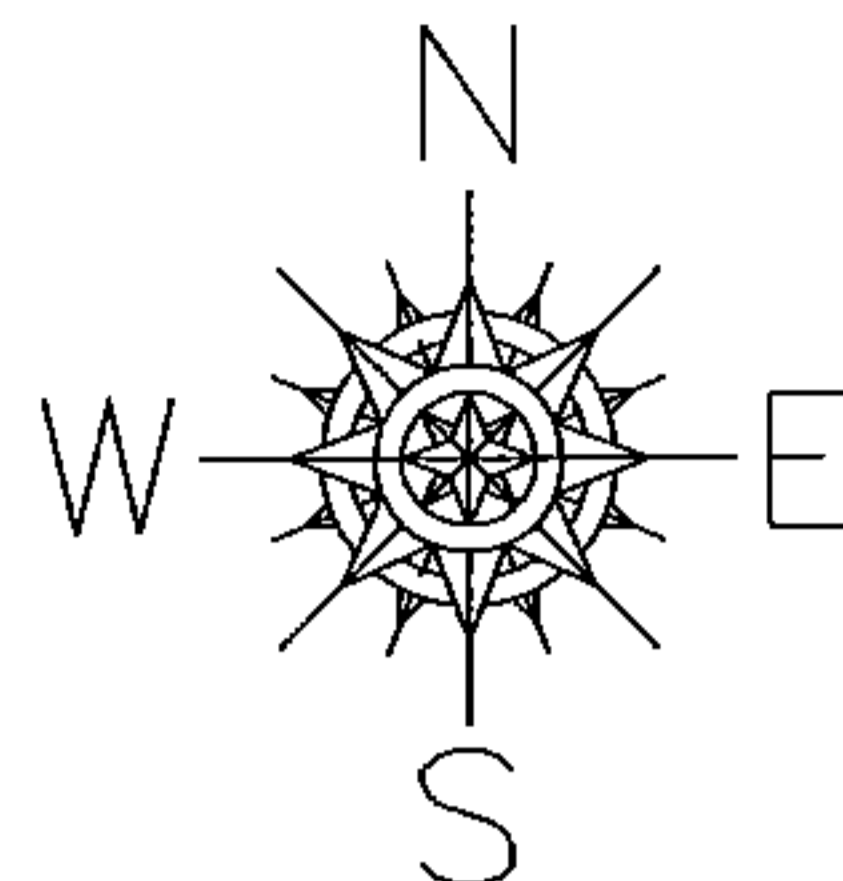

SPLITS/DEEDS PROCESSED

LORAIN COUNTY TAX MAP DEPARTMENT
226 MIDDLE AVE. ELYRIA, OHIO

SURVEYED BY: THOMAS SNEZEK

CLOSURE: 0.00 : 10.000

MAP PAGE(S): 03-00-040

APPROVED BY: JAH DATE: 8/26/2015

SCALE: 1" = 100 PRIOR INSTRUMENT: DV 1072/418