
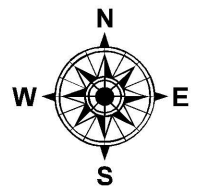


PARENT PARCEL: 05-00-046-000-045

CHILD PARCEL: XX-XX-XXX-XXX-XXX

STARTING POINT: NORTHEAST CORNER OF O.L.47

16-03414-A

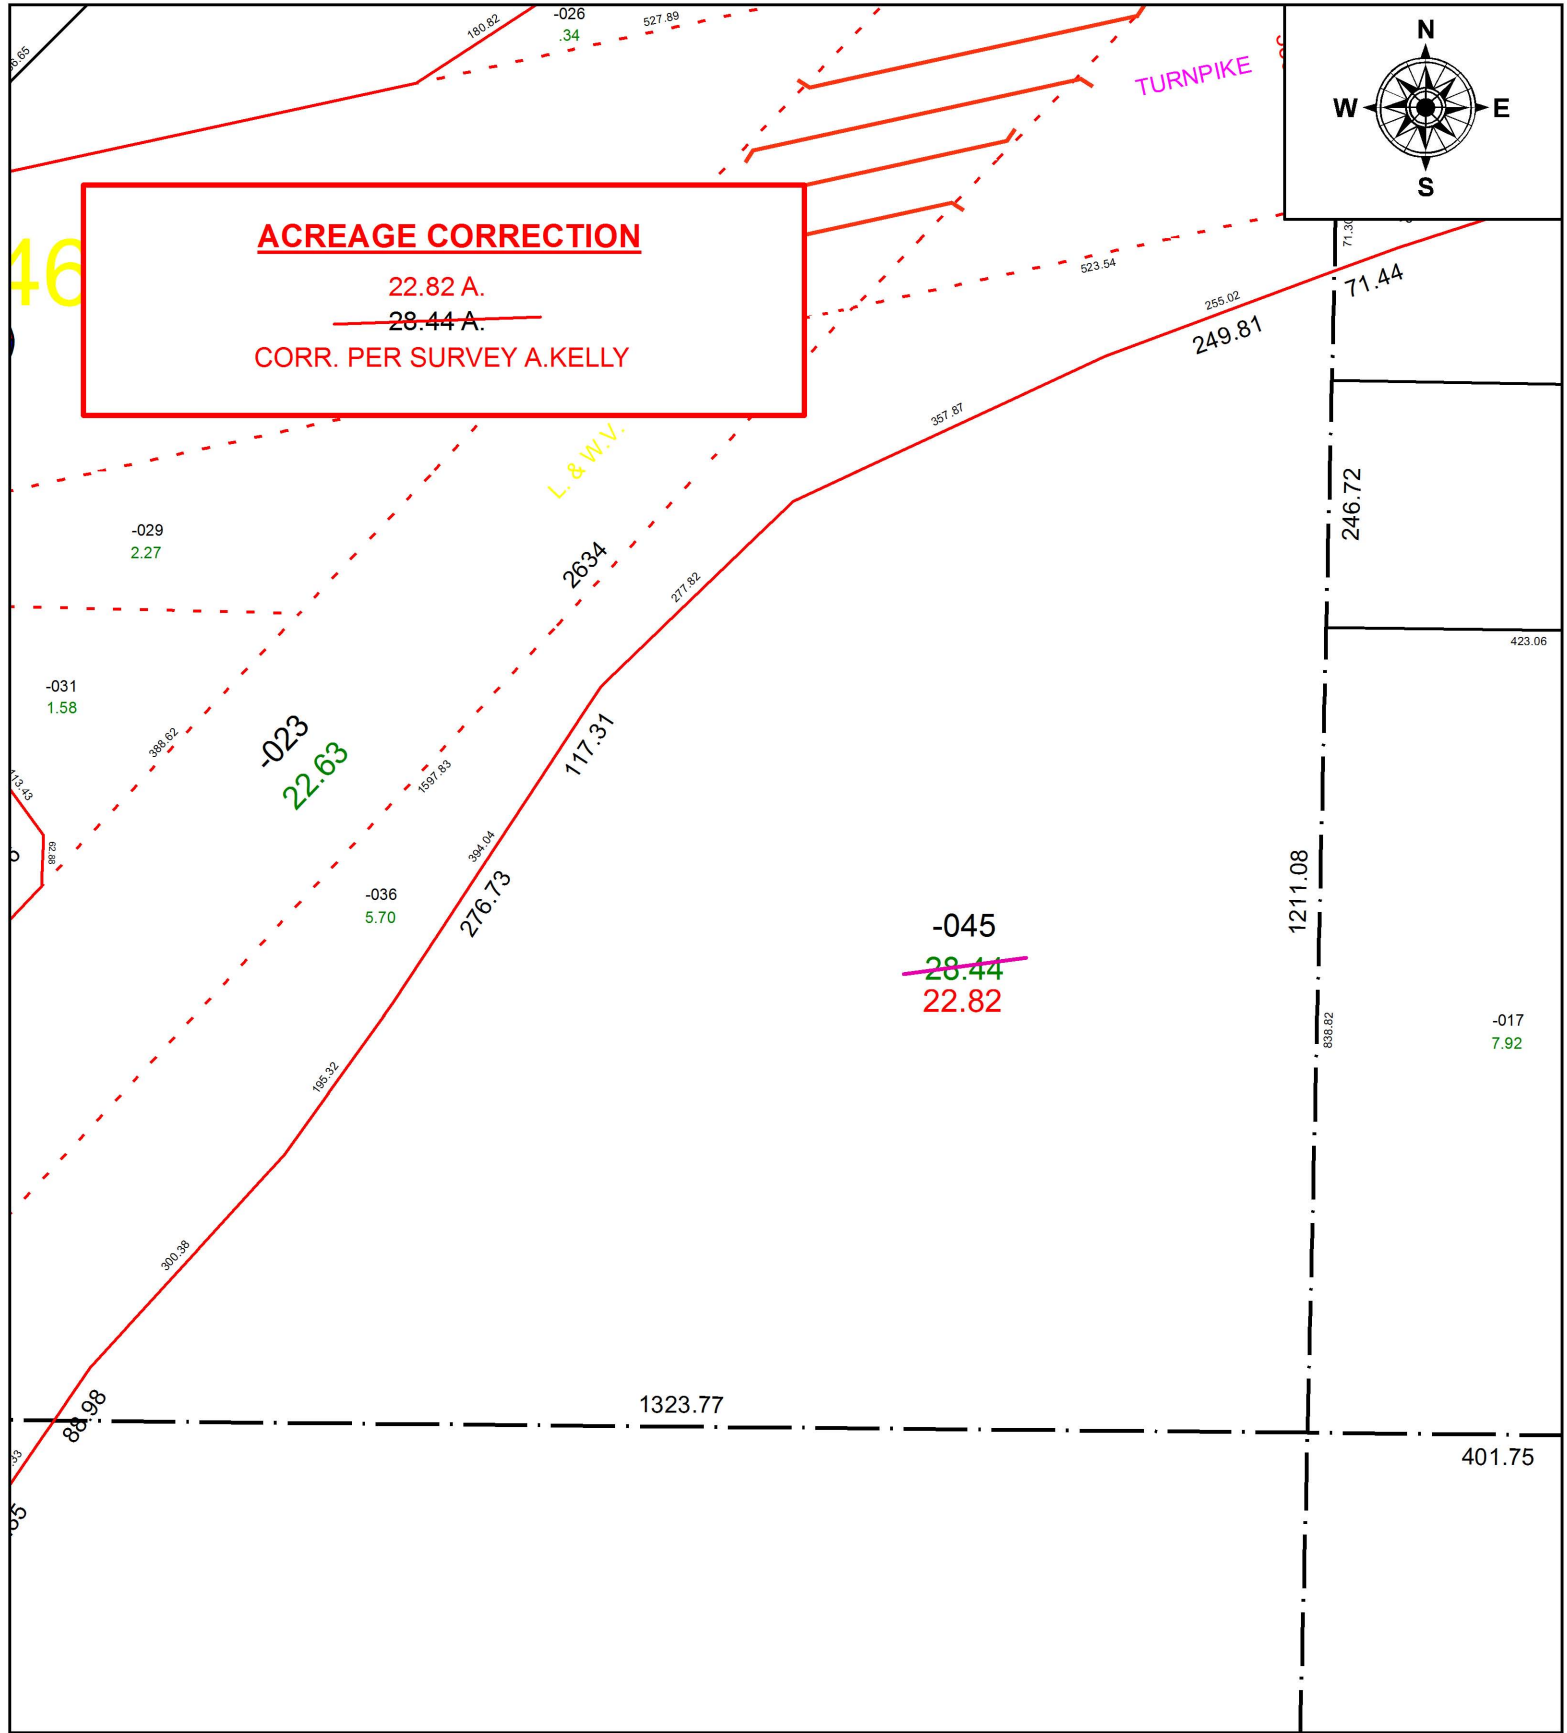

ACREAGE CORRECTION

22.82 A.
~~28.44 A.~~
 CORR. PER SURVEY A.KELLY

46

-023
22.63

-045
~~28.44~~
22.82

-017
7.92

SPLITS/DEEDS PROCESSED
 LORAIN COUNTY TAX MAP DEPARTMENT
 226 MIDDLE AVE. ELYRIA, OH

SURVEYED BY: AMY M. KELLY
 CLOSURE: 1: 417,265
 MAP PAGE(S): 5-00-046
 APPROVED BY: RRM DATE: 4-4-16
 SCALE: 1" = 200 PRIOR INSTRUMENT: 20120401186