
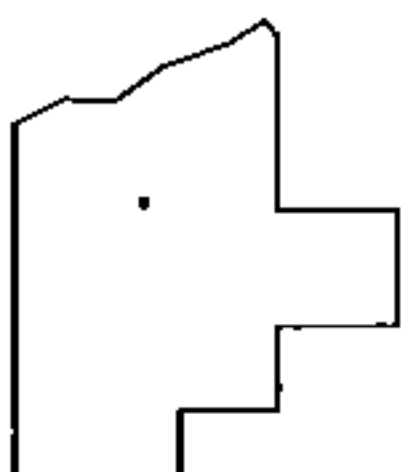
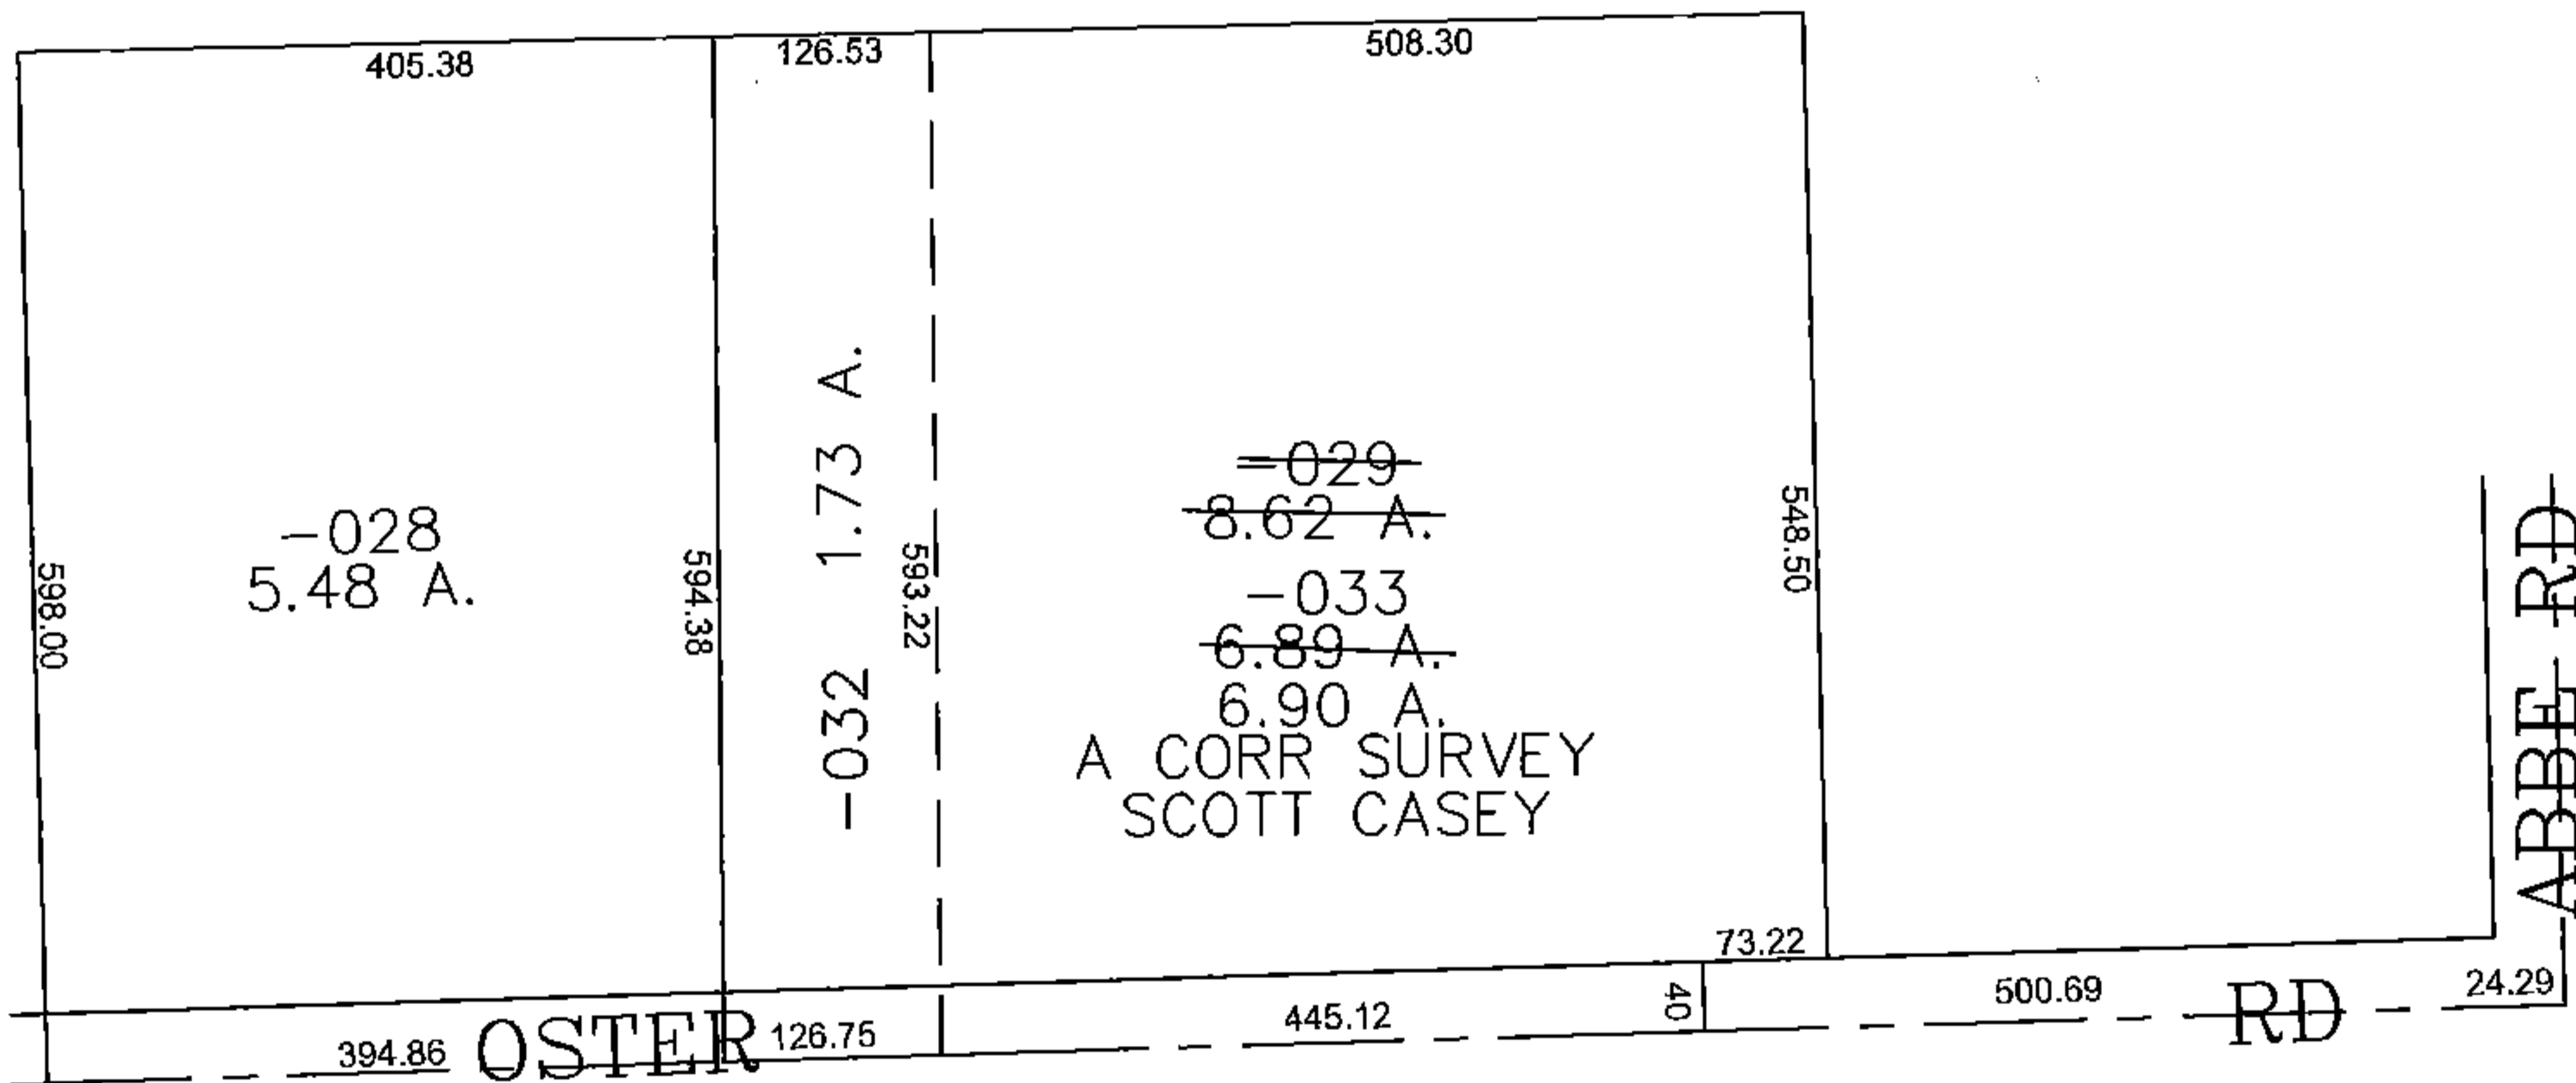


PARENT PARCEL: 03-00-020-000-028 (ST) 03-00-020-000-029

CHILD PARCEL: 03-00-020-000-032, -033

STARTING POINT: CENTERLINE OF OSTER RD & ABBE RD

15-03414

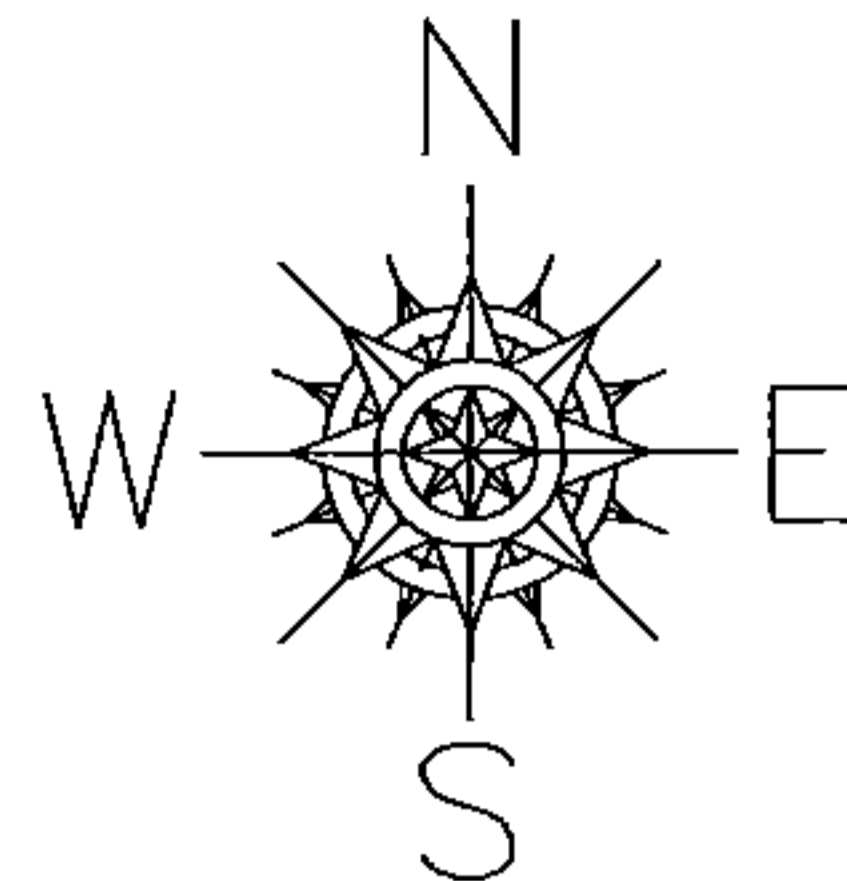

SPLITS/DEEDS PROCESSED
 LORAIN COUNTY TAX MAP DEPARTMENT
 226 MIDDLE AVE. ELYRIA, OHIO

SURVEYED BY: SCOTT CASEY
 CLOSURE: 0.00 : 10.000
 MAP PAGE(S): 03-00-020-A
 APPROVED BY: JAH DATE: 8/28/2015
 SCALE: 1" = 200' PRIOR INSTRUMENT: 20060164561