
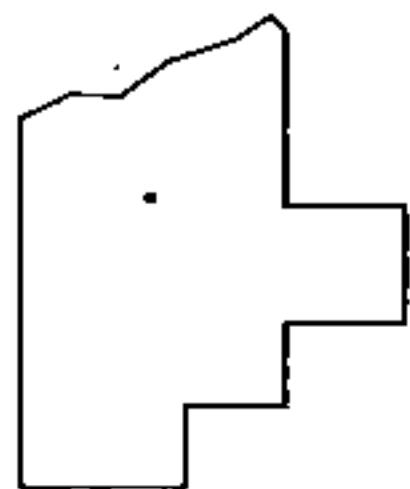
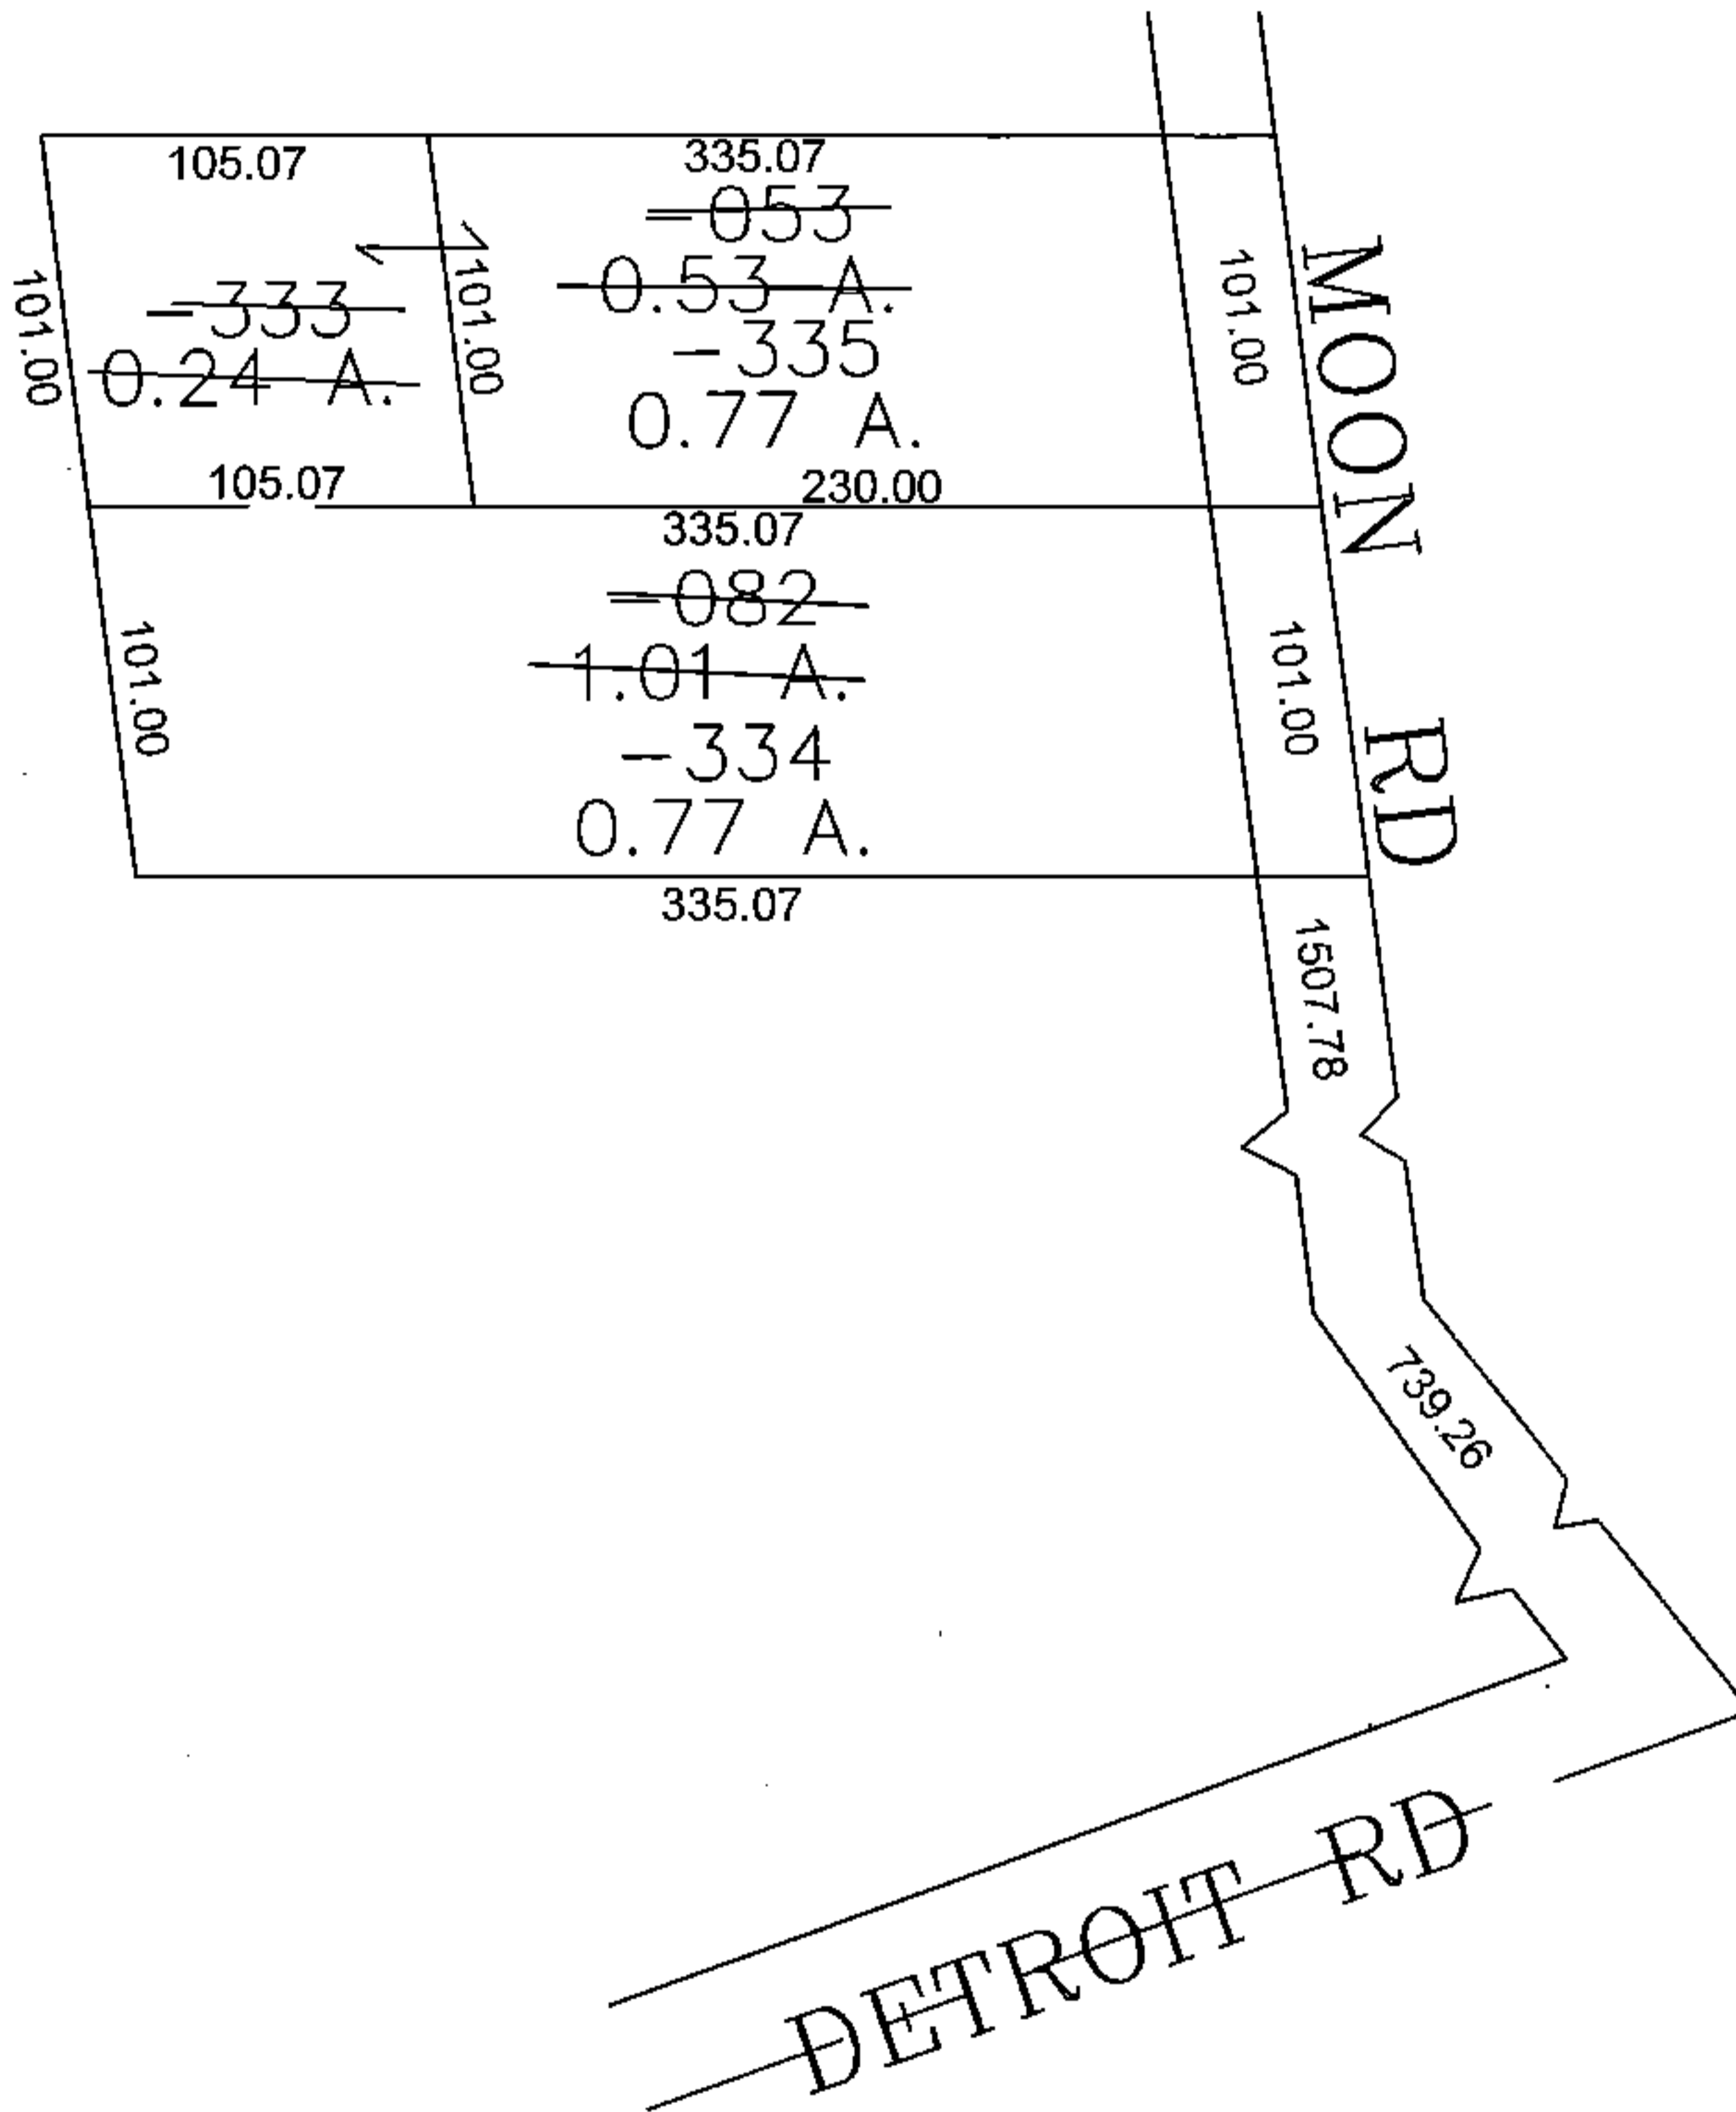


PARENT PARCEL: 04-00-002-101-082, -053

CHILD PARCEL: 04-00-002-101-333 THRU -335

STARTING POINT: CENTERLINE OF DETROIT RD & MOON RD

15-03415

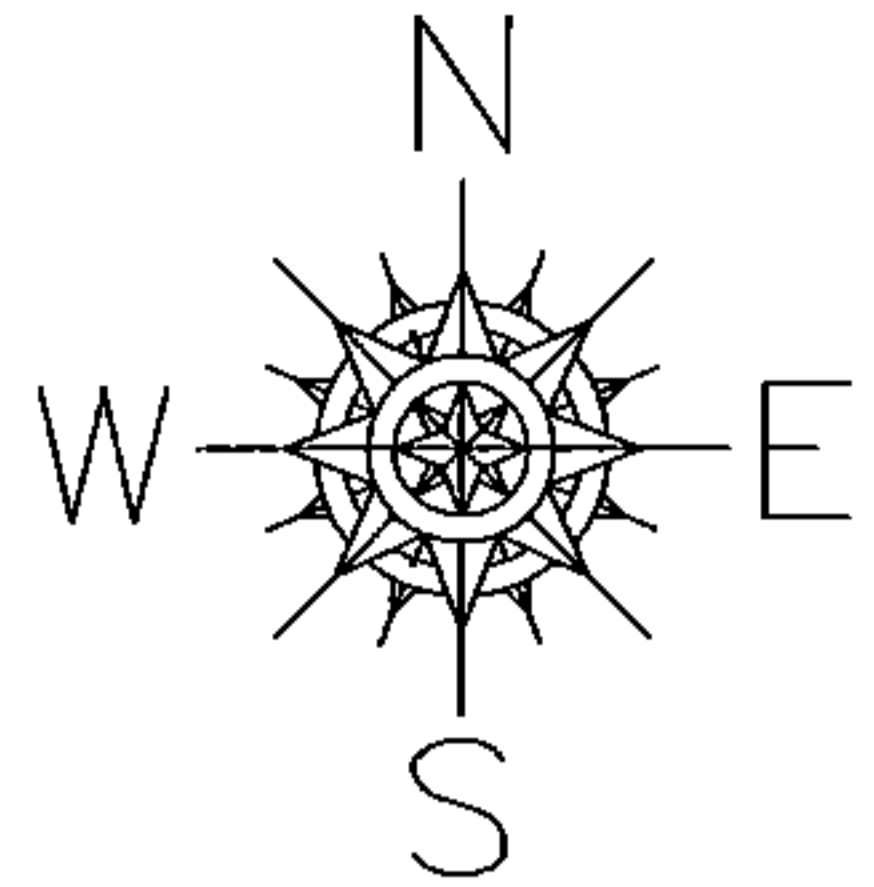

SPLITS/DEEDS PROCESSED

LORAIN COUNTY TAX MAP DEPARTMENT  
226 MIDDLE AVE. ELYRIA, OHIO

SURVEYED BY: JAMES RESAR

CLOSURE: 0.00 : 10,000

MAP PAGE(S): 04-00-002-A

APPROVED BY: JAH DATE: 8/27/2015

SCALE: 1" = 100 PRIOR INSTRUMENT: 20140502477