


PARENT PARCEL: ADD TO DUPLICATE

CHILD PARCEL: 11-00-009-900-001

STARTING POINT: PER PLAT VOL. 16 PG. 26 DROSD & RISMAN ALLOTMENT

16-03417-A

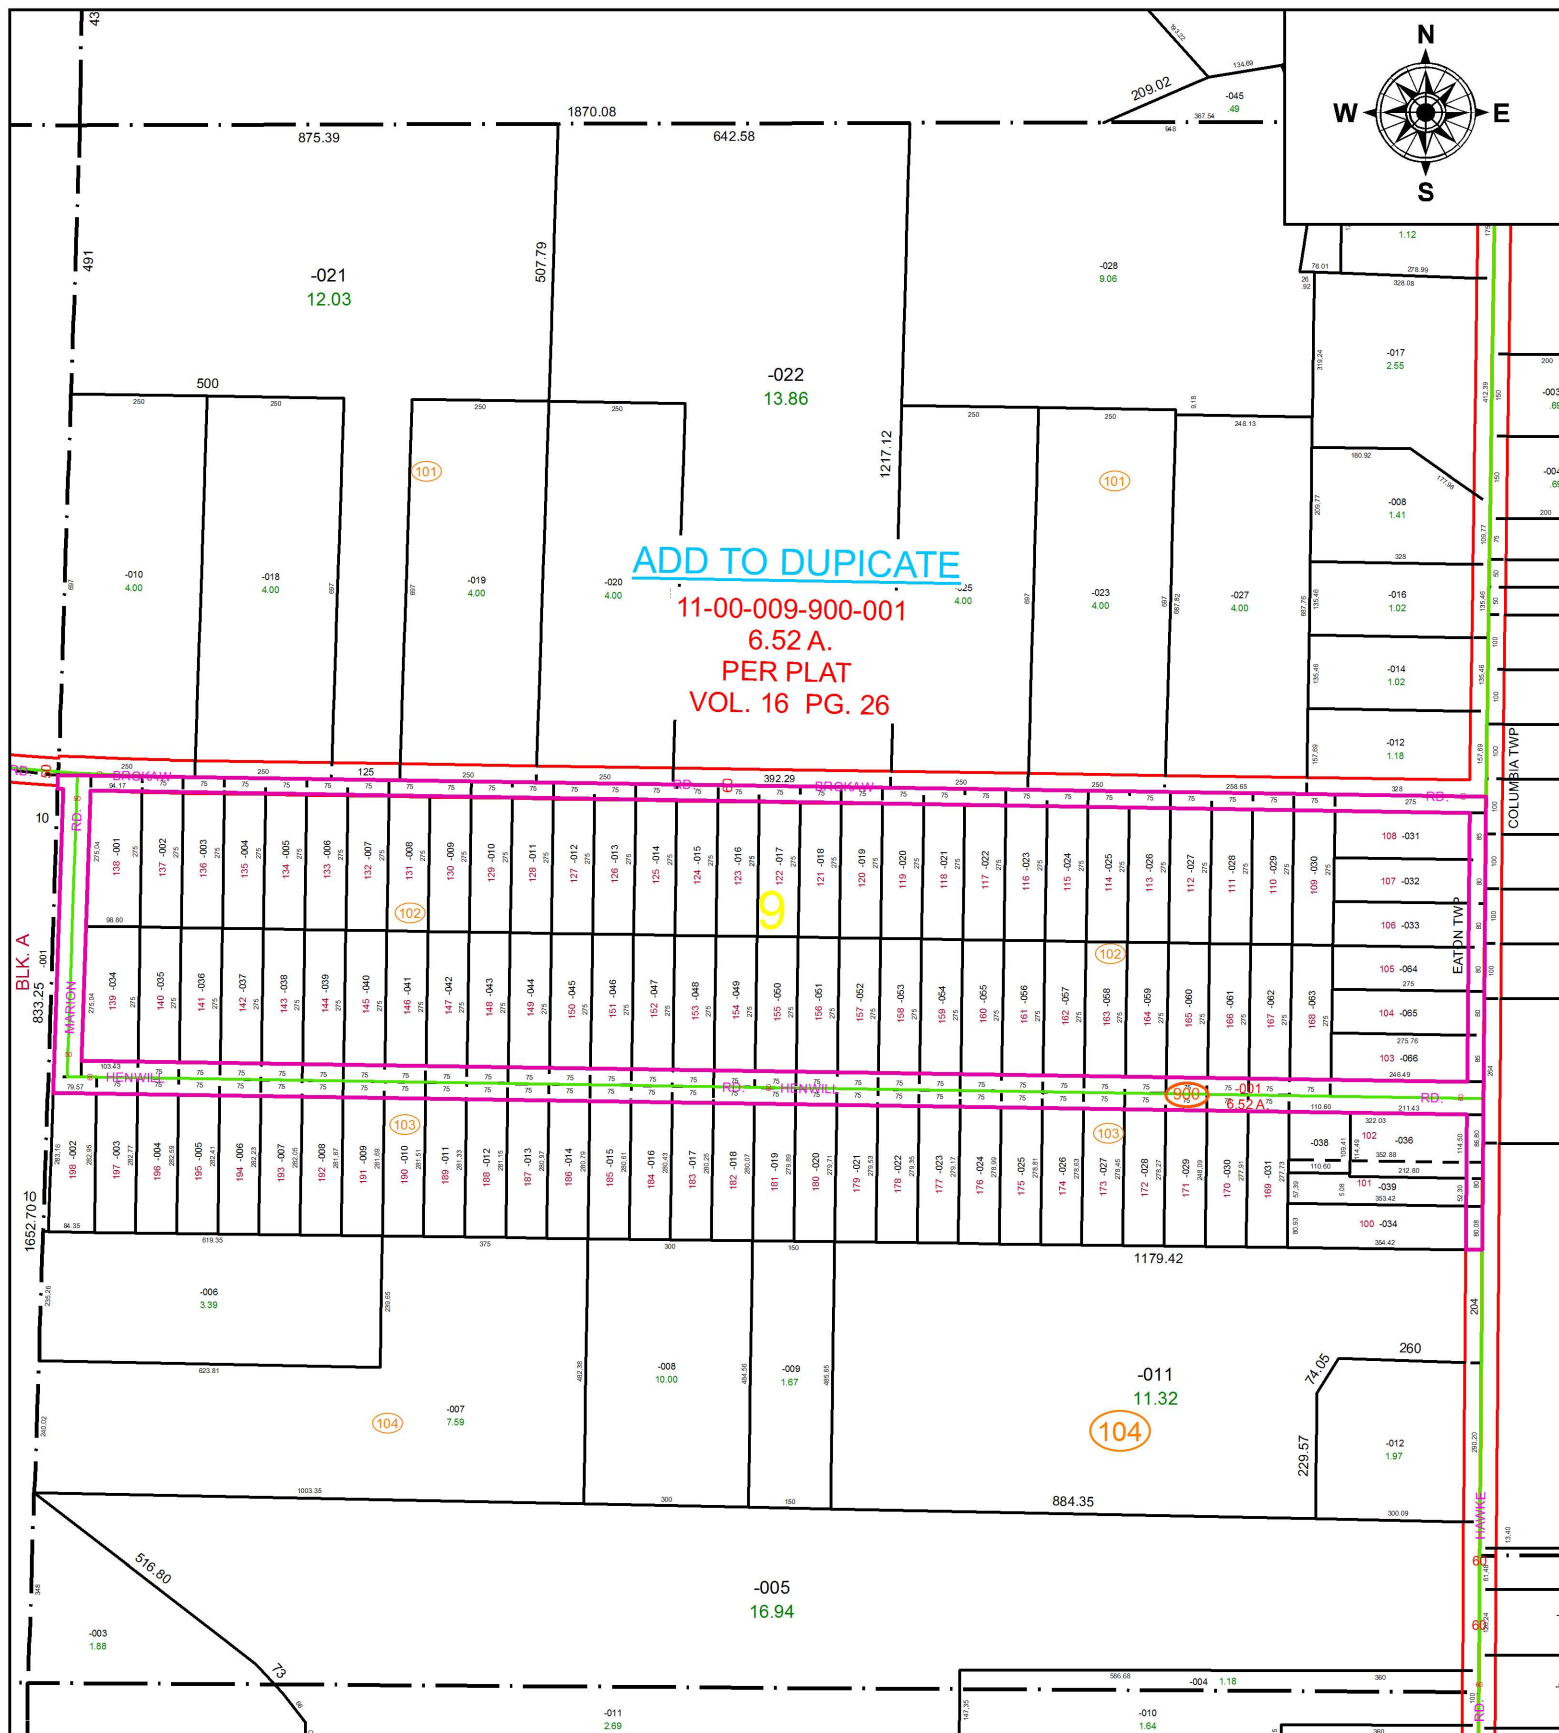

**ADD TO DUPLICATE**  
**11-00-009-900-001**  
**6.52 A.**  
**PER PLAT**  
**VOL. 16 PG. 26**



**SPLITS/DEEDS PROCESSED**  
 LORAIN COUNTY TAX MAP DEPARTMENT  
 226 MIDDLE AVE. ELYRIA, OH

SURVEYED BY: D.D. ANDRUS  
 CLOSURE: NA  
 MAP PAGE(S): 11-00-009  
 APPROVED BY: TJS DATE: 4/7/16  
 SCALE: 1" = 350 PRIOR INSTRUMENT: DV XXXX/XXXX