
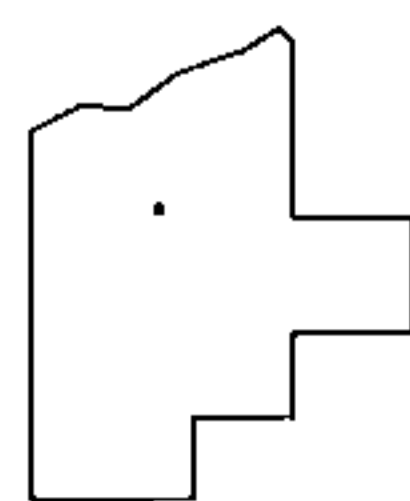
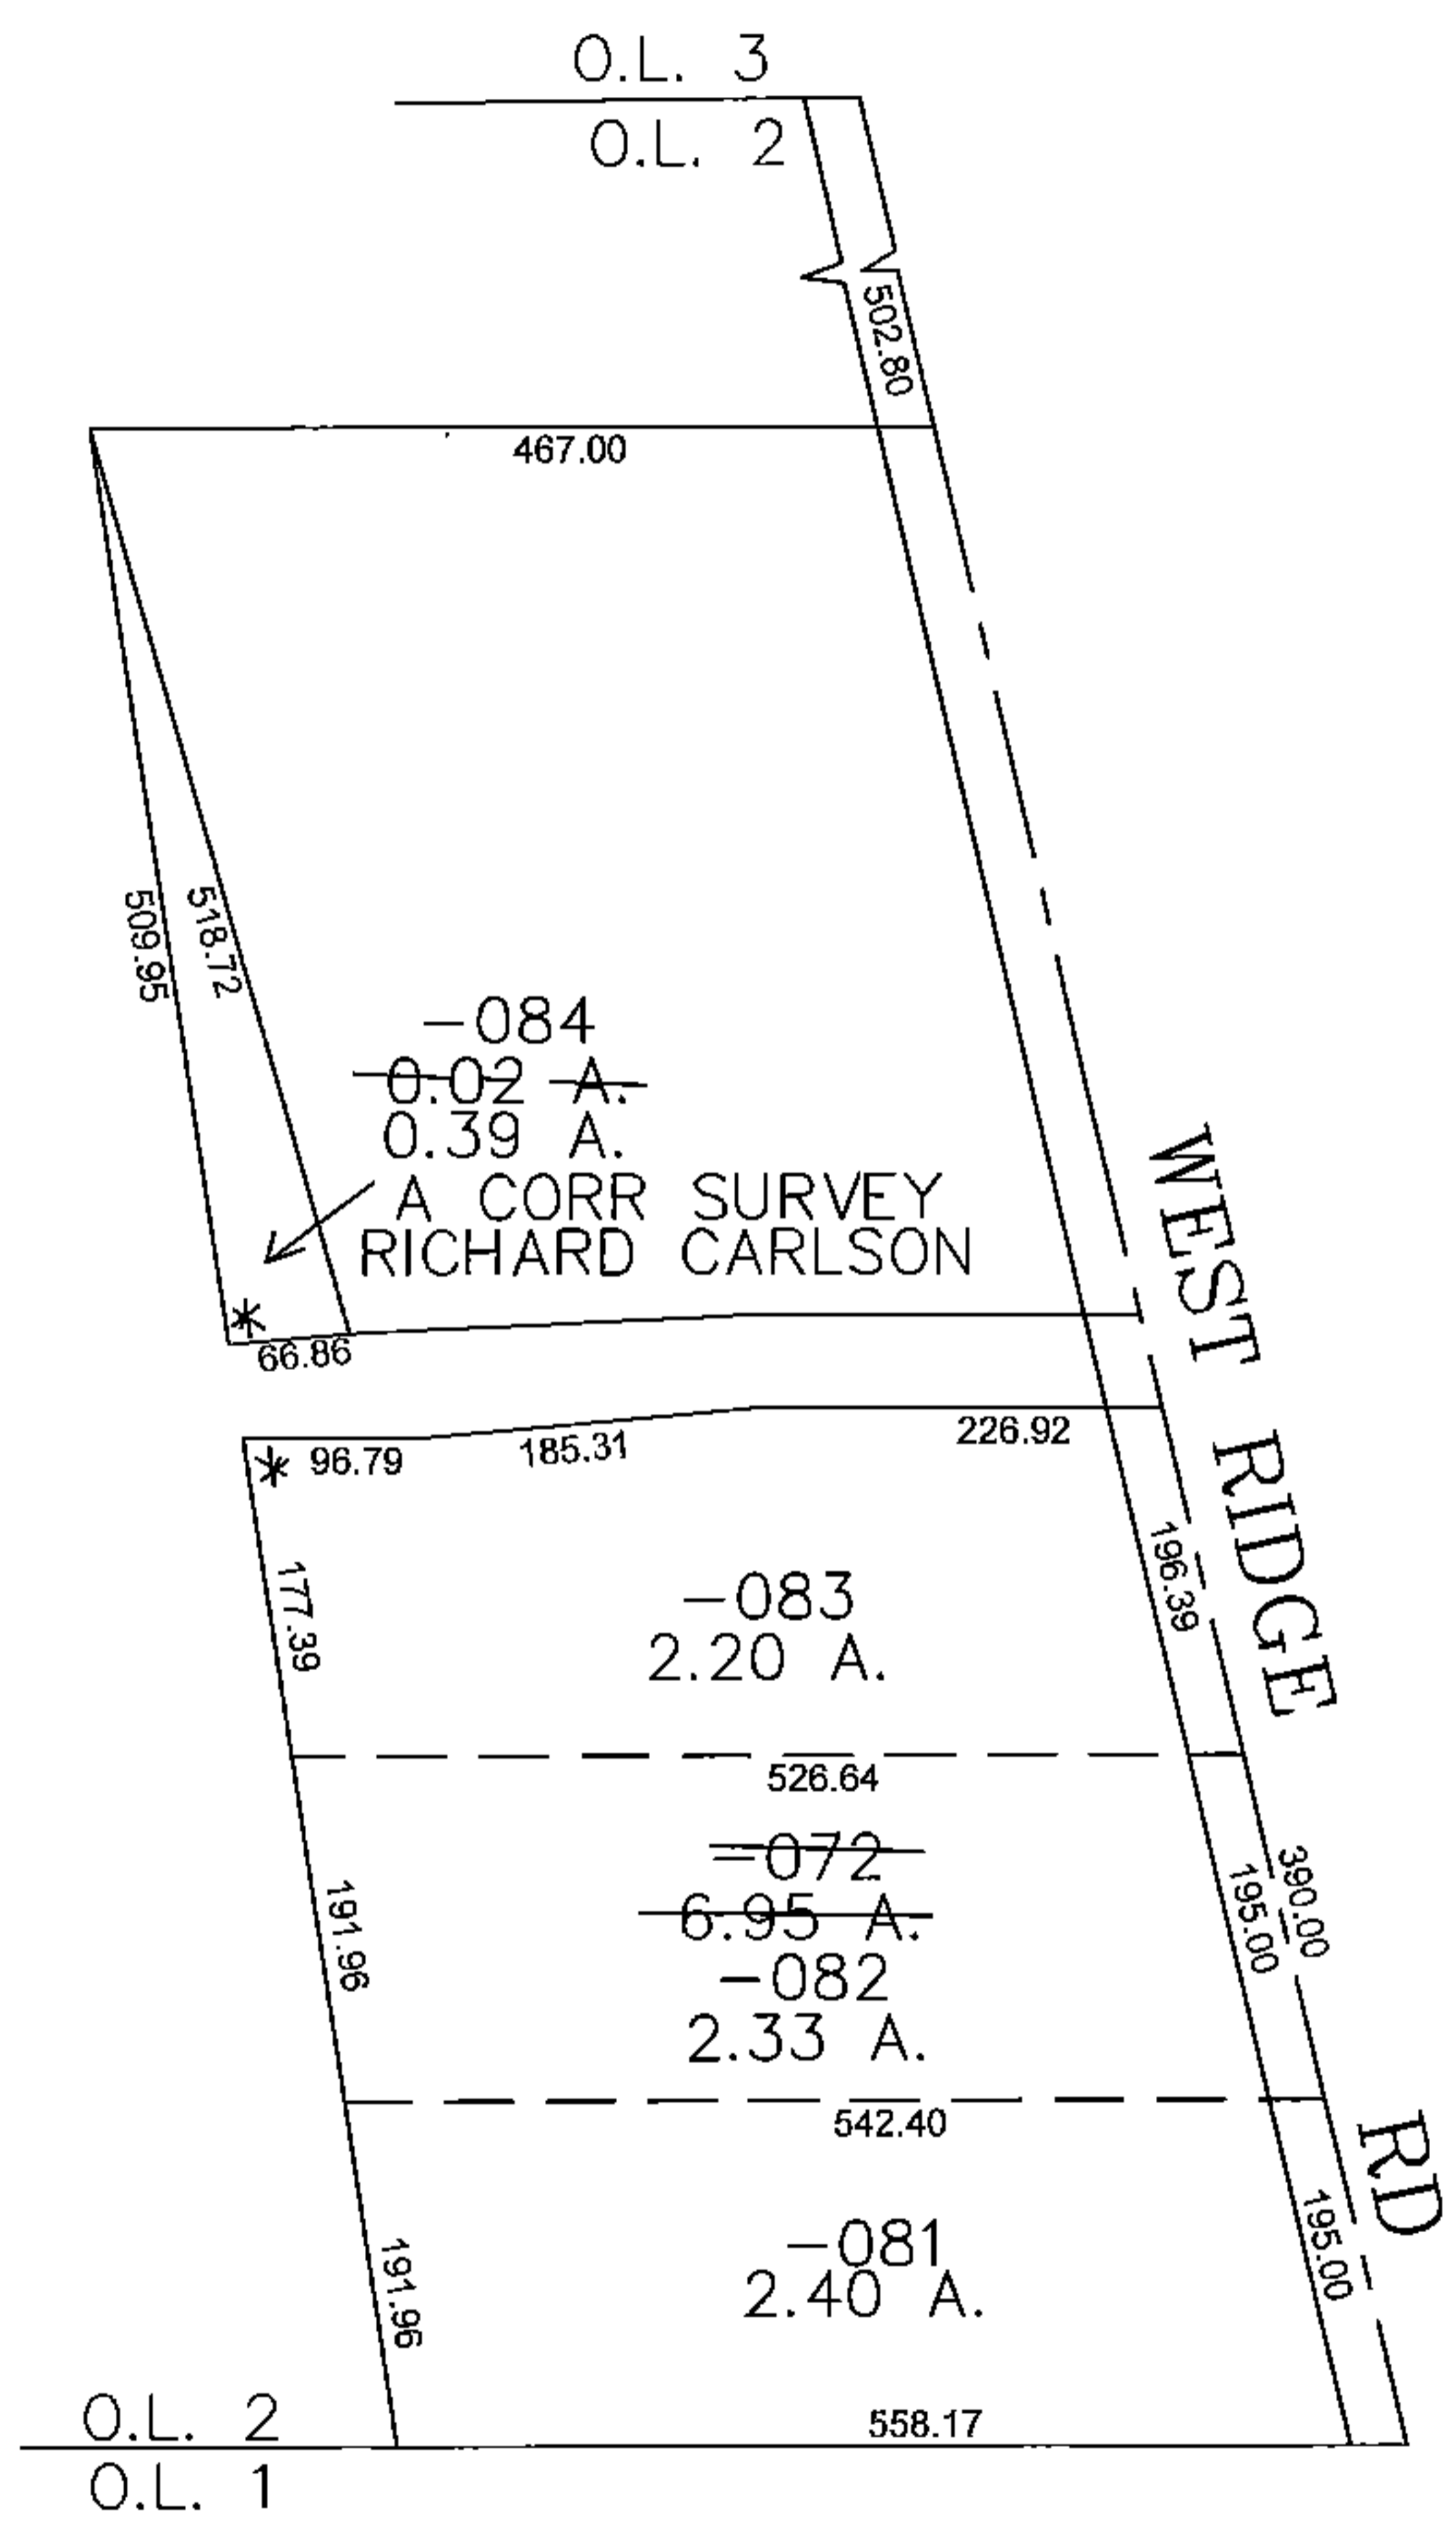


PARENT PARCEL: 06-24-002-000-072
 CHILD PARCEL: 06-24-002-000-081, -082, -083, -084
 STARTING POINT: CENTERLINE OF WEST RIDGE RD & O.L. 2

15-03420

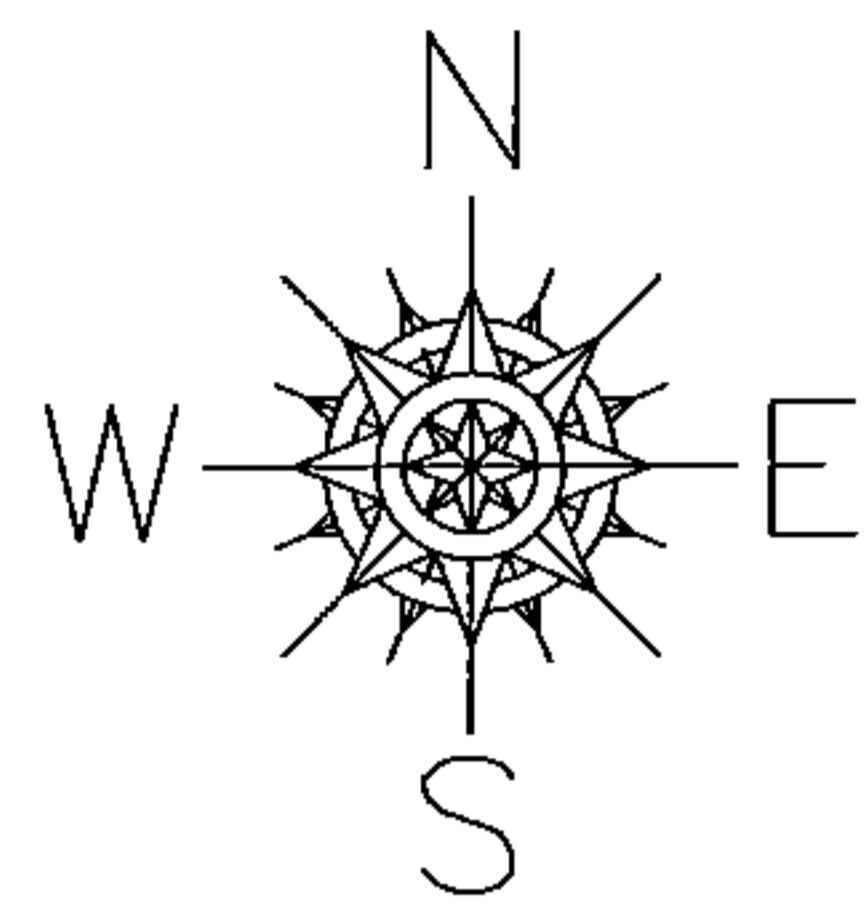

SPLITS/DEEDS PROCESSED
 LORAIN COUNTY TAX MAP DEPARTMENT
 226 MIDDLE AVE. ELYRIA, OHIO

SURVEYED BY: RICHARD CARLSON
 CLOSURE: 0.00 : 10.000
 MAP PAGE(S): 6-128
 APPROVED BY: JAH DATE: 9/11/2015
 SCALE: 1" = 200 PRIOR INSTRUMENT: 20080247530