


PARENT PARCEL: 02-01-003-244-023

CHILD PARCEL: XX-XX-XXX-XXX-XXX

STARTING POINT: S/L'S 513 AND 514 IN ALTERED PLAT OF LORAIN STONE CO.'S 2ND SUB.

16-03421-C

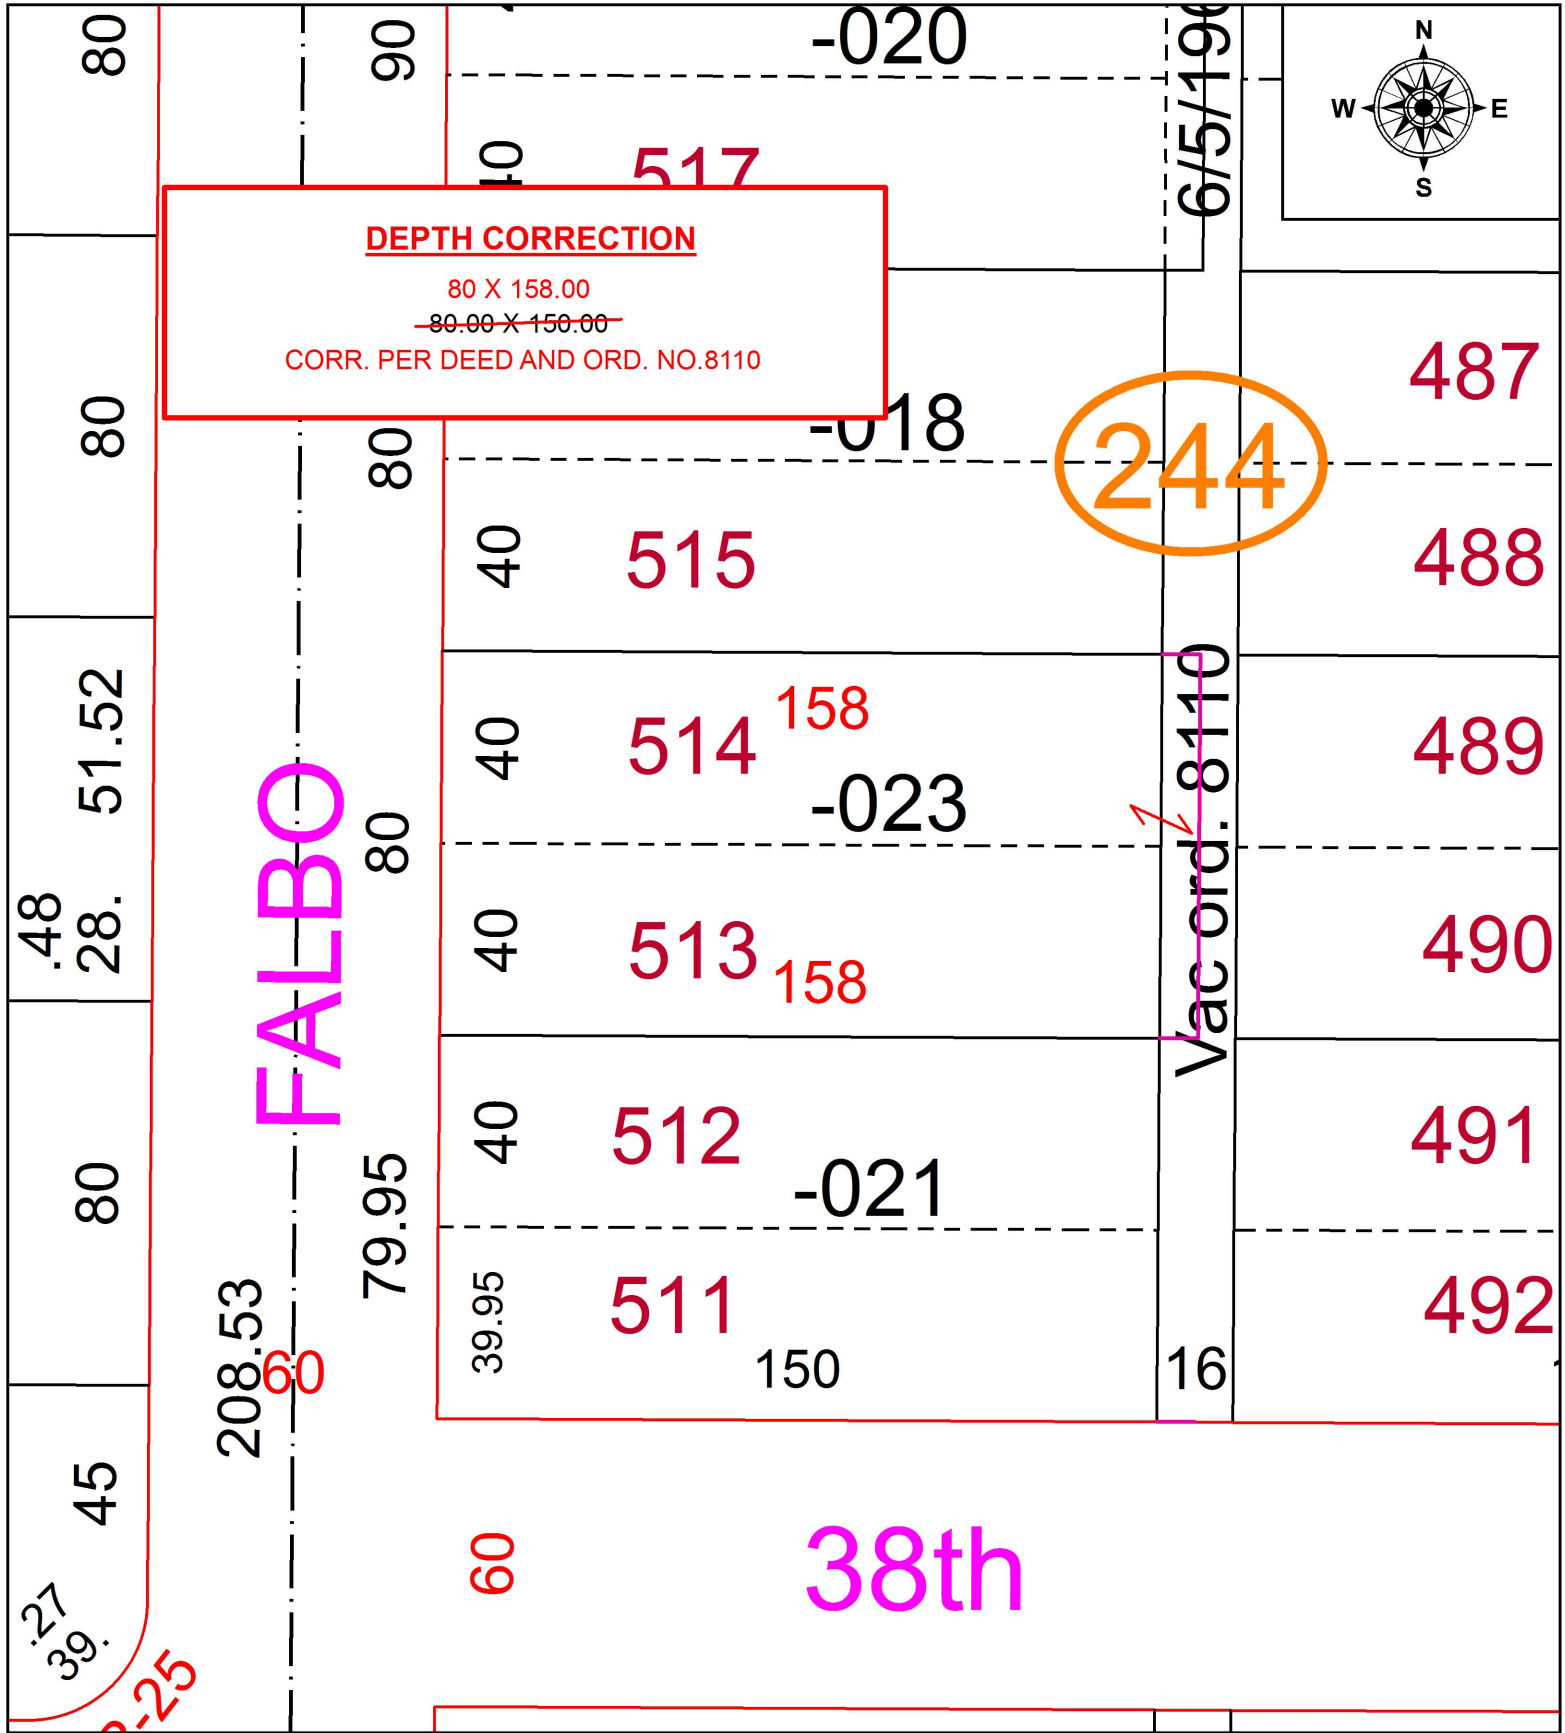

**SPLITS/DEEDS PROCESSED**  
 LORAIN COUNTY TAX MAP DEPARTMENT  
 226 MIDDLE AVE. ELYRIA, OH

SURVEYED BY: \_\_\_\_\_ N/A  
 CLOSURE: \_\_\_\_\_ N/A  
 MAP PAGE(S): \_\_\_\_\_ 2-01-003  
 APPROVED BY: \_\_\_\_\_ RRM DATE: \_\_\_\_\_ 4-12-16  
 SCALE: \_\_\_\_\_ 1" = 40' PRIOR INSTRUMENT: \_\_\_\_\_ OR 371/266