
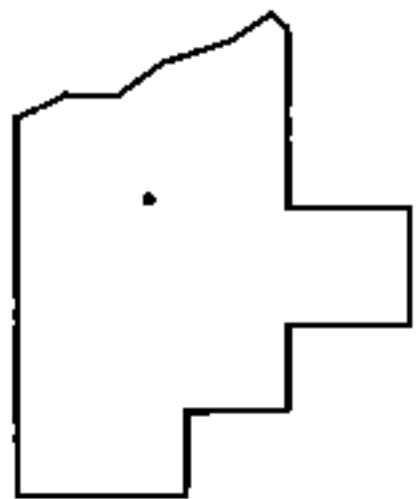
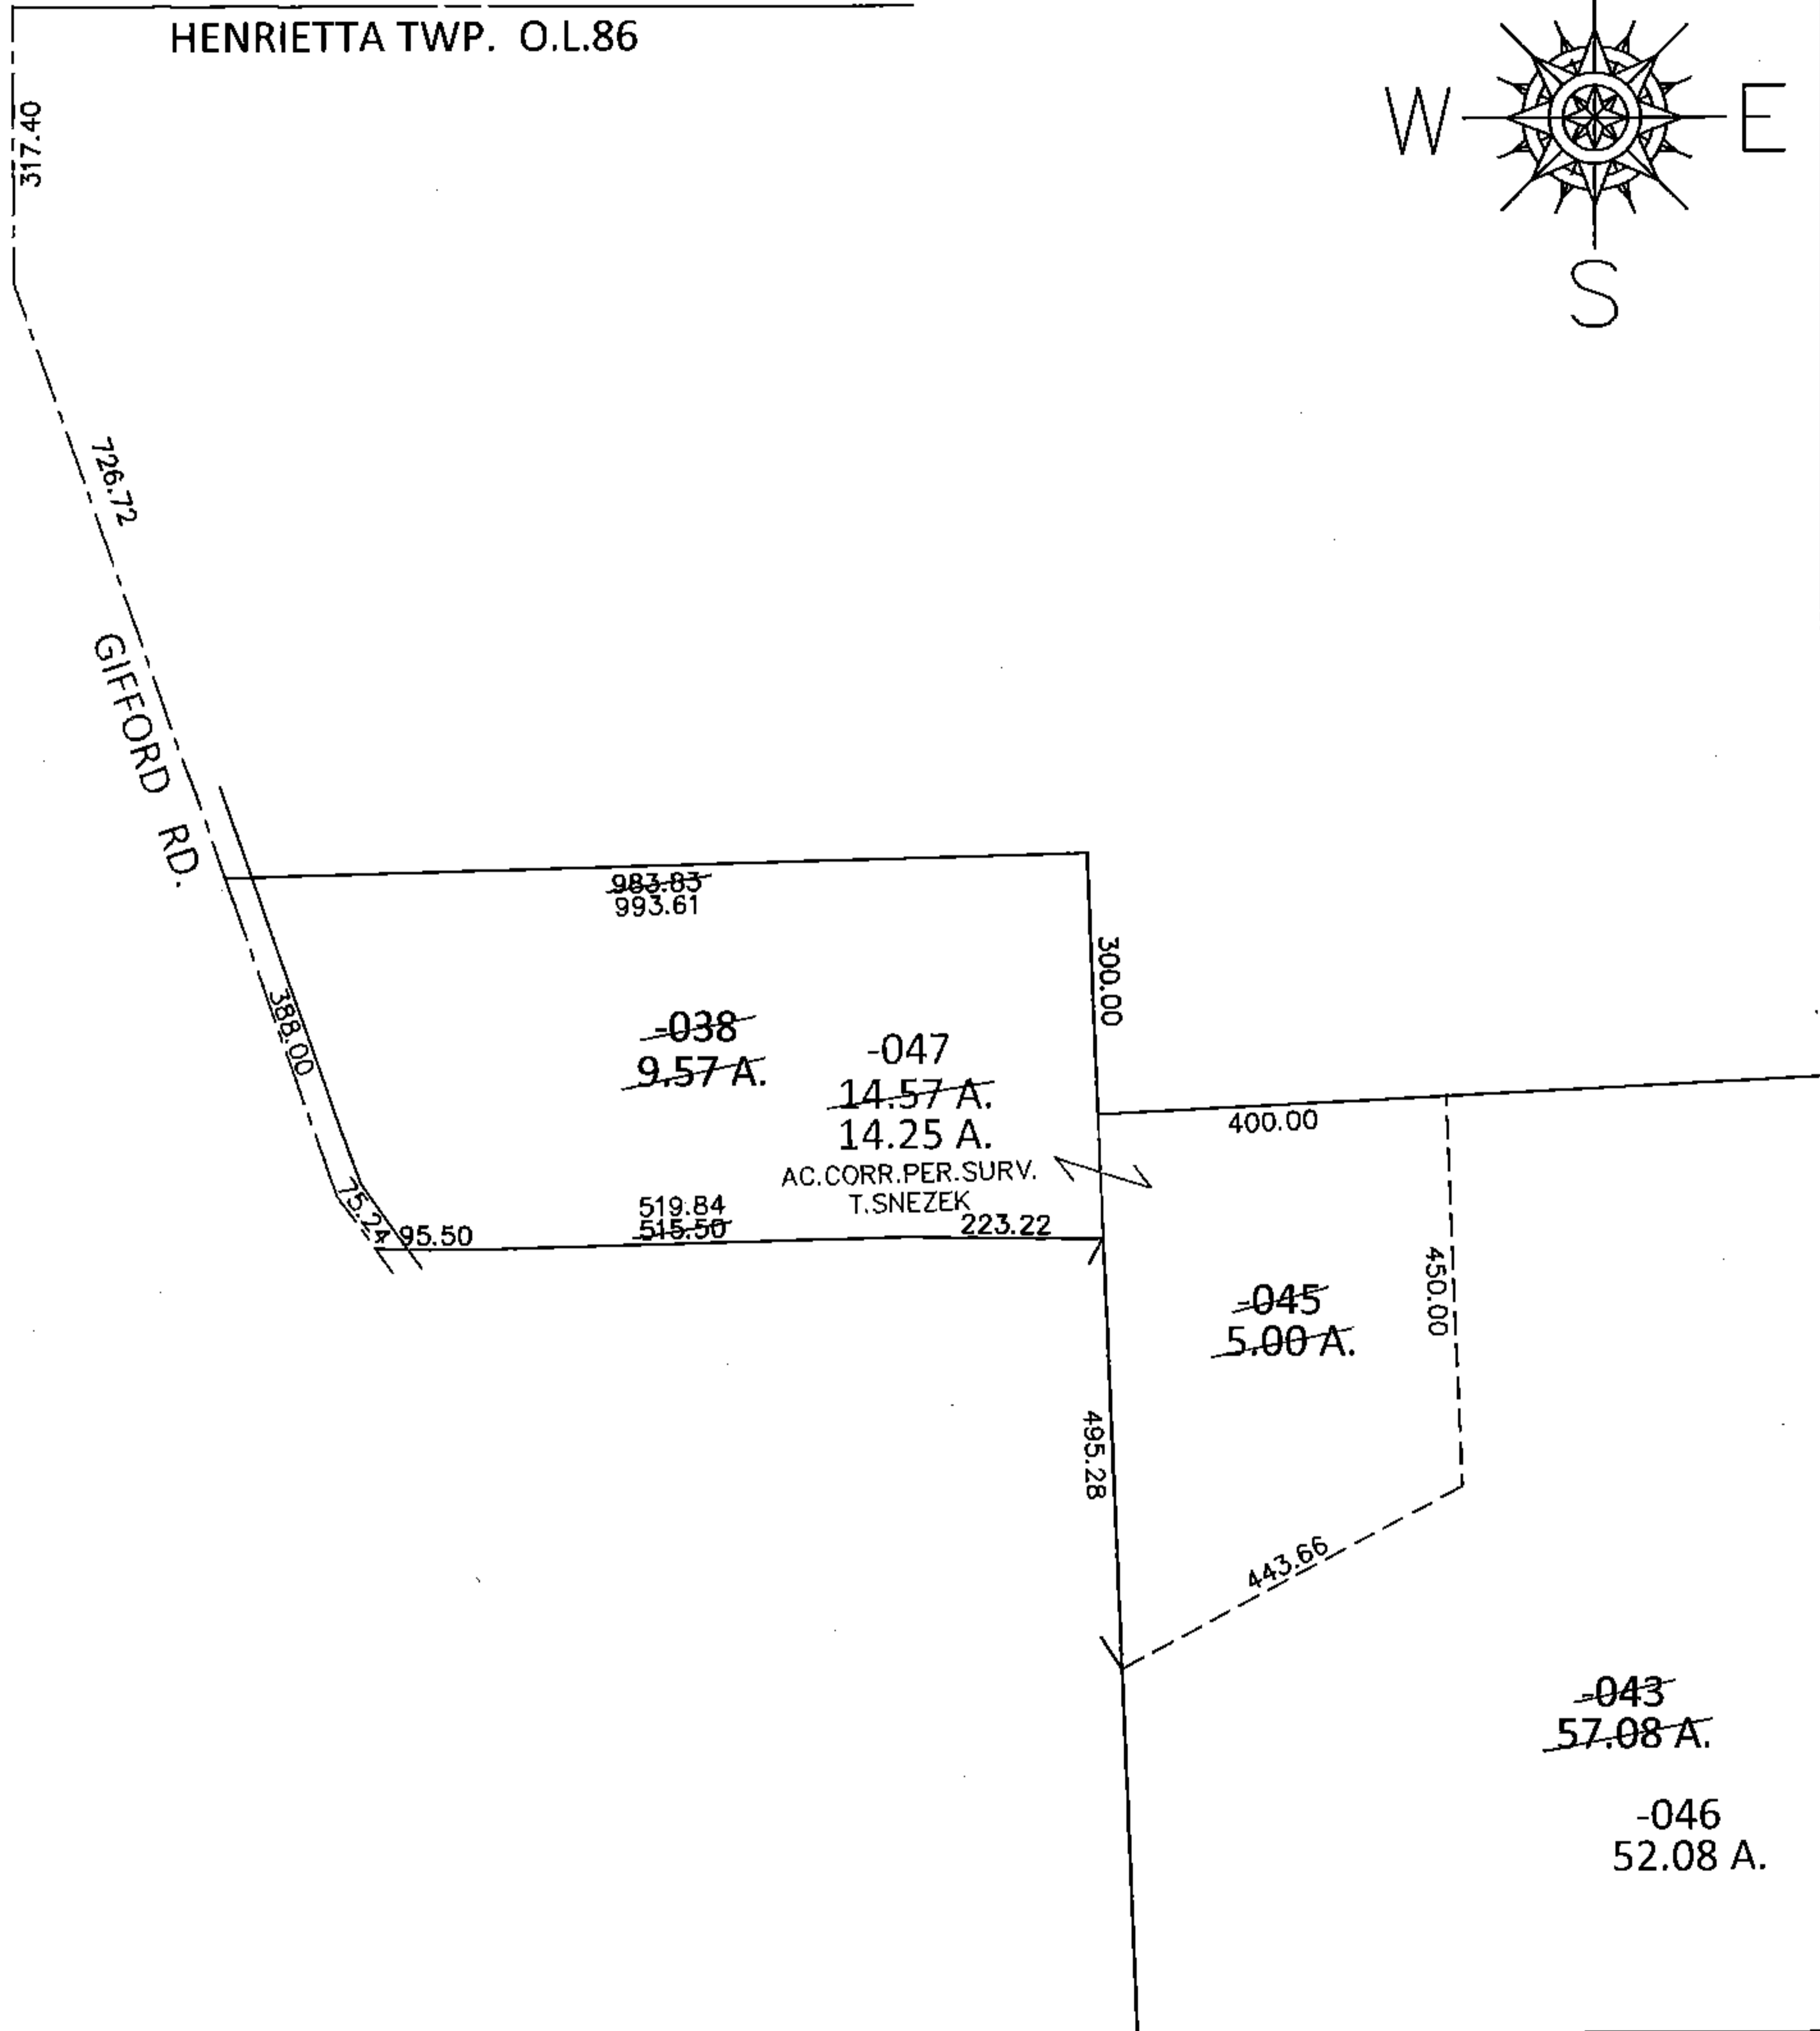


PARENT PARCEL: 08-00-086-000-038, 043
CHILD PARCEL: 08-00-086-000-045 THRU -047
STARTING POINT: INTERSECTION OF NORTH LINE OF O.L.86 AND C/L OF GIFFORD RD.

15-03422

BROWNHELM TWP. O.L.75
HENRIETTA TWP. O.L.86

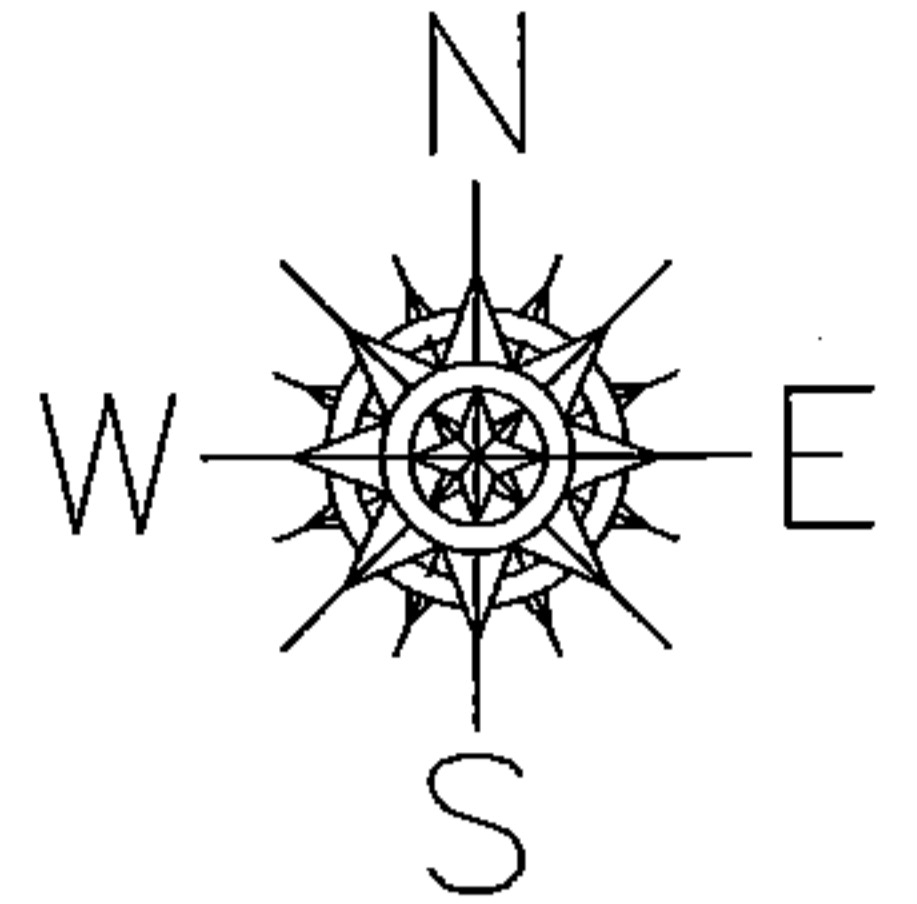

SPLITS/DEEDS PROCESSED

LORAIN COUNTY TAX MAP DEPARTMENT
226 MIDDLE AVE. ELYRIA, OHIO

SURVEYED BY: THOMAS M. SNEZEK
CLOSURE: .01:10,000
MAP PAGE(S): 8-C
APPROVED BY: RRM DATE: 10-1-15
SCALE: 1"= 300 PRIOR INST.: 20090301260