


PARENT PARCEL: 05-00-023-117-008

CHILD PARCEL: 05-00-023-117-021, -022

STARTING POINT: NORTHEAST CORNER OF S/L 78

16-03423-U

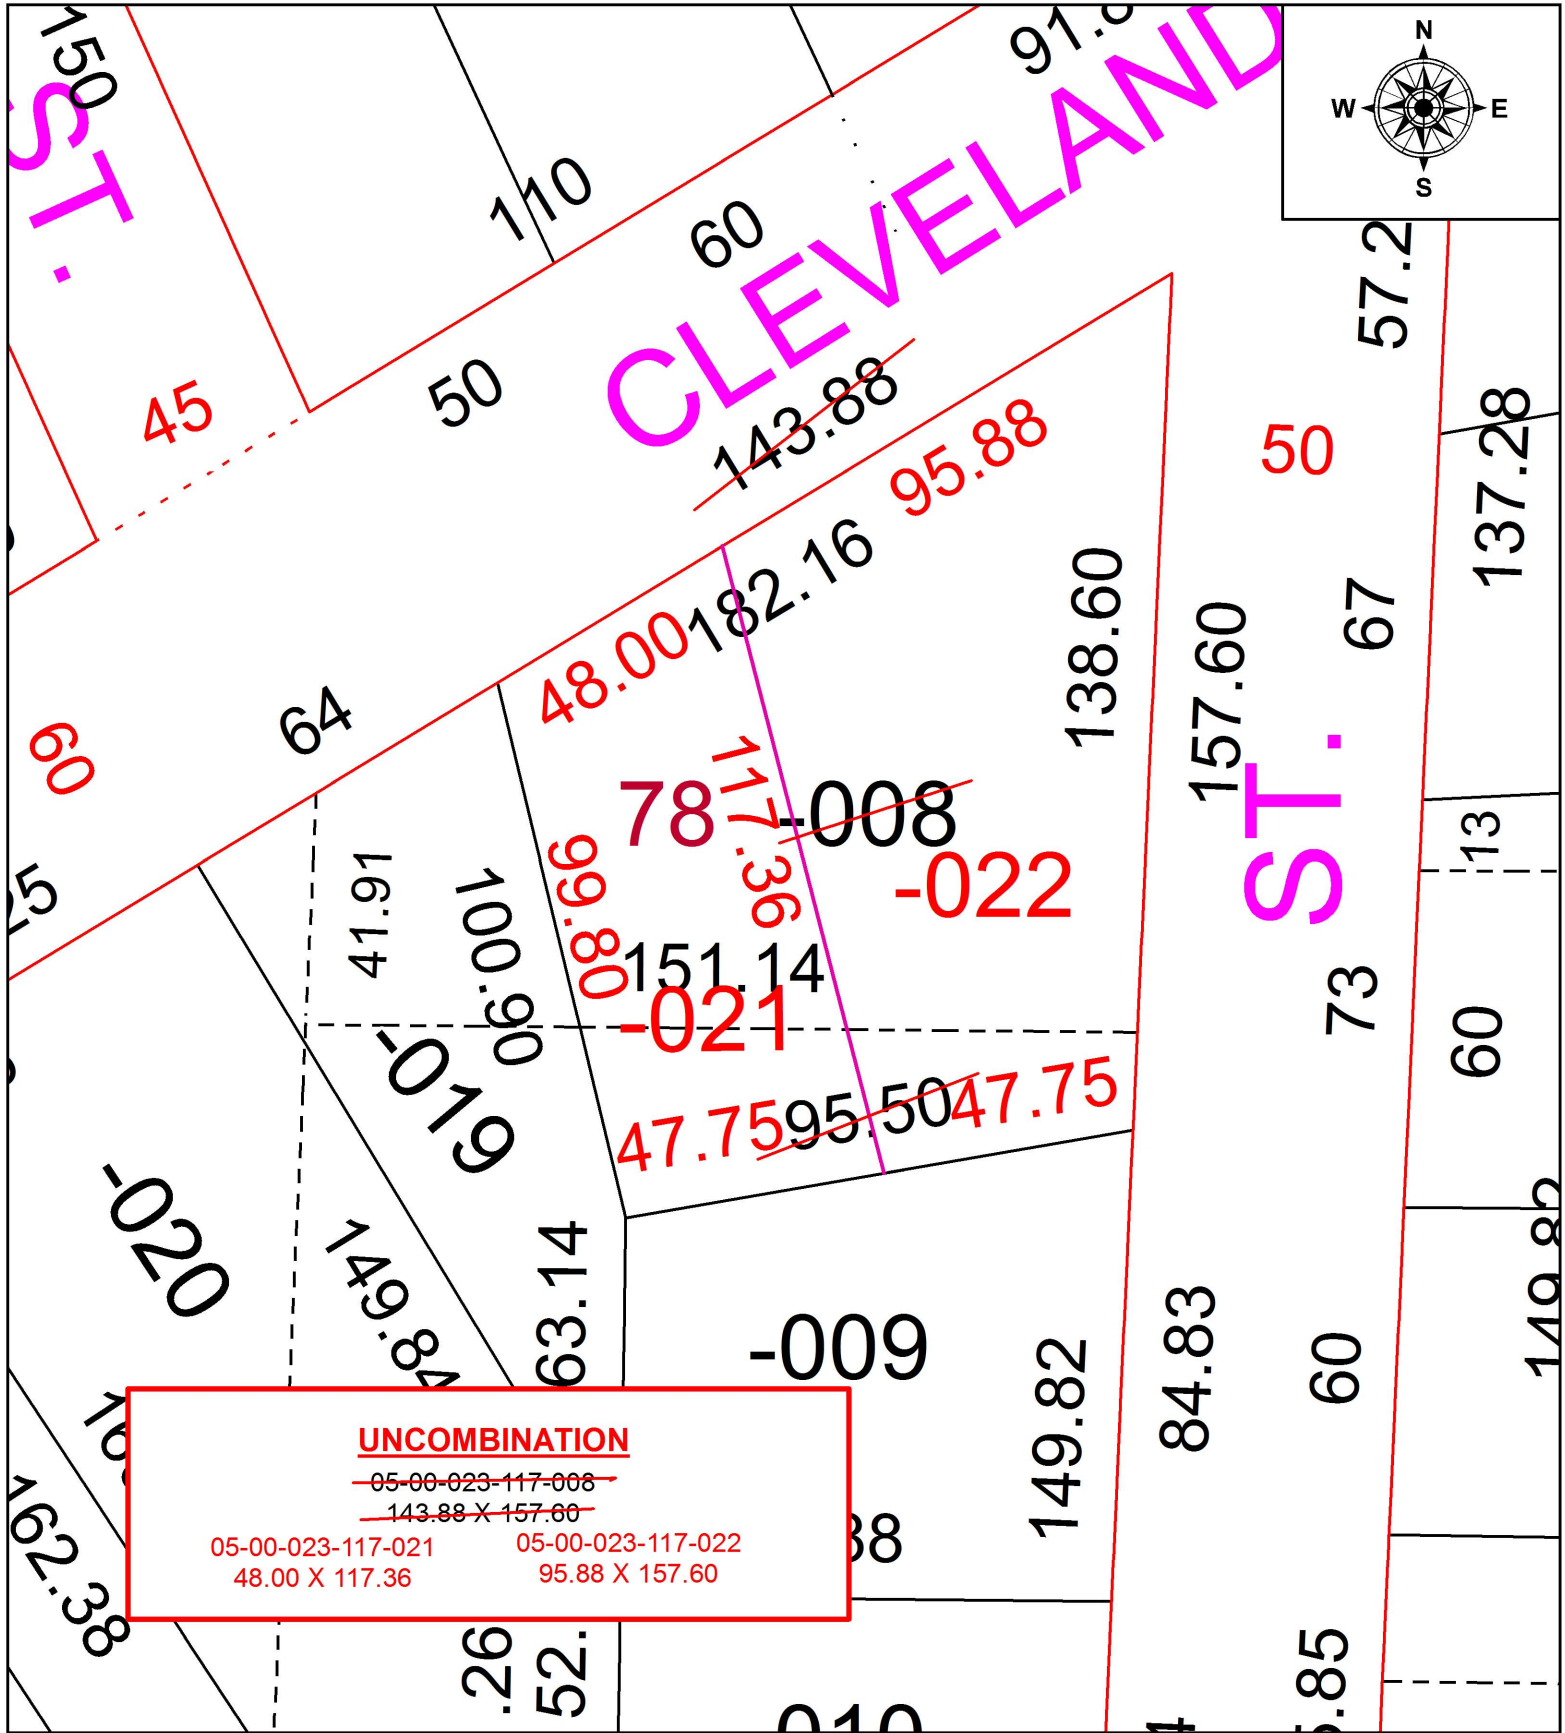


UNCOMBINATION

~~05-00-023-117-008~~

~~143.88 X 157.60~~

05-00-023-117-021
48.00 X 117.36

05-00-023-117-022
95.88 X 157.60

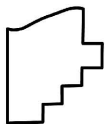

SPLITS/DEEDS PROCESSED

LORAIN COUNTY TAX MAP DEPARTMENT
226 MIDDLE AVE. ELYRIA, OH

SURVEYED BY: N/A

CLOSURE: N/A

MAP PAGE(S): 5-00-023

APPROVED BY: RRM DATE: 2-25-16

SCALE: 1" = 35' PRIOR INSTRUMENT: 20150557334