
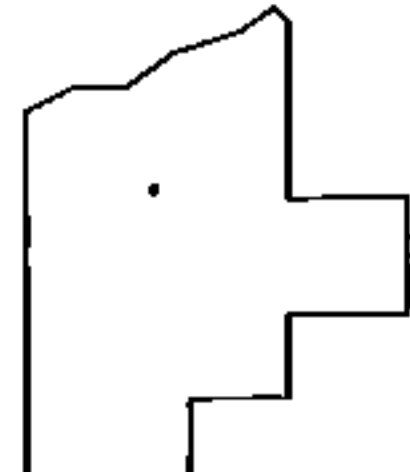
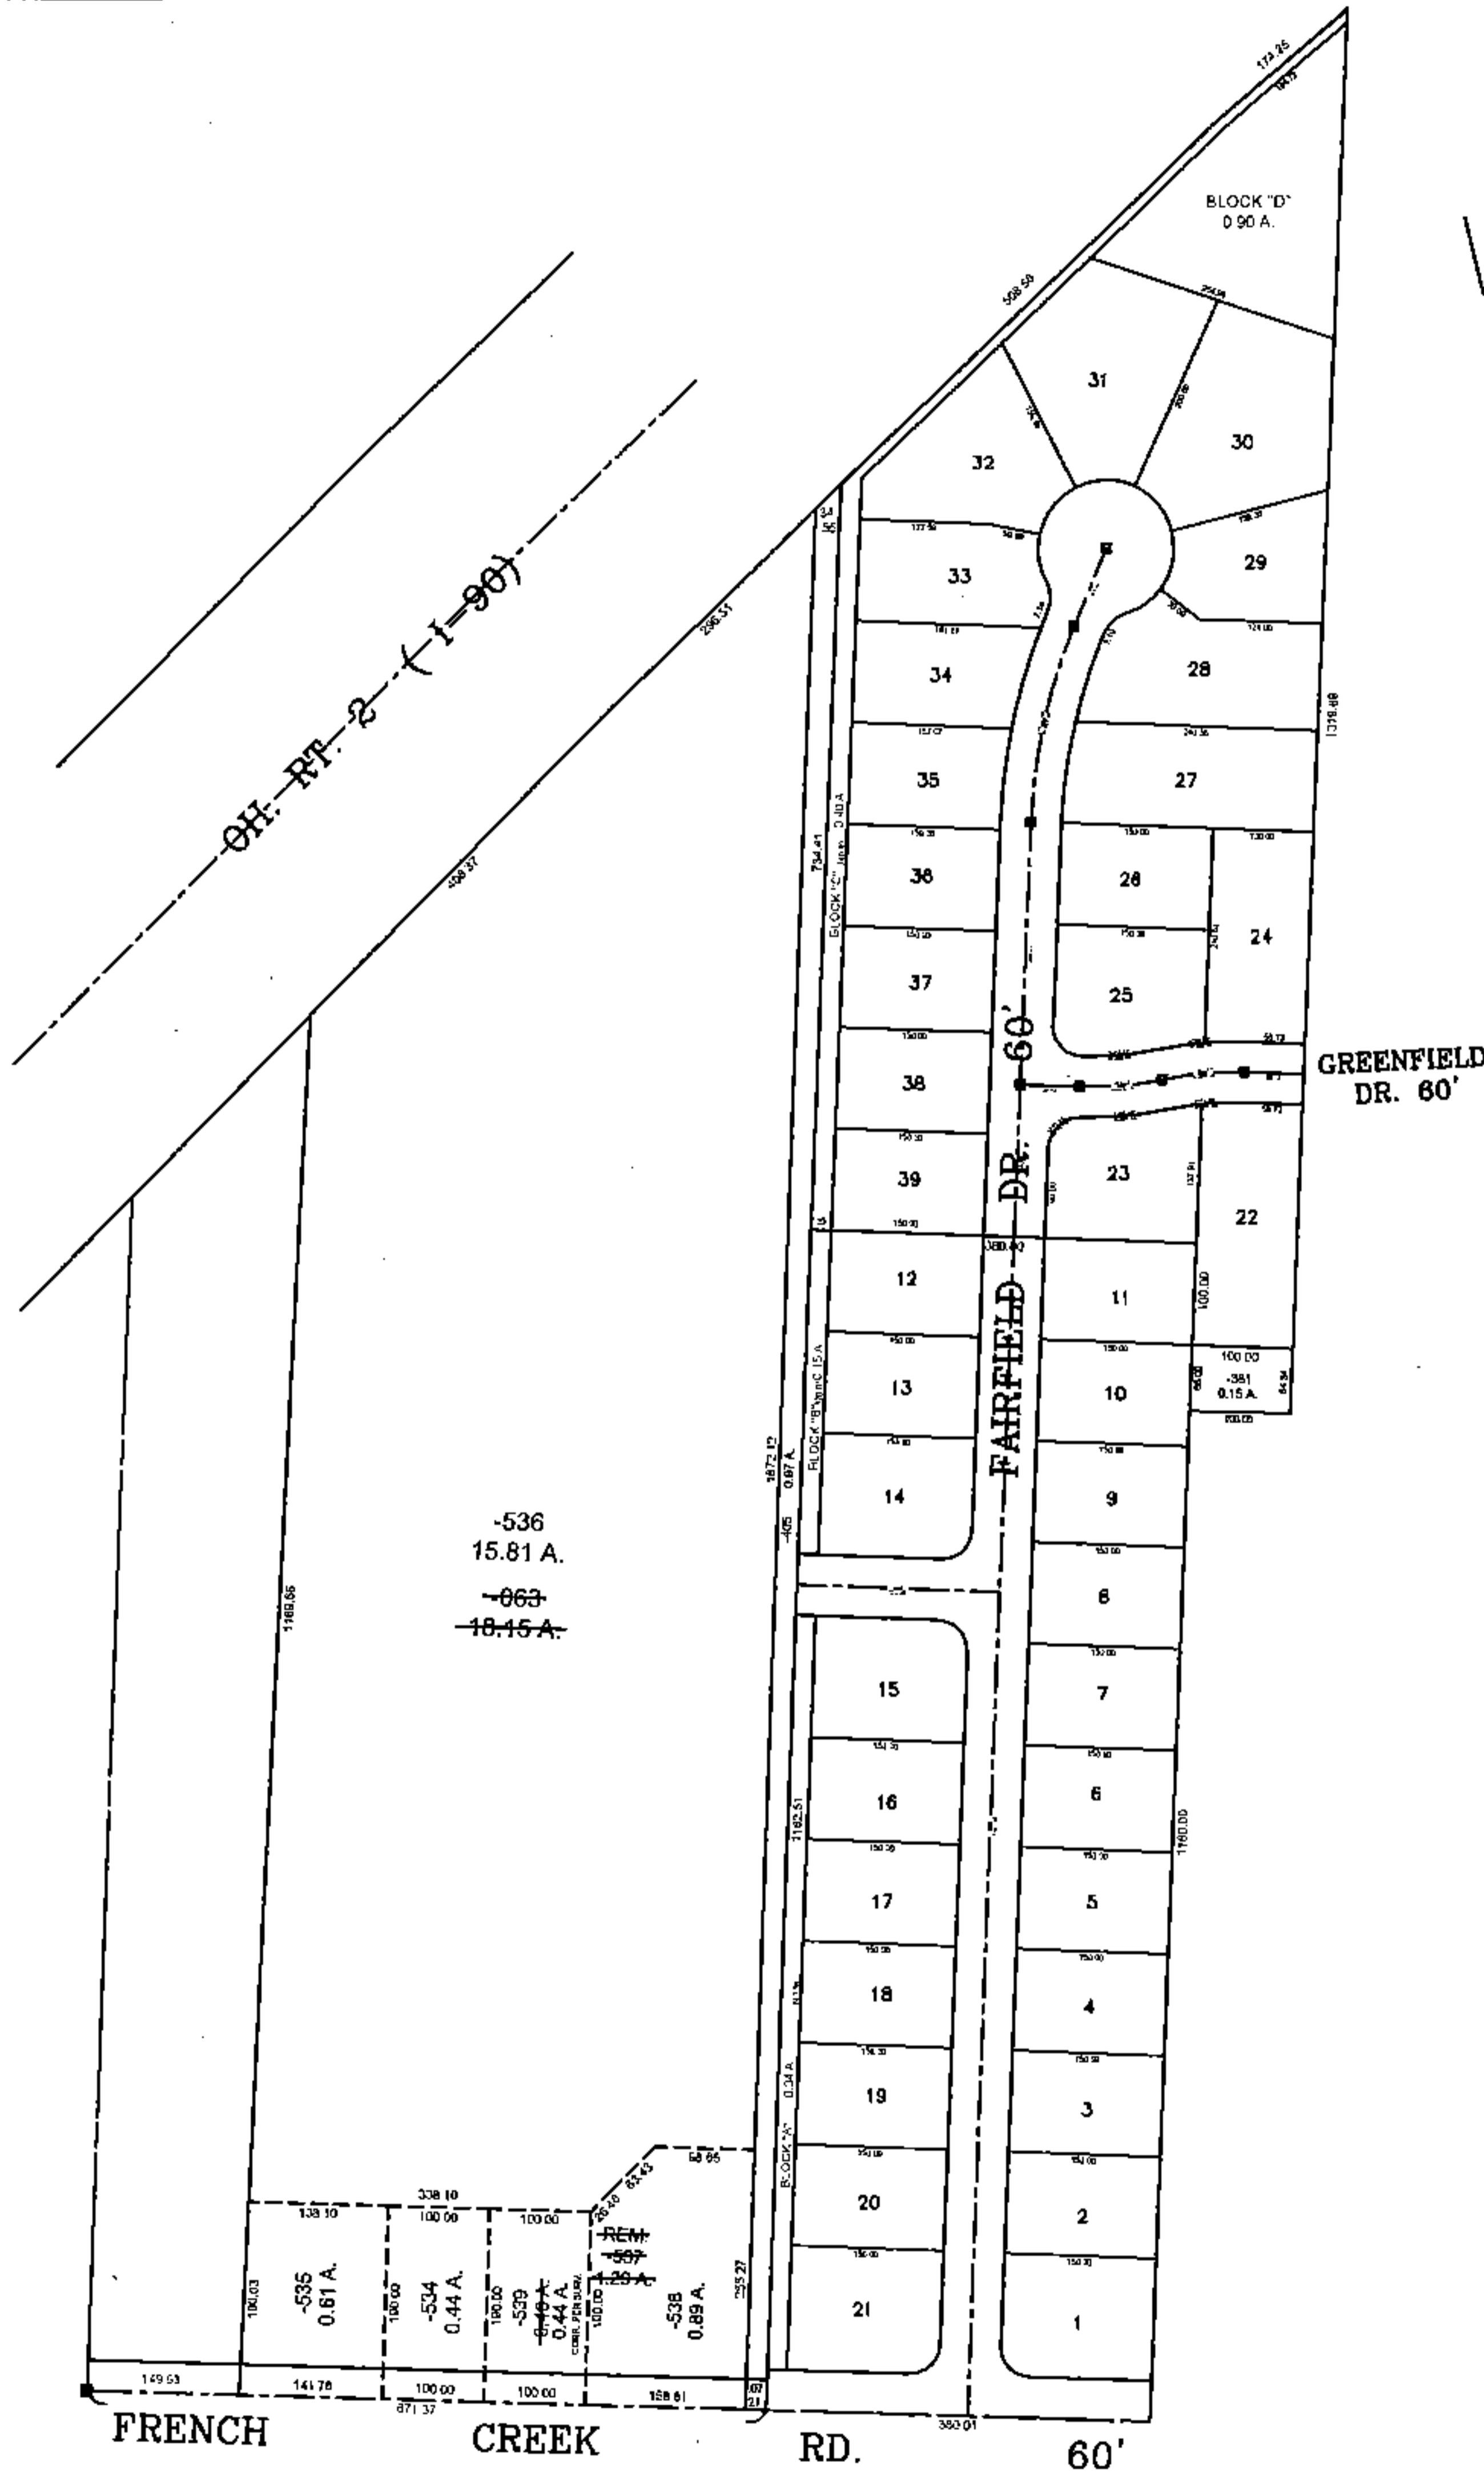


PARENT PARCEL: 04-00-003-101-063  
 CHILD PARCEL: 04-00-003-101-534 THRU -539  
 STARTING POINT: I.P. MON. BOX, CL OF FRENCH CREEK RD. & CL OF FAIRFIELD DR.

15-03424

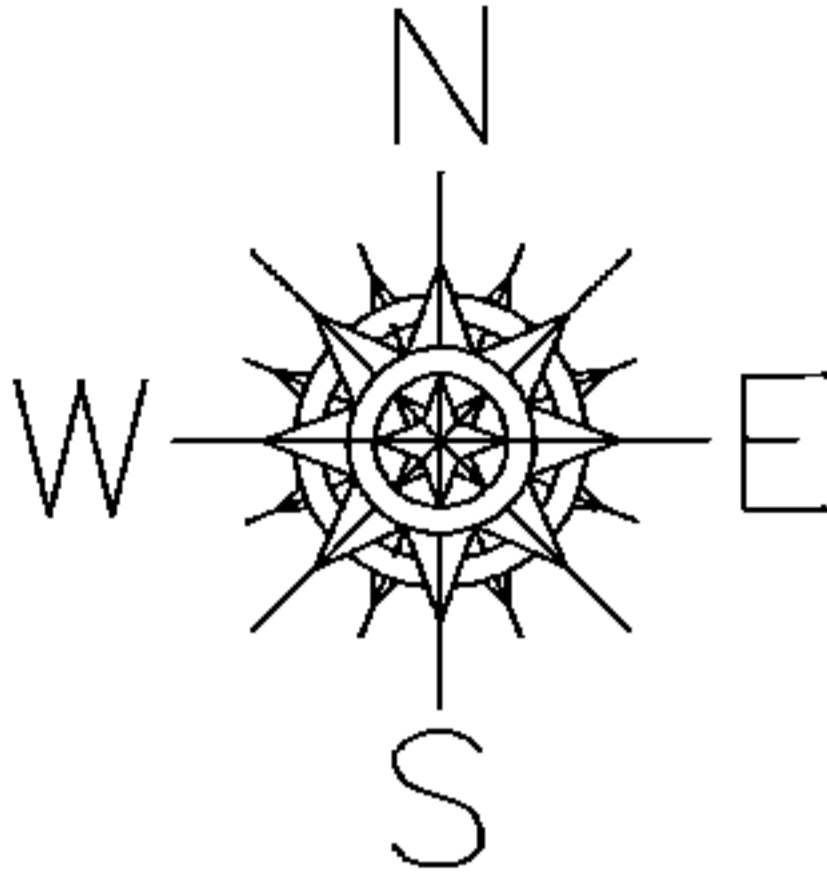

**SPLITS/DEEDS PROCESSED**  
 LORAIN COUNTY TAX MAP DEPARTMENT  
 226 MIDDLE AVE. ELYRIA, OHIO

SURVEYED BY: MICHAEL SPELACY  
 CLOSURE: 0.01 : 10.000  
 MAP PAGE(S): 04-00-003  
 APPROVED BY: TJS DATE: 9/18/15  
 SCALE: 1" = 300 PRIOR INSTRUMENT: 2014-0499611