
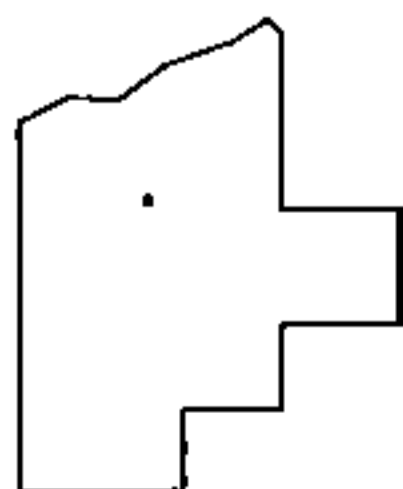
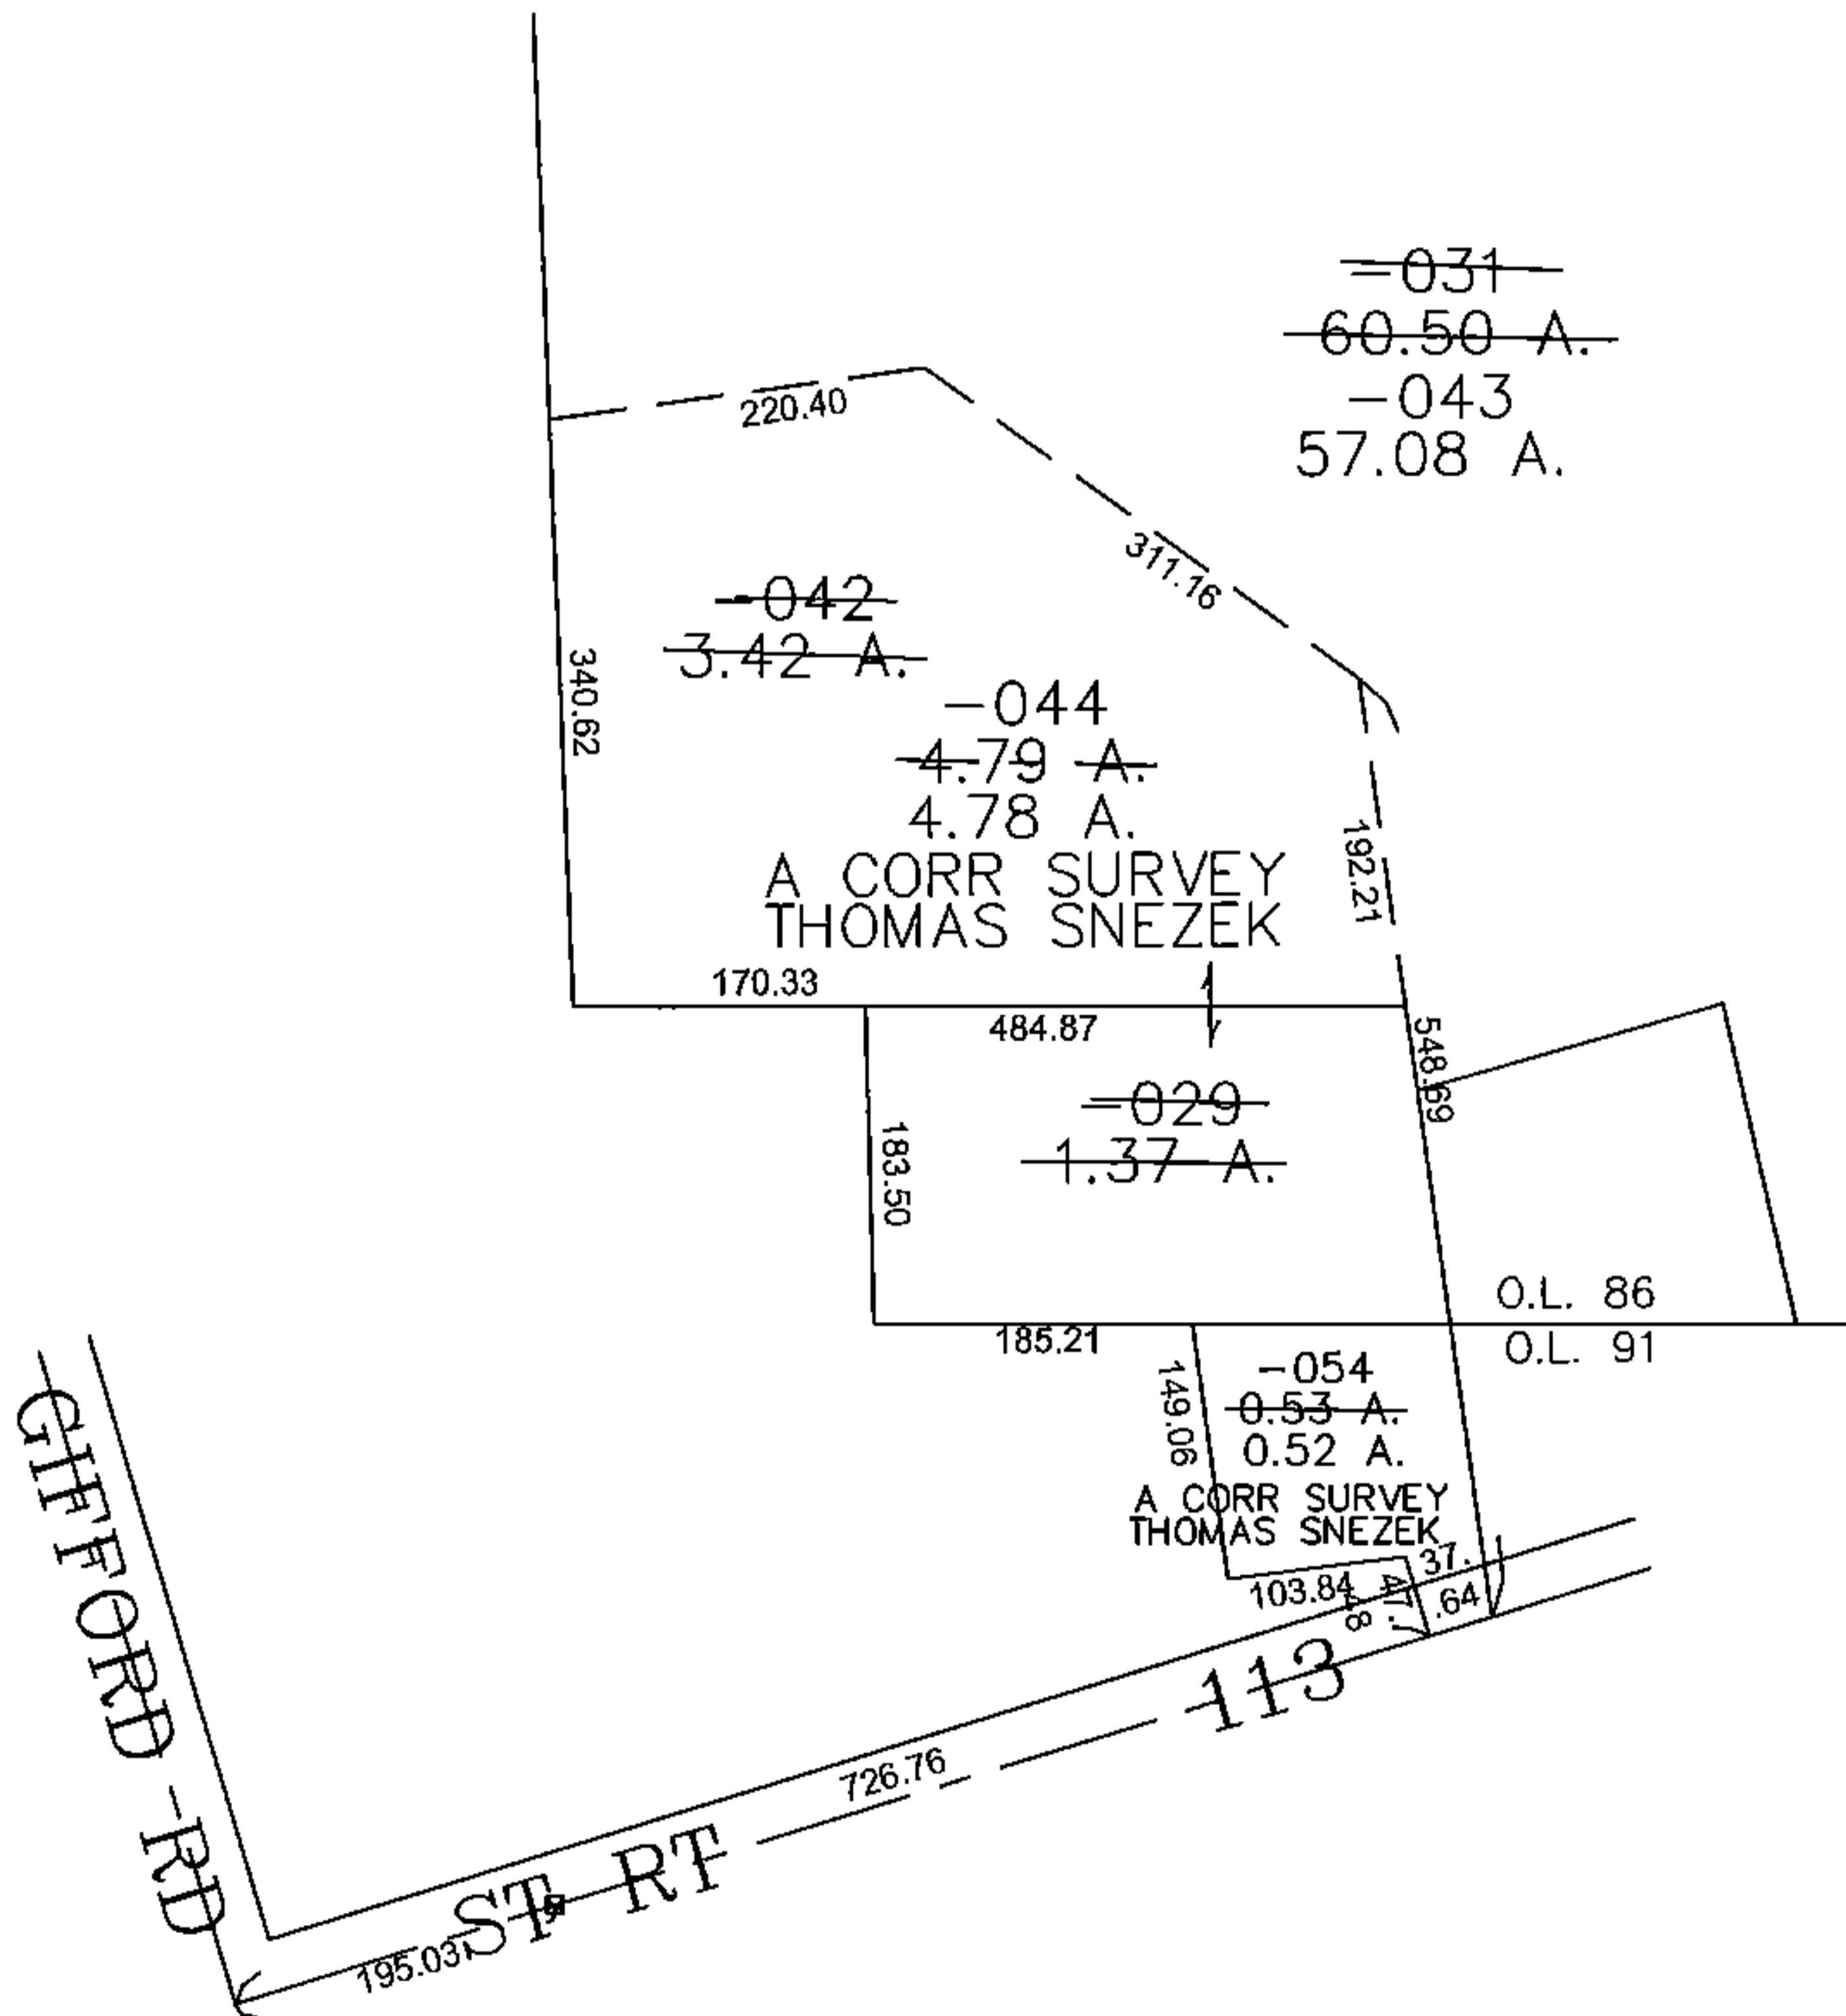


PARENT PARCEL: 08-00-086-000-031

CHILD PARCEL: 08-00-086-000-042 THRU -044

STARTING POINT: CENTERLINE OF ST RT 113 & GIFFORD RD

15-03425

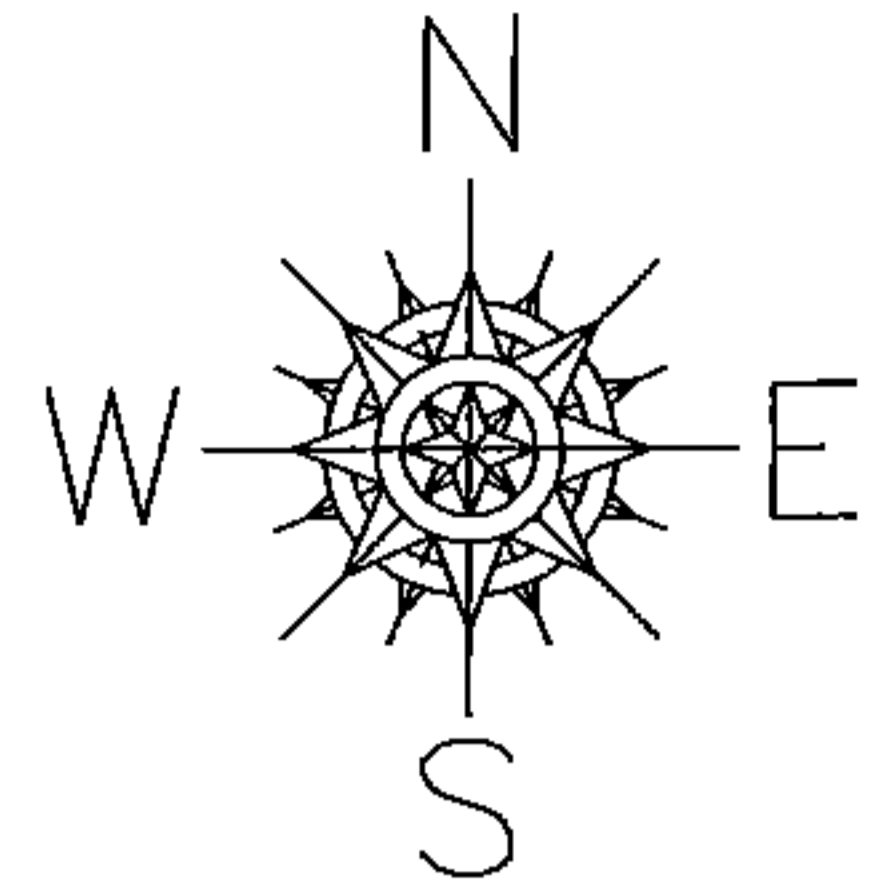

SPLITS/DEEDS PROCESSED

LORAIN COUNTY TAX MAP DEPARTMENT
226 MIDDLE AVE. ELYRIA, OHIO

SURVEYED BY: THOMAS SNEZEK

CLOSURE: 0.00 : 10.000

MAP PAGE(S): 08-00-086

APPROVED BY: JAH DATE: 9/17/2015

SCALE: 1" = 200. PRIOR INSTRUMENT: 20090301260