


PARENT PARCEL: 02-02-005-114-058

CHILD PARCEL: XX-XX-XXX-XXX-XXX

STARTING POINT: INTERSECTION OF C/L OF COOPER FOSTER PARK RD. AND C/L OF OBERLIN AVE.

16-03426-A

114

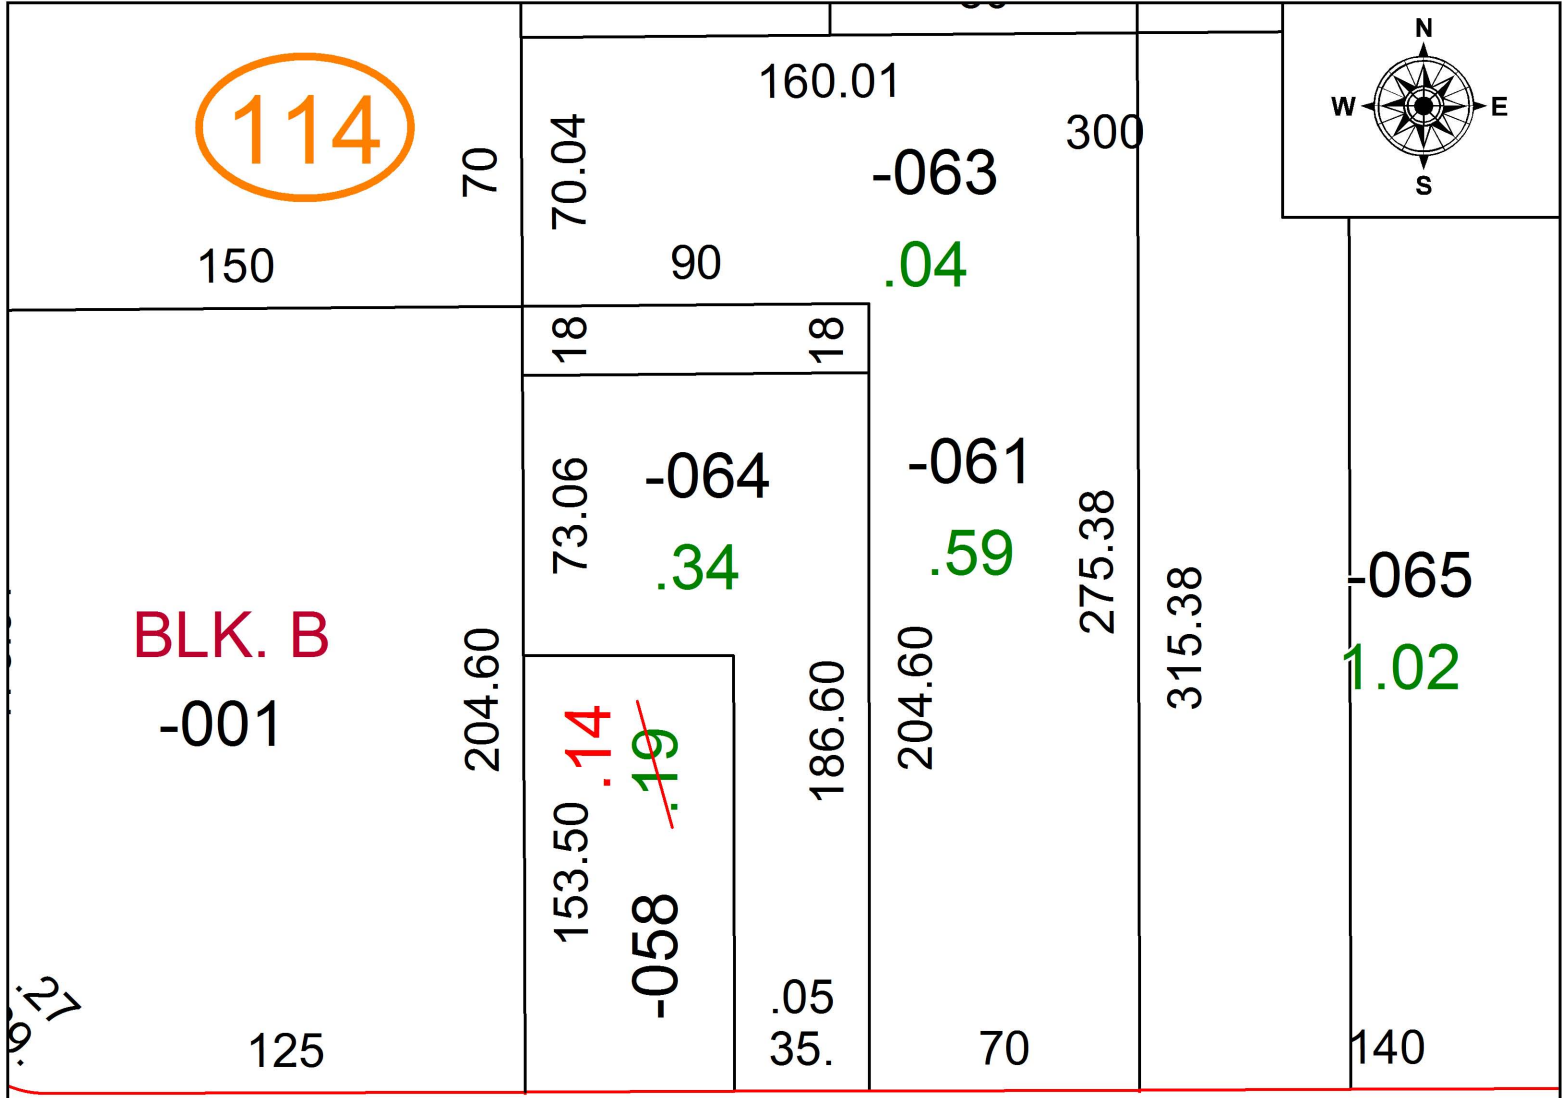


Line RD. Lorain

Corp. 306.24 307.90 -040

MHERST TWP

ACREAGE CORRECTION
0.14 A.
~~0.19 A.~~
AC. CORR. PER PRIOR DEEDS

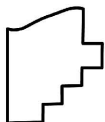

SPLITS/DEEDS PROCESSED
LORAIN COUNTY TAX MAP DEPARTMENT
226 MIDDLE AVE. ELYRIA, OH

SURVEYED BY: N/A
CLOSURE: N/A
MAP PAGE(S): 2-02-005-A
APPROVED BY: RRM DATE: 4-19-16
SCALE: 1" = 50' PRIOR INSTRUMENT: 20150566435