
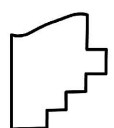
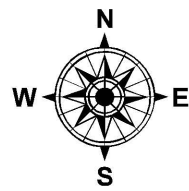


PARENT PARCEL: 21-04-000-000-046

CHILD PARCEL: XX-XX-XXX-XXX-XXX

STARTING POINT: INTERSECTION OF C/L OF CLARK RD. AND NORTH LINE OF TRACT 4

16-03427-X

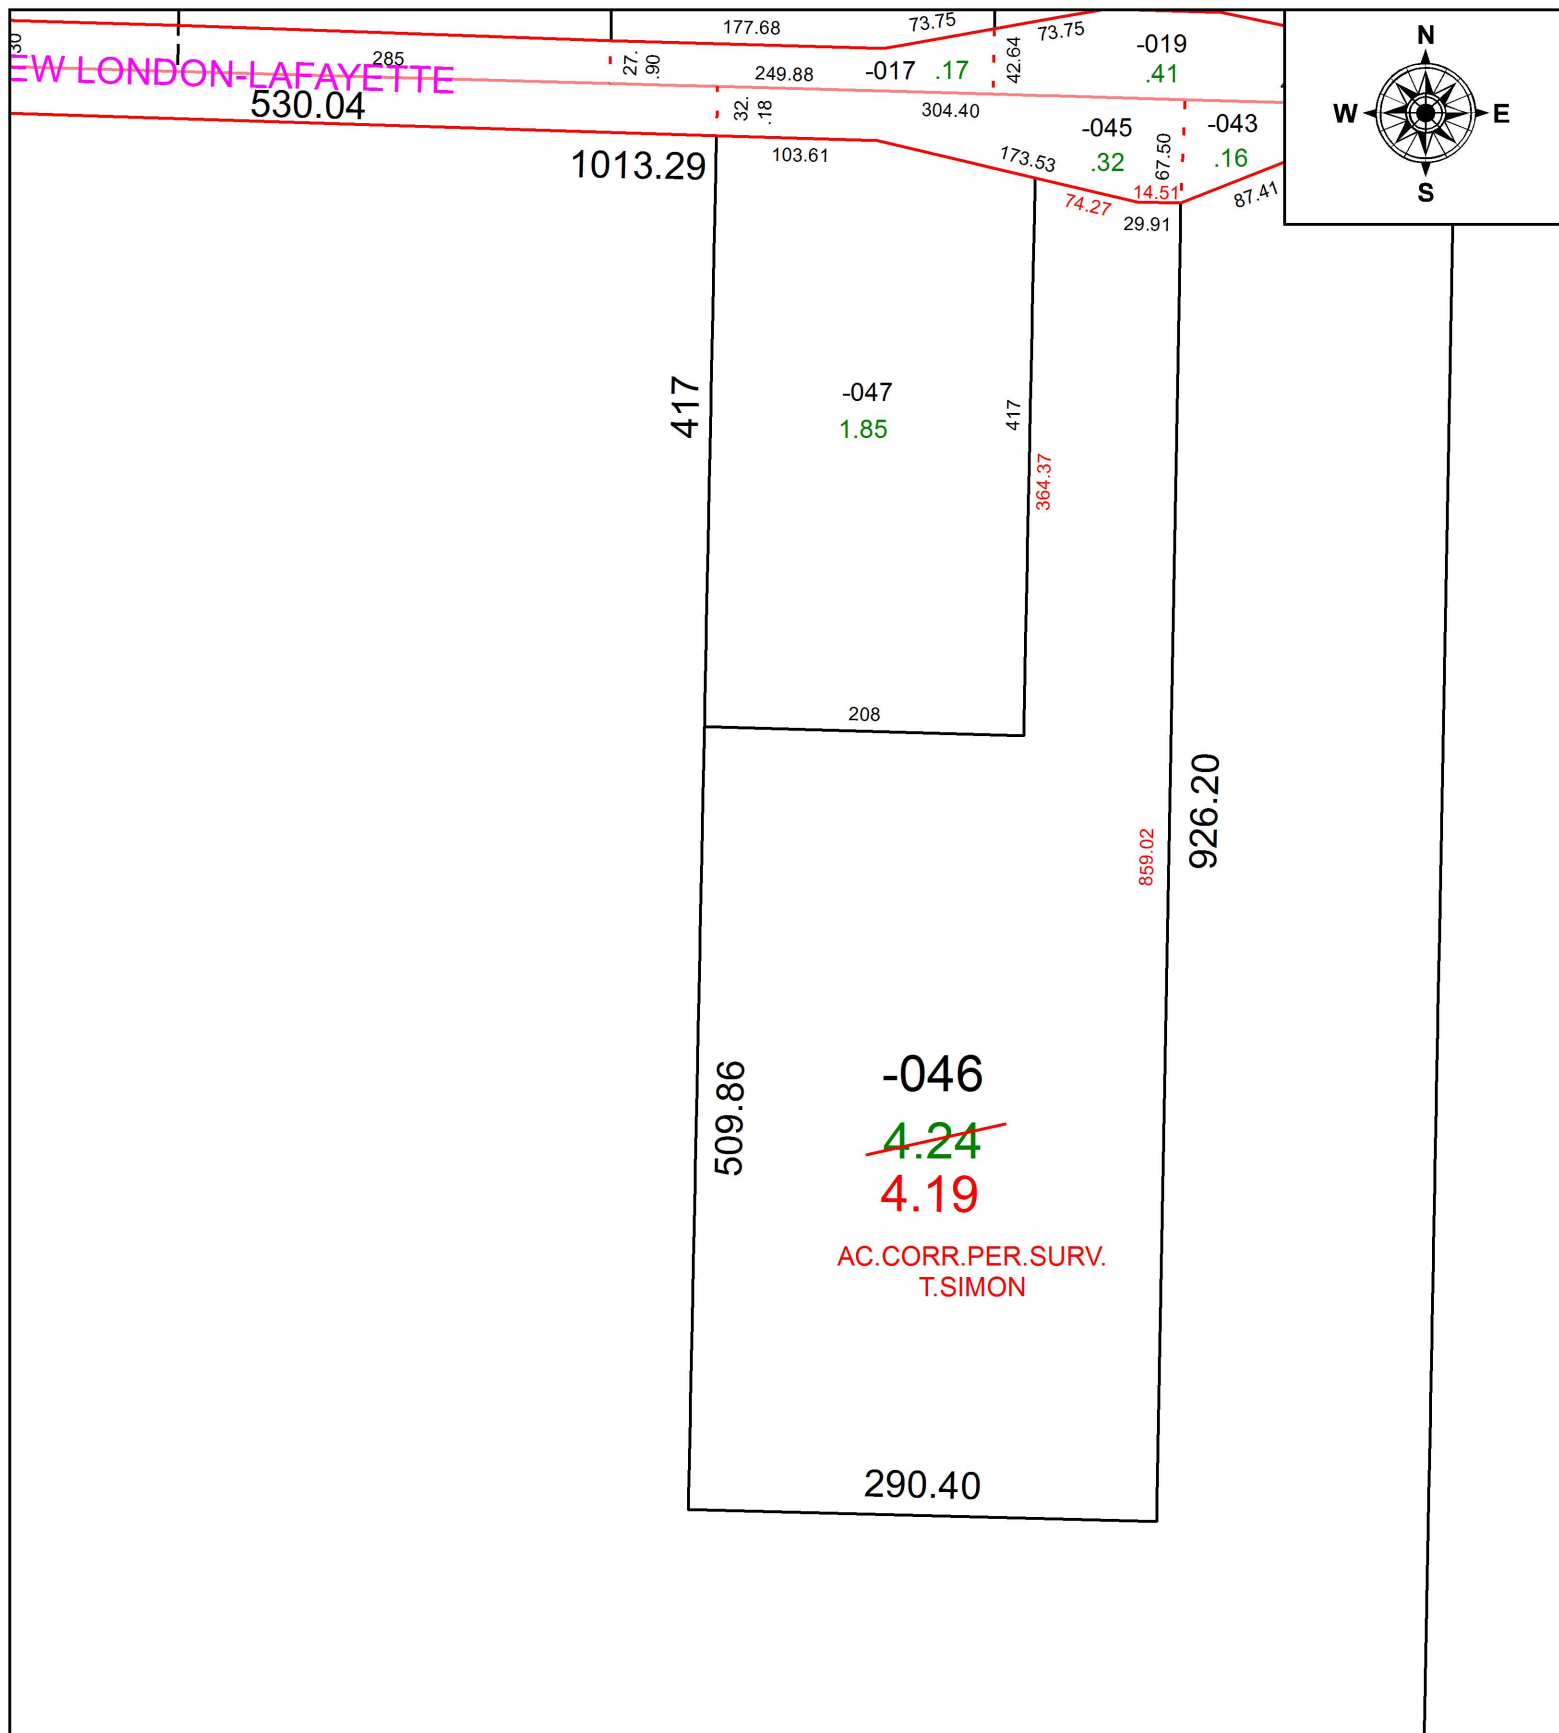

SPLITS/DEEDS PROCESSED
 LORAIN COUNTY TAX MAP DEPARTMENT
 226 MIDDLE AVE. ELYRIA, OH

SURVEYED BY: THOMAS A. SIMON
 CLOSURE: 1: 261,477
 MAP PAGE(S): 21-F
 APPROVED BY: RRM DATE: 4-21-16
 SCALE: 1" = 125 PRIOR INSTRUMENT: 20140508324