
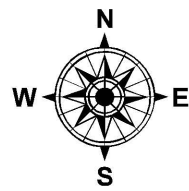


PARENT PARCEL: XX-XX-XXX-XXX-XXX

CHILD PARCEL: 05-00-023-900-001


STARTING POINT:

16-03428-X

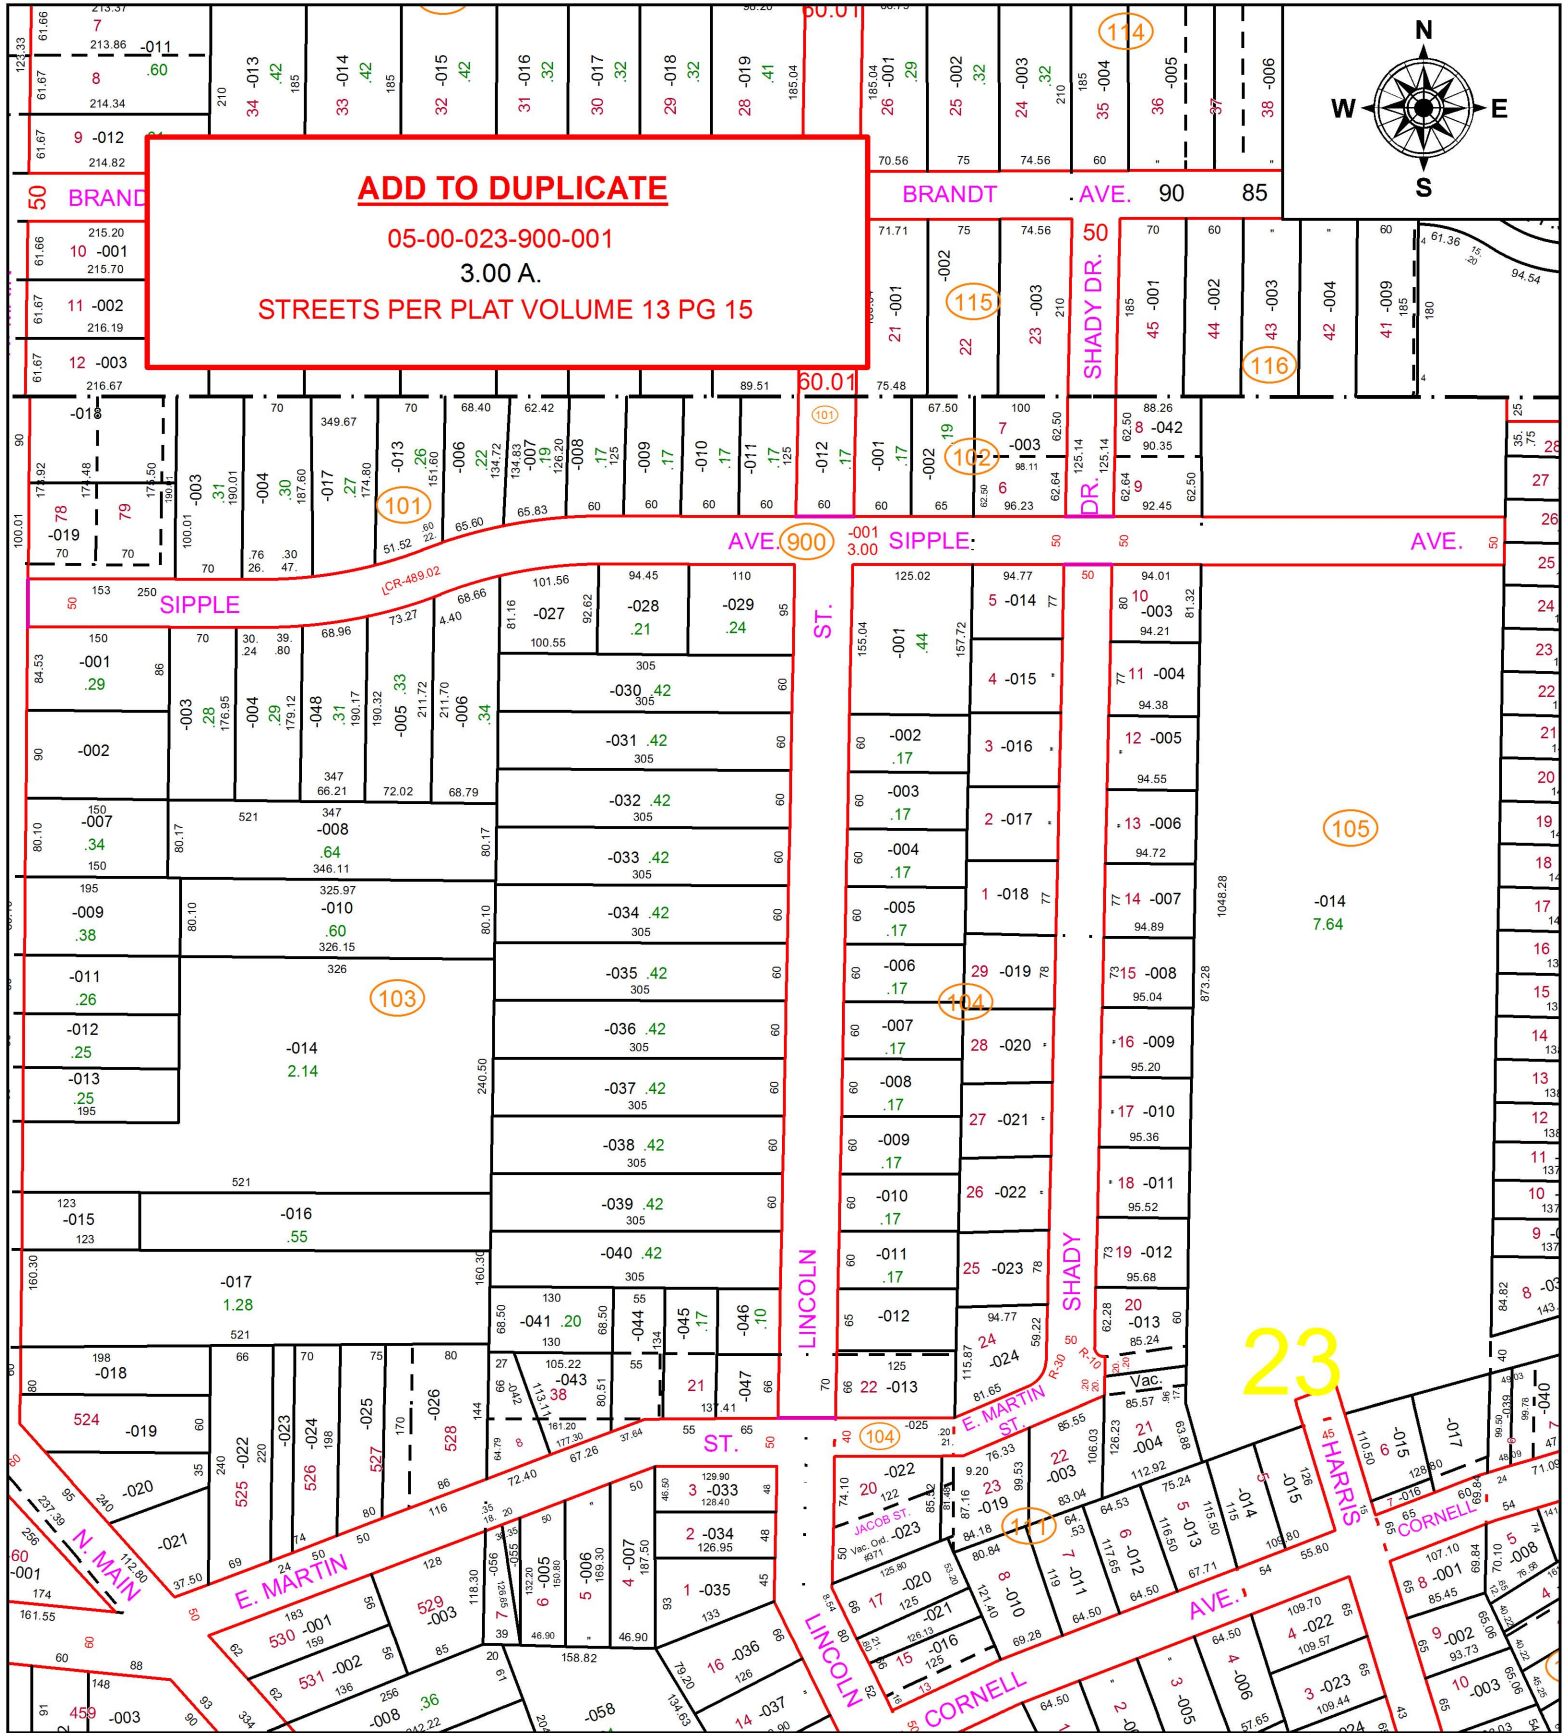

ADD TO DUPLICATE
05-00-023-900-001
3.00 A.
STREETS PER PLAT VOLUME 13 PG 15

23

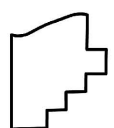

SPLITS/DEEDS PROCESSED
 LORAIN COUNTY TAX MAP DEPARTMENT
 226 MIDDLE AVE. ELYRIA, OH

SURVEYED BY: _____ N/A
 CLOSURE: _____ N/A
 MAP PAGE(S): 5-00-023-A & B
 APPROVED BY: RRM DATE: 4-19-16
 SCALE: 1" = 200 PRIOR INSTRUMENT: VOL.13 PG 15