
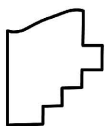


PARENT PARCEL: XX-XX-XXX-XXX-XXX

CHILD PARCEL: 05-00-023-900-002

STARTING POINT:

16-03429-X

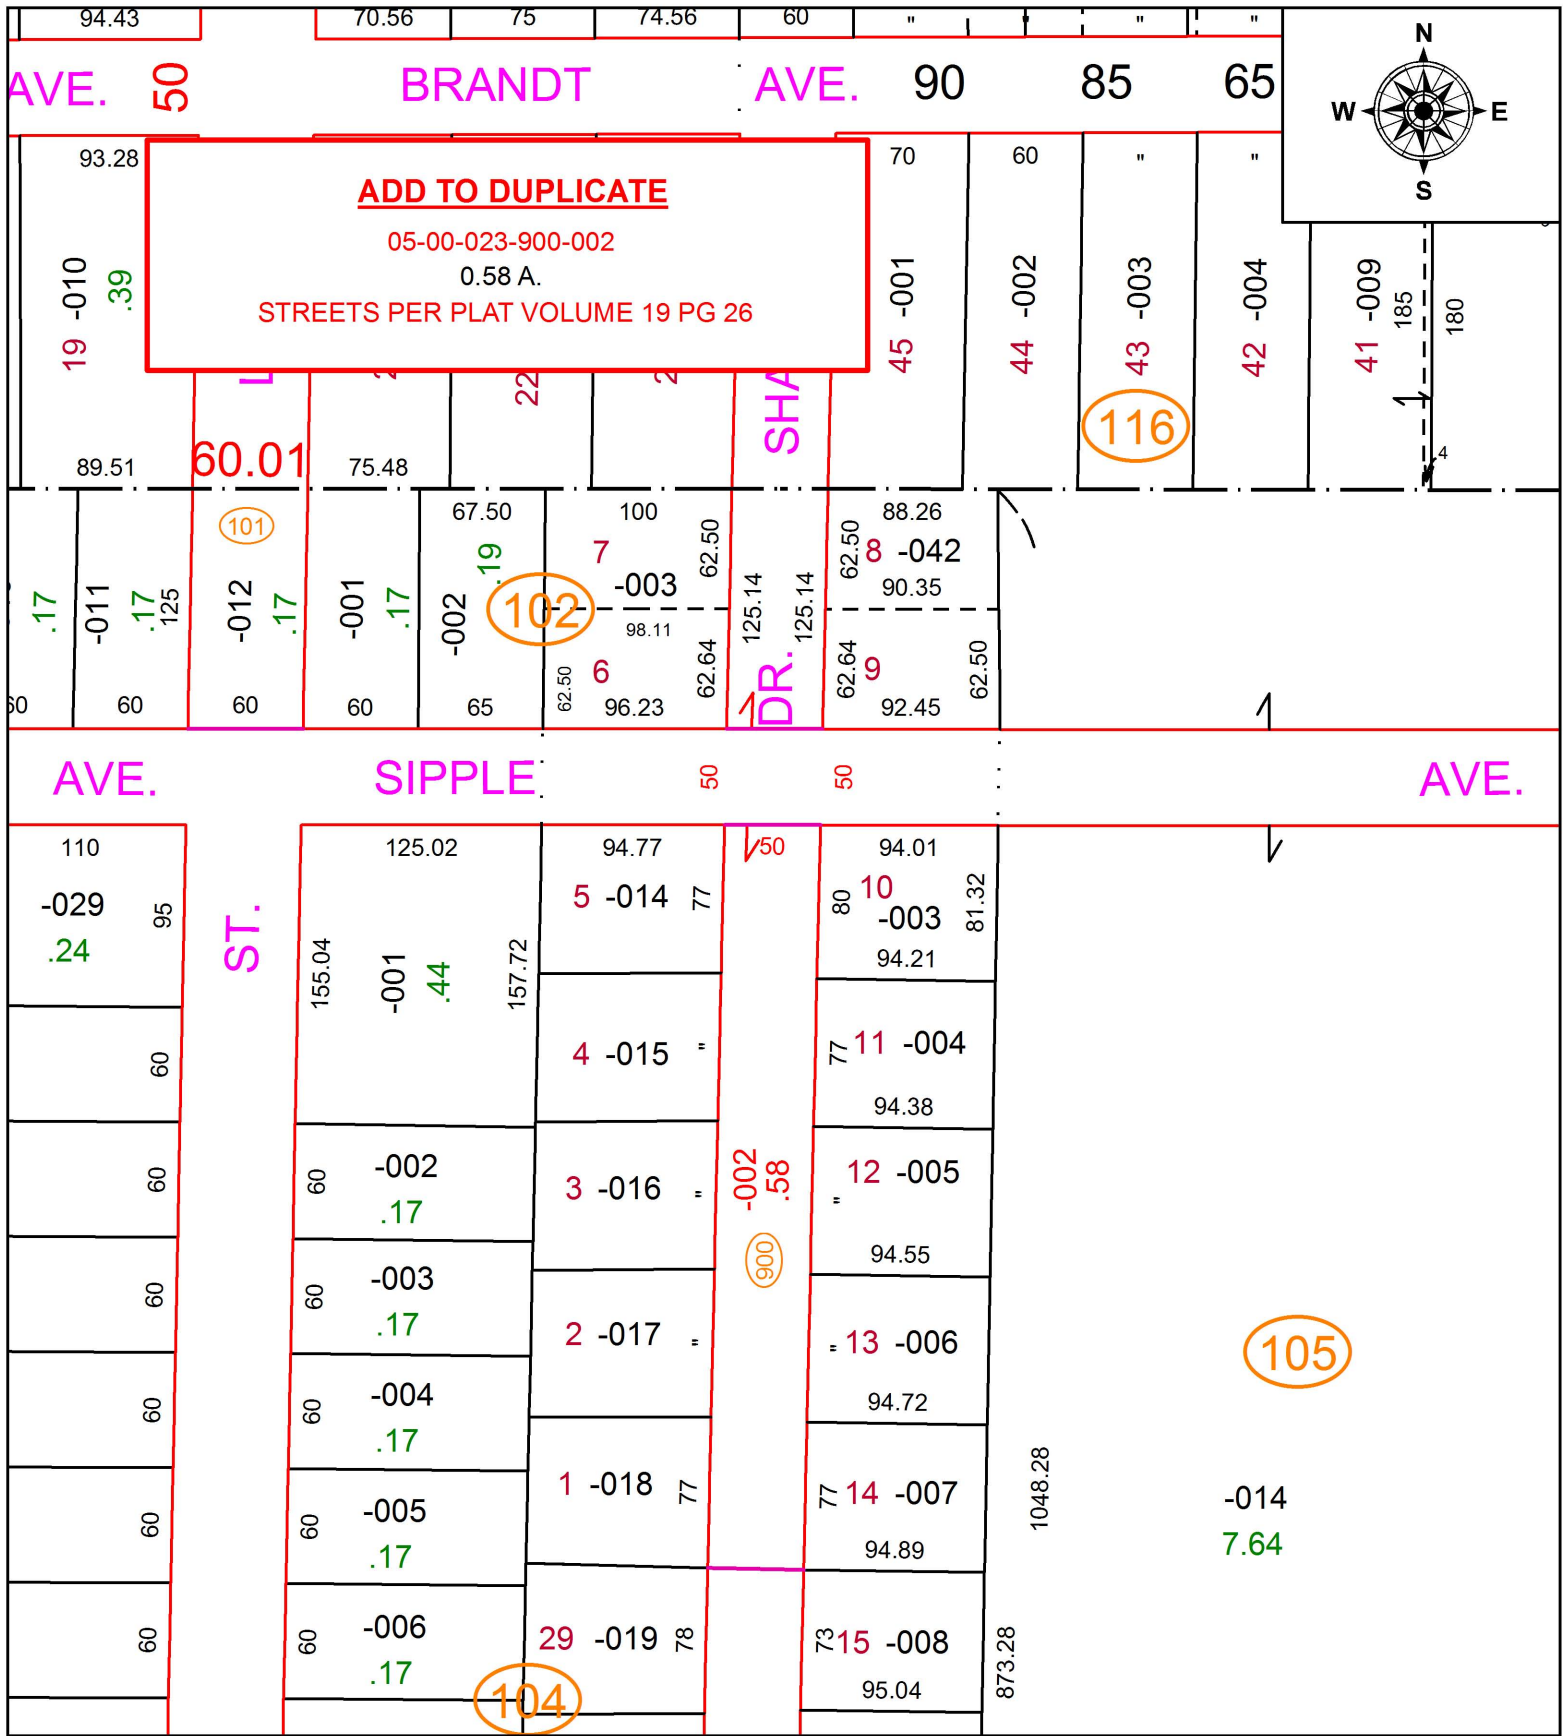

SPLITS/DEEDS PROCESSED
 LORAIN COUNTY TAX MAP DEPARTMENT
 226 MIDDLE AVE. ELYRIA, OH

SURVEYED BY: _____ N/A
 CLOSURE: _____ N/A
 MAP PAGE(S): _____ 5-00-023-B
 APPROVED BY: _____ RRM DATE: _____ 4-19-16
 SCALE: _____ 1" = 100 _____ PRIOR INSTRUMENT: _____ VOL.19 PG 26