
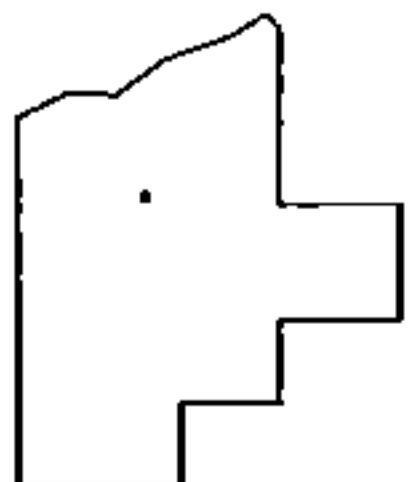
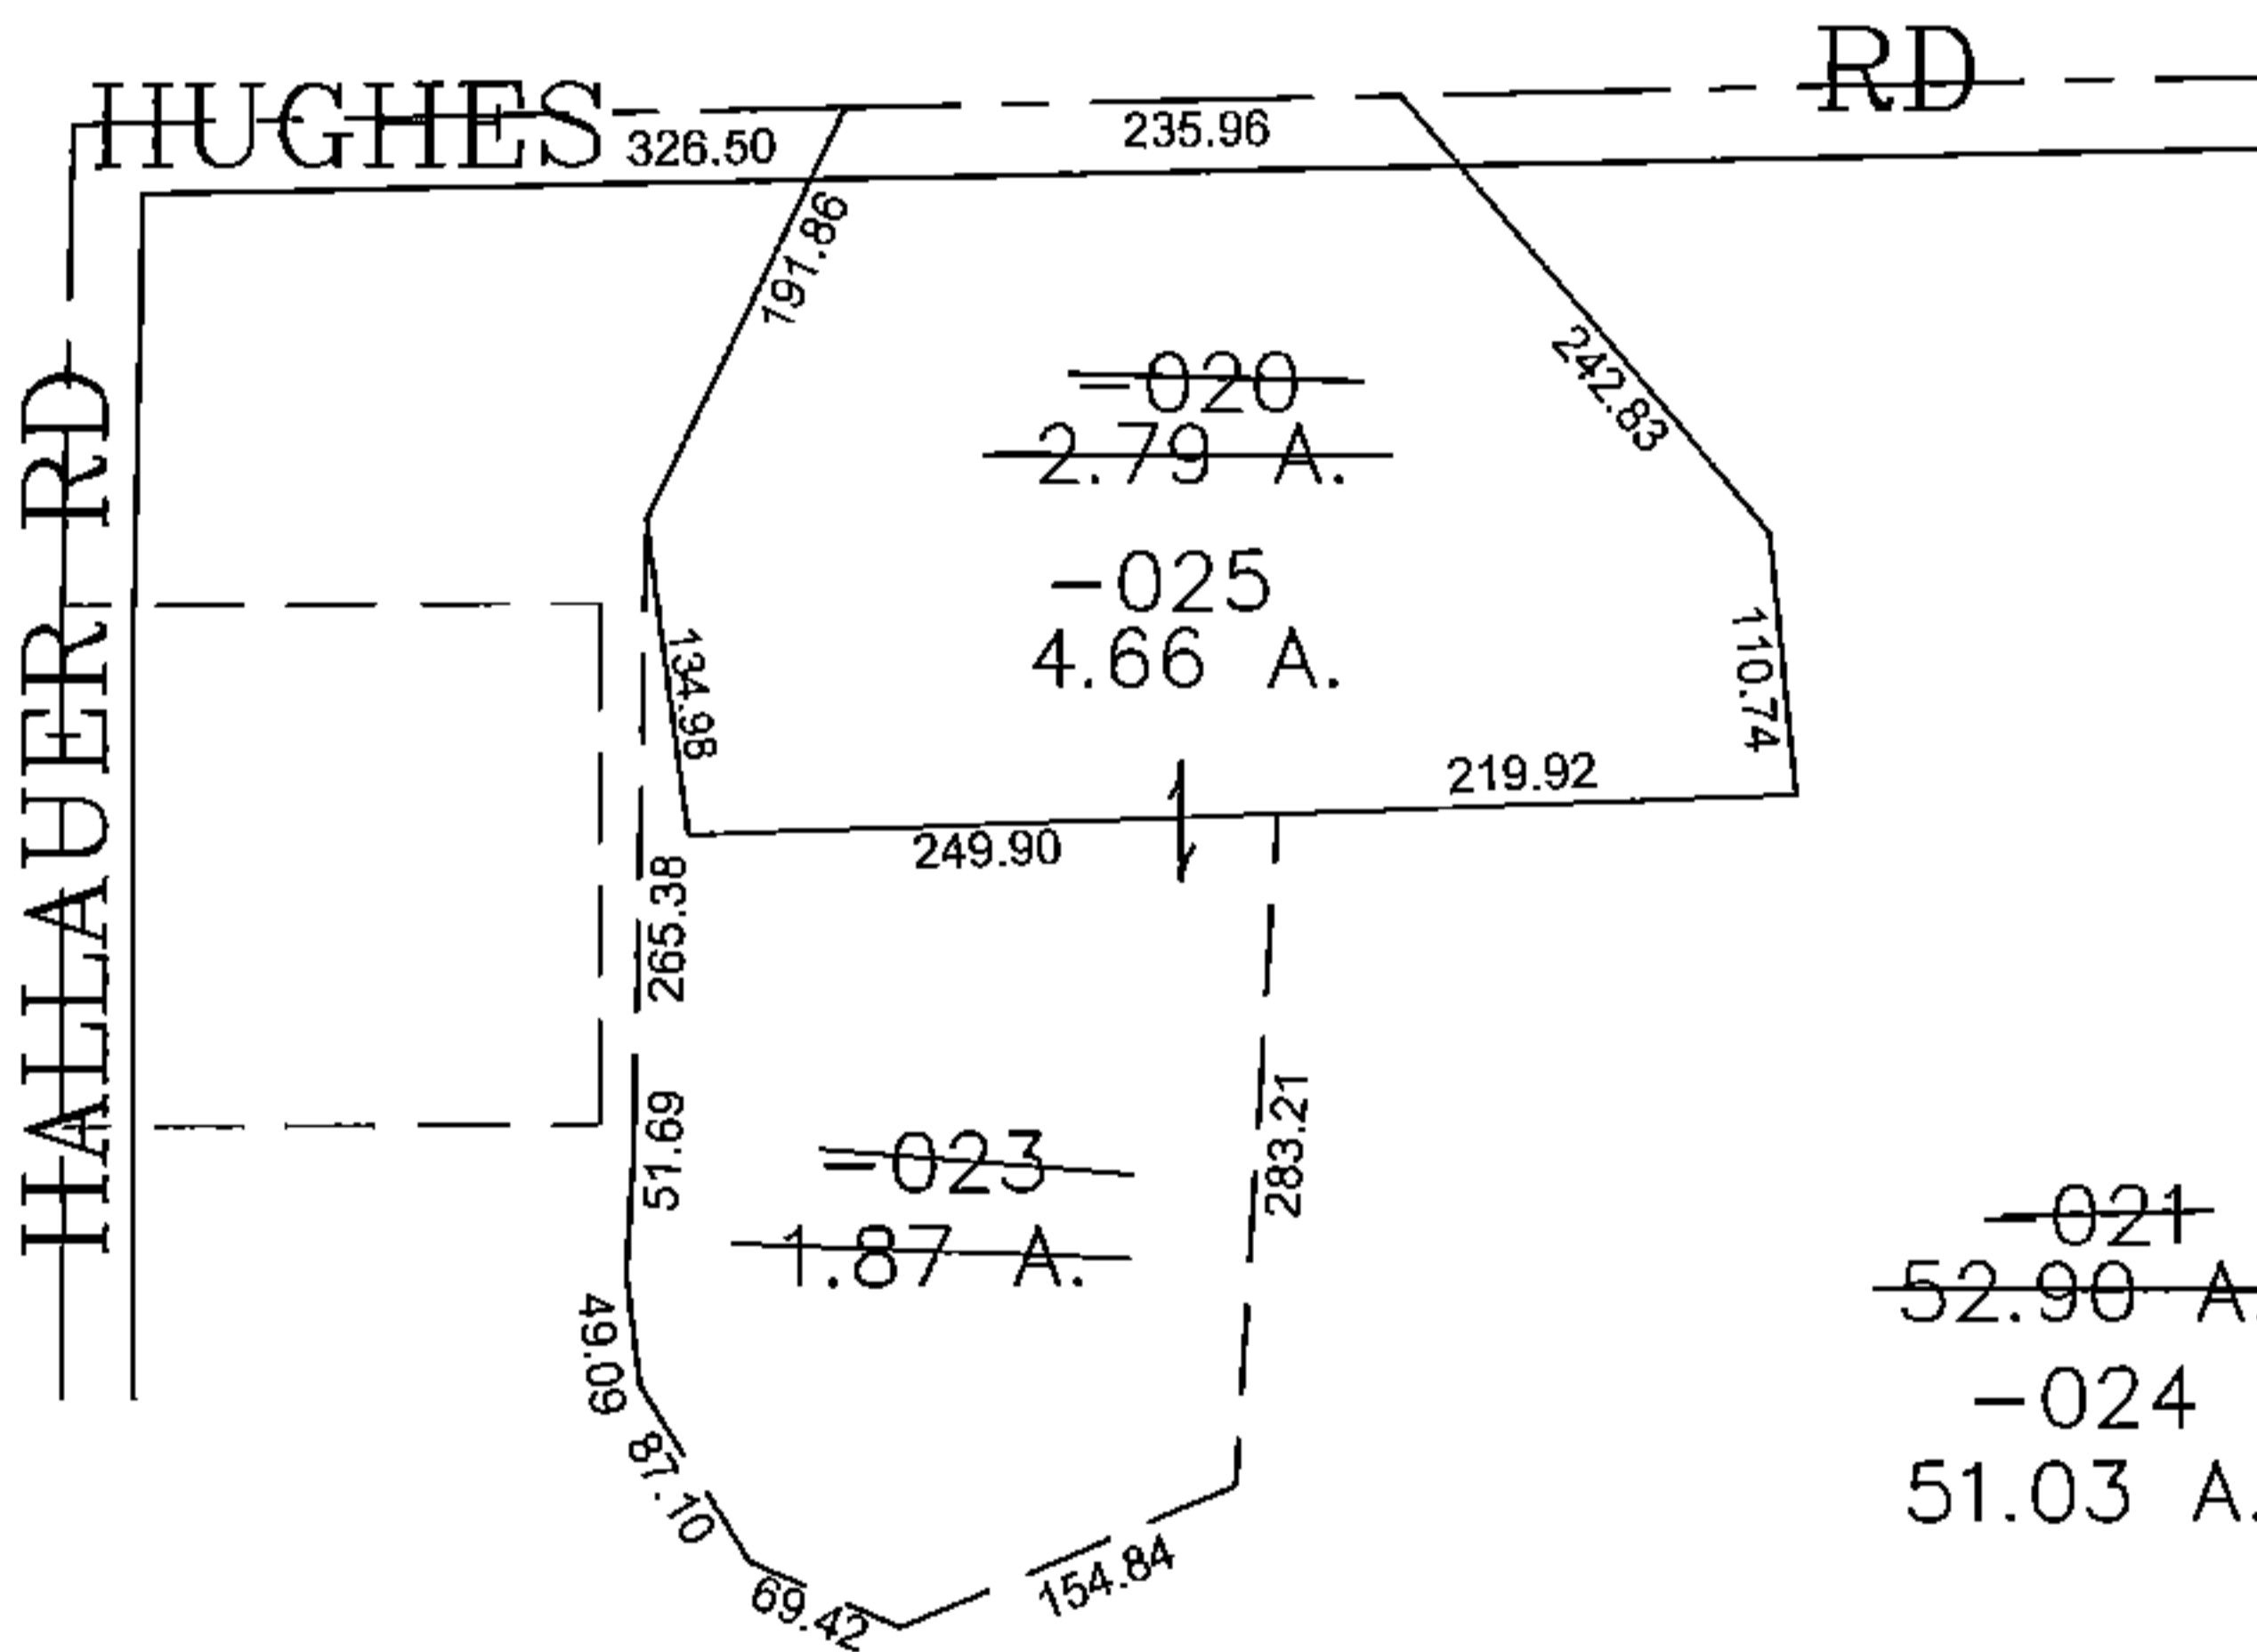


PARENT PARCEL: 14-00-057-000-021, -020  
CHILD PARCEL: 14-00-057-000-023, -024, -025  
STARTING POINT: CENTERLINE OF HALLAUER RD & HUGHES RD

15-03429

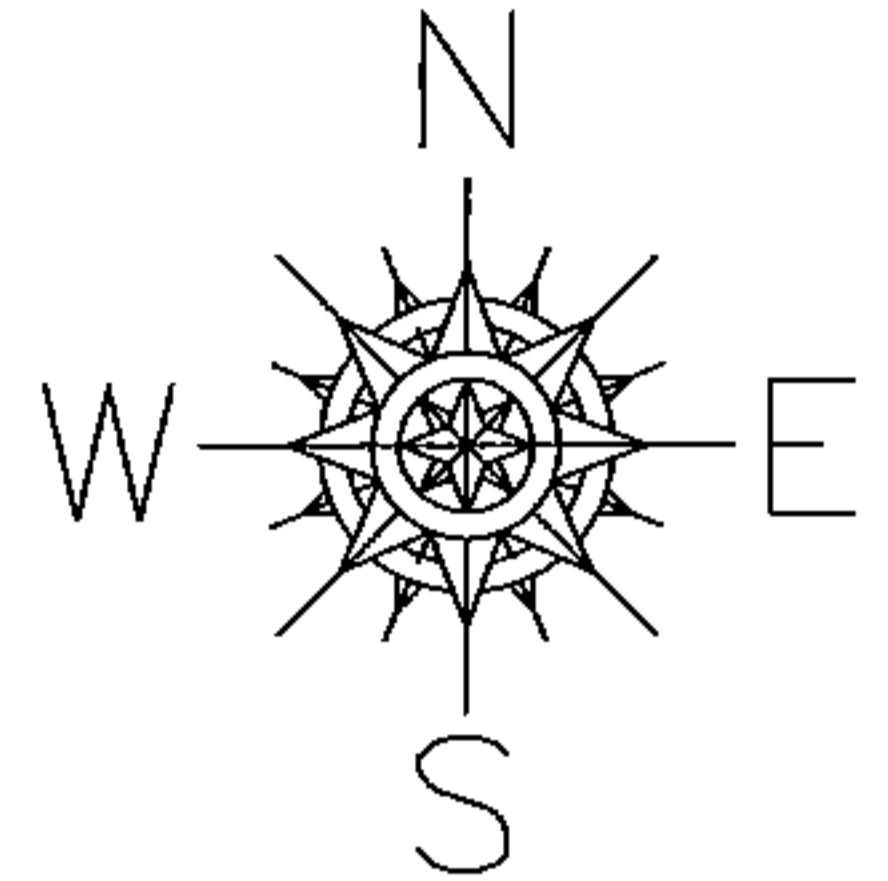

**SPLITS/DEEDS PROCESSED**  
LORAIN COUNTY TAX MAP DEPARTMENT  
226 MIDDLE AVE. ELYRIA, OHIO

SURVEYED BY: RICHARD REDRICKSON  
CLOSURE: 0.00 : 10.000  
MAP PAGE(S): 14-00-057  
APPROVED BY: JAH DATE: 09/28/2015  
SCALE: 1" = 200' PRIOR INSTRUMENT: 20130464762