
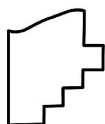
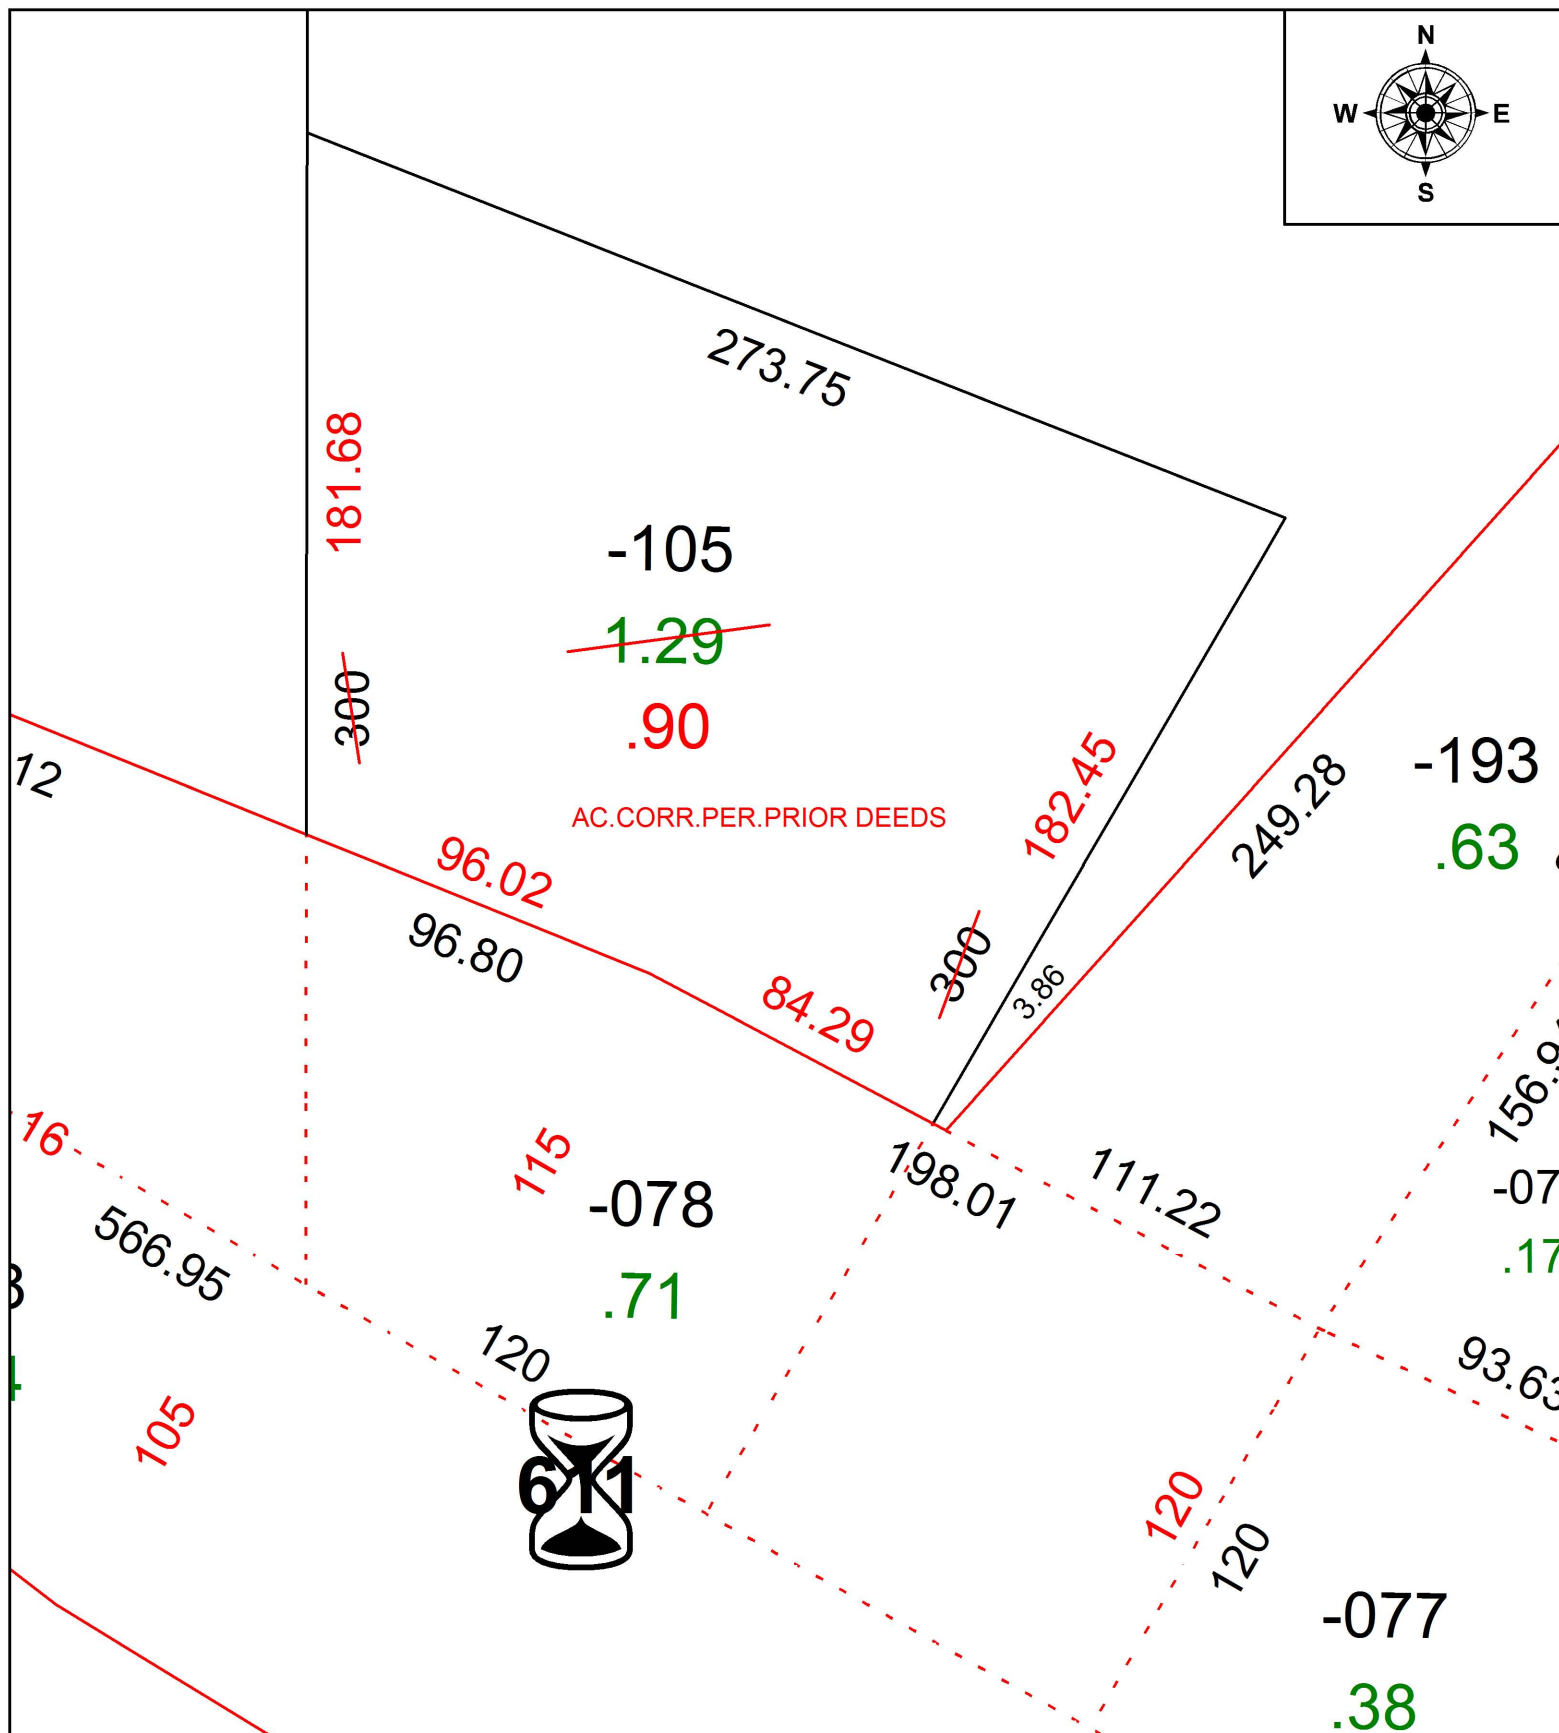


PARENT PARCEL: 04-00-004-102-105

CHILD PARCEL: XX-XX-XXX-XXX-XXX

STARTING POINT: NORTHWEST CORNER OF 106-WD (VOL. 938 PG.475)

16-03430-A

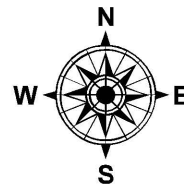

**SPLITS/DEEDS PROCESSED**  
 LORAIN COUNTY TAX MAP DEPARTMENT  
 226 MIDDLE AVE. ELYRIA, OH

SURVEYED BY: \_\_\_\_\_ N/A  
 CLOSURE: \_\_\_\_\_ 1:130,367  
 MAP PAGE(S): \_\_\_\_\_ 4-00-004-F  
 APPROVED BY: \_\_\_\_\_ RRM DATE: \_\_\_\_\_ 4-21-16  
 SCALE: \_\_\_\_\_ 1" = 50 \_\_\_\_\_ PRIOR INSTRUMENT: \_\_\_\_\_ 20160582609